



APPENDIX B

Tier Three Project Borehole Logs

PROJECT: 08-1112-0021


LOCATION: N 4824026.4 ;E 555101.1

RECORD OF DRILLHOLE: MW08-T3-01

SHEET 1 OF 1

DATUM: Local

DRILLING DATE: 08/07/2008
DRILL RIG: Air Rotary
DRILLING CONTRACTOR: Gerrits Well Drilling

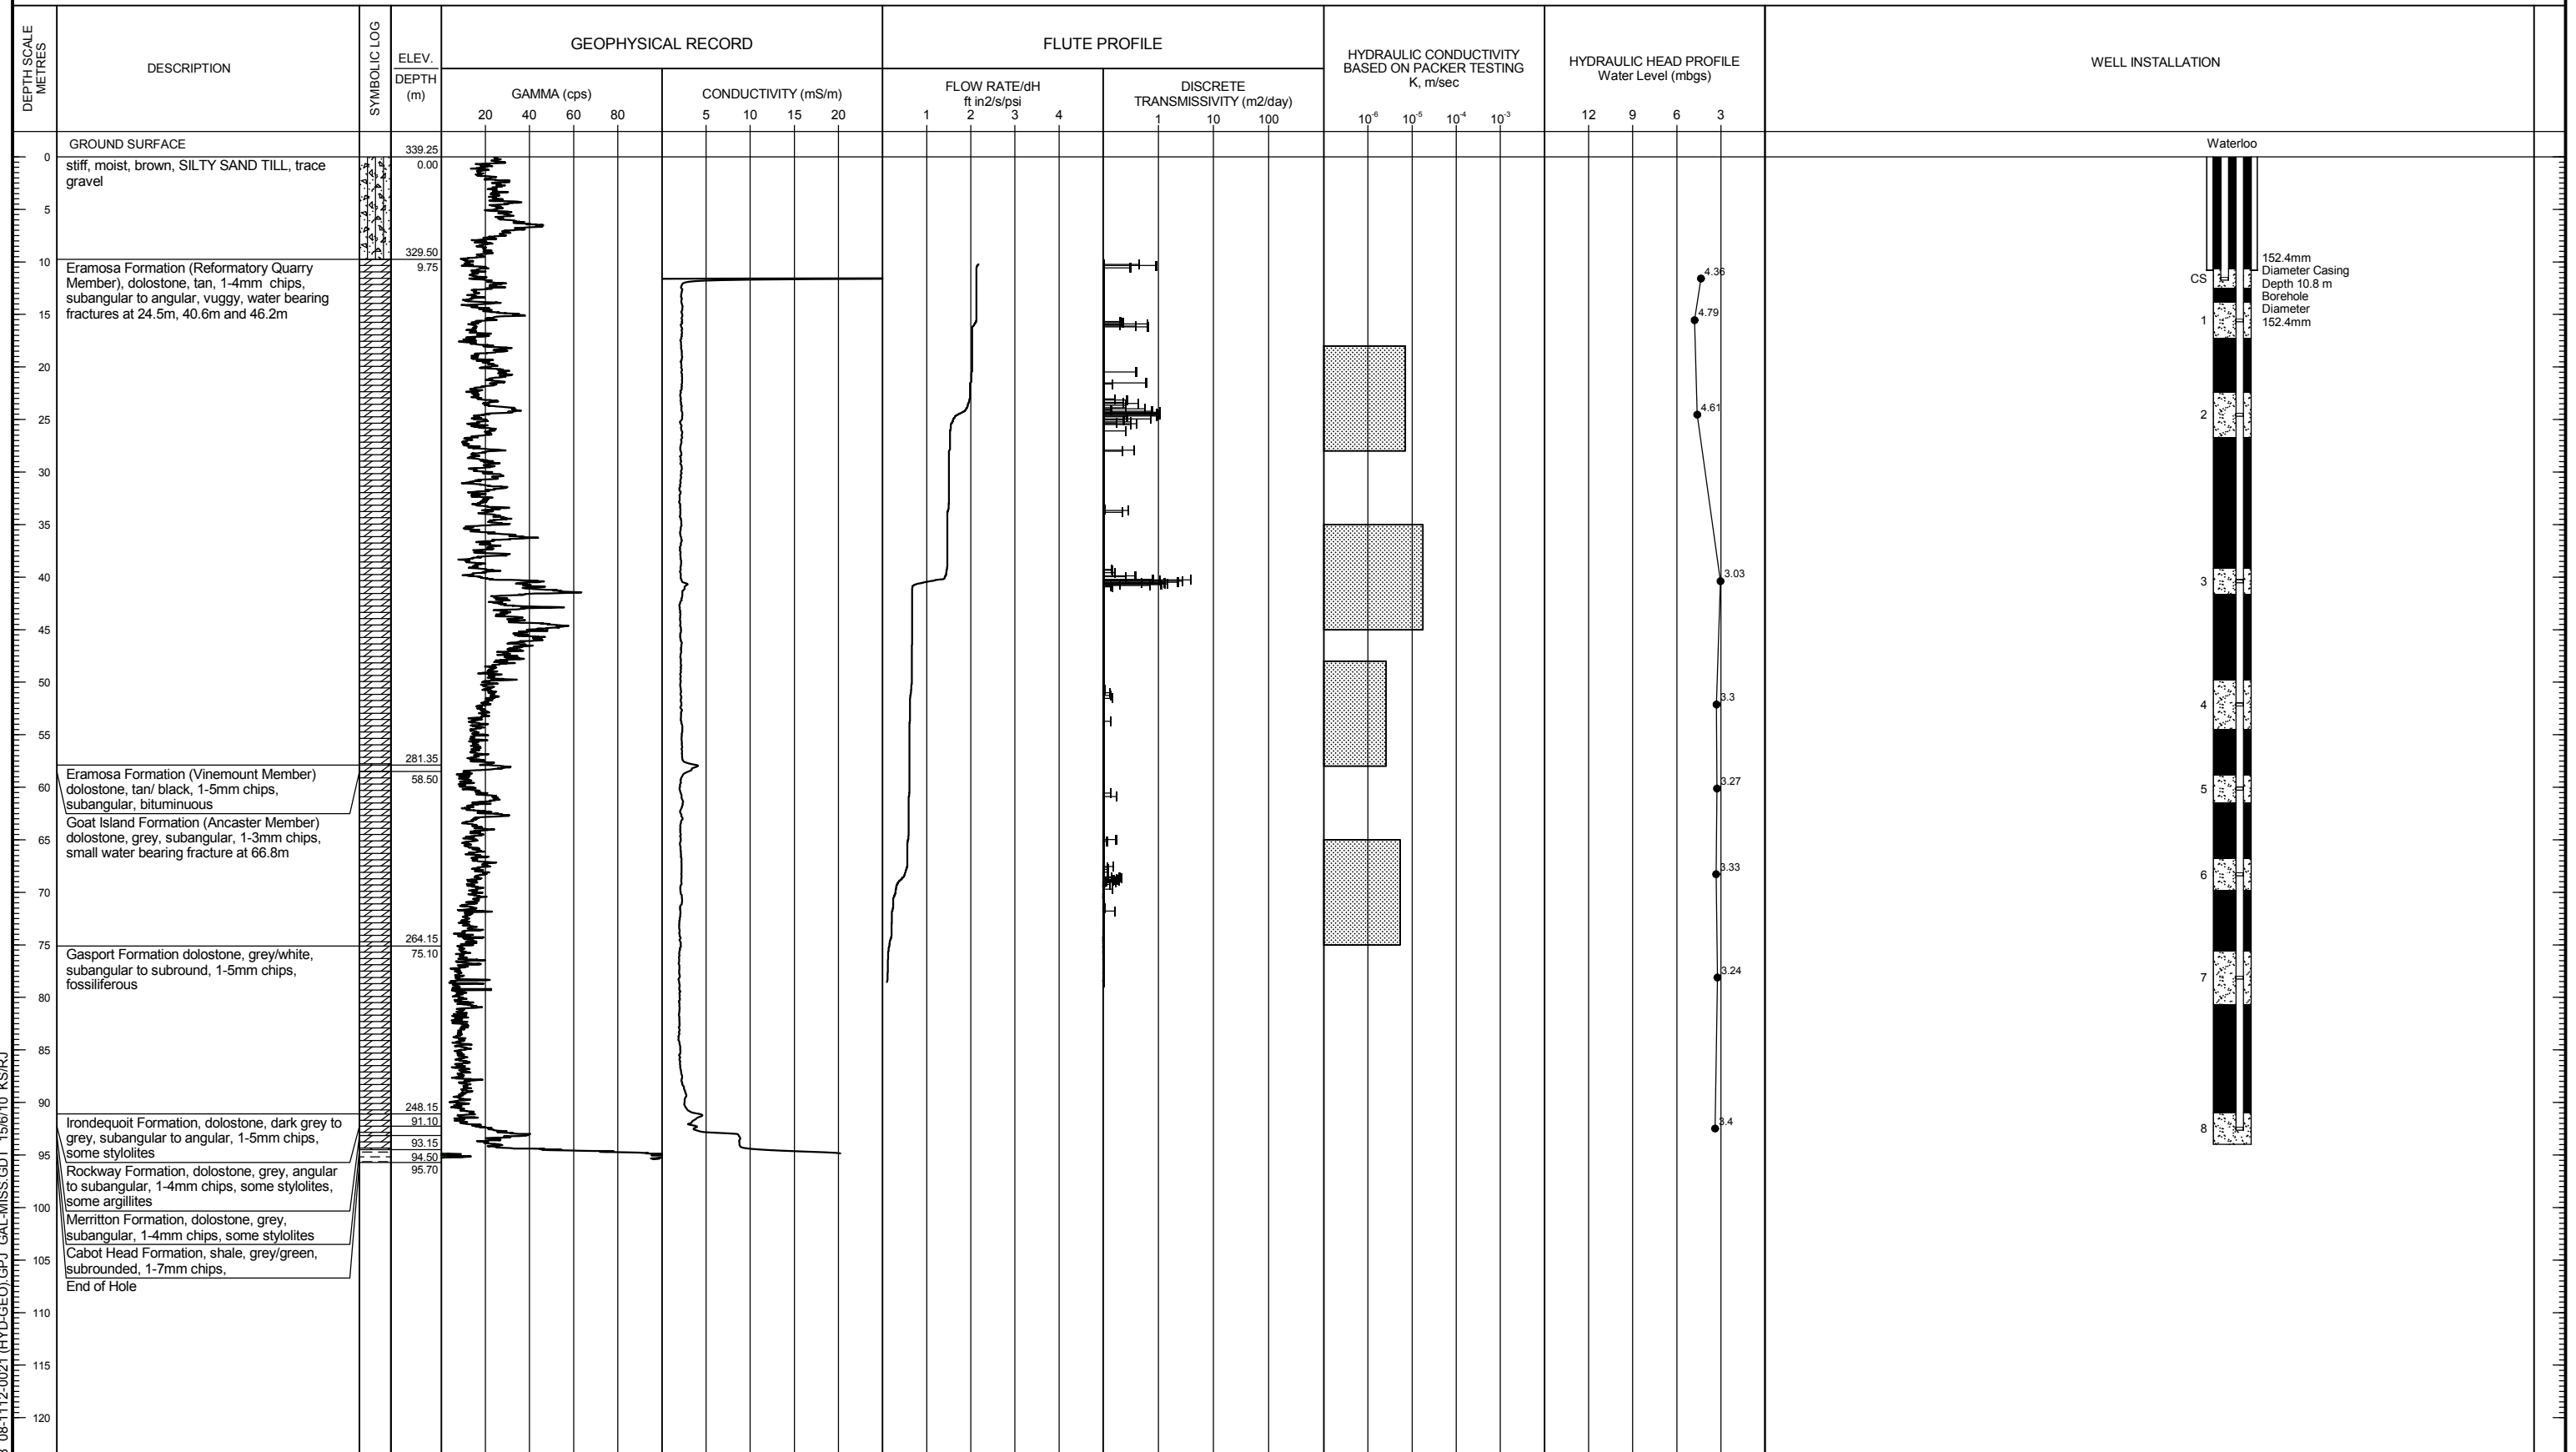

DEPTH SCALE
1 : 600

LOGGED: KS
CHECKED: JP

MIS-HYD 008 08-1112-0021 (HYD-GEO).GPJ GAL-MISS.GDT 15/6/10 KS/RJ

 
LOCATION: N 4830632.5 ;E 559361.5

DRILLING DATE: 09/09/2008
DRILL RIG: CME 75
DRILLING CONTRACTOR: Aardvark Drilling

DATUM: Local



1 : 600



LOCATION: N 4835572.2 ;E 563028.6

DRILLING DATE: 28/07/2008

DRILLING CONTRACTOR: Gerrits Well Drilling

DATUM: Local



1 : 600



HECKED: JP

PROJECT: 08-1112-0021


LOCATION: N 4836466.6 ;E 552653.9

RECORD OF DRILLHOLE: MW08-T3-04

SHEET 1 OF 2

DATUM: Local

DRILLING DATE: 06/08/2008
DRILL RIG: Air Rotary
DRILLING CONTRACTOR: Gerrits Well Drilling

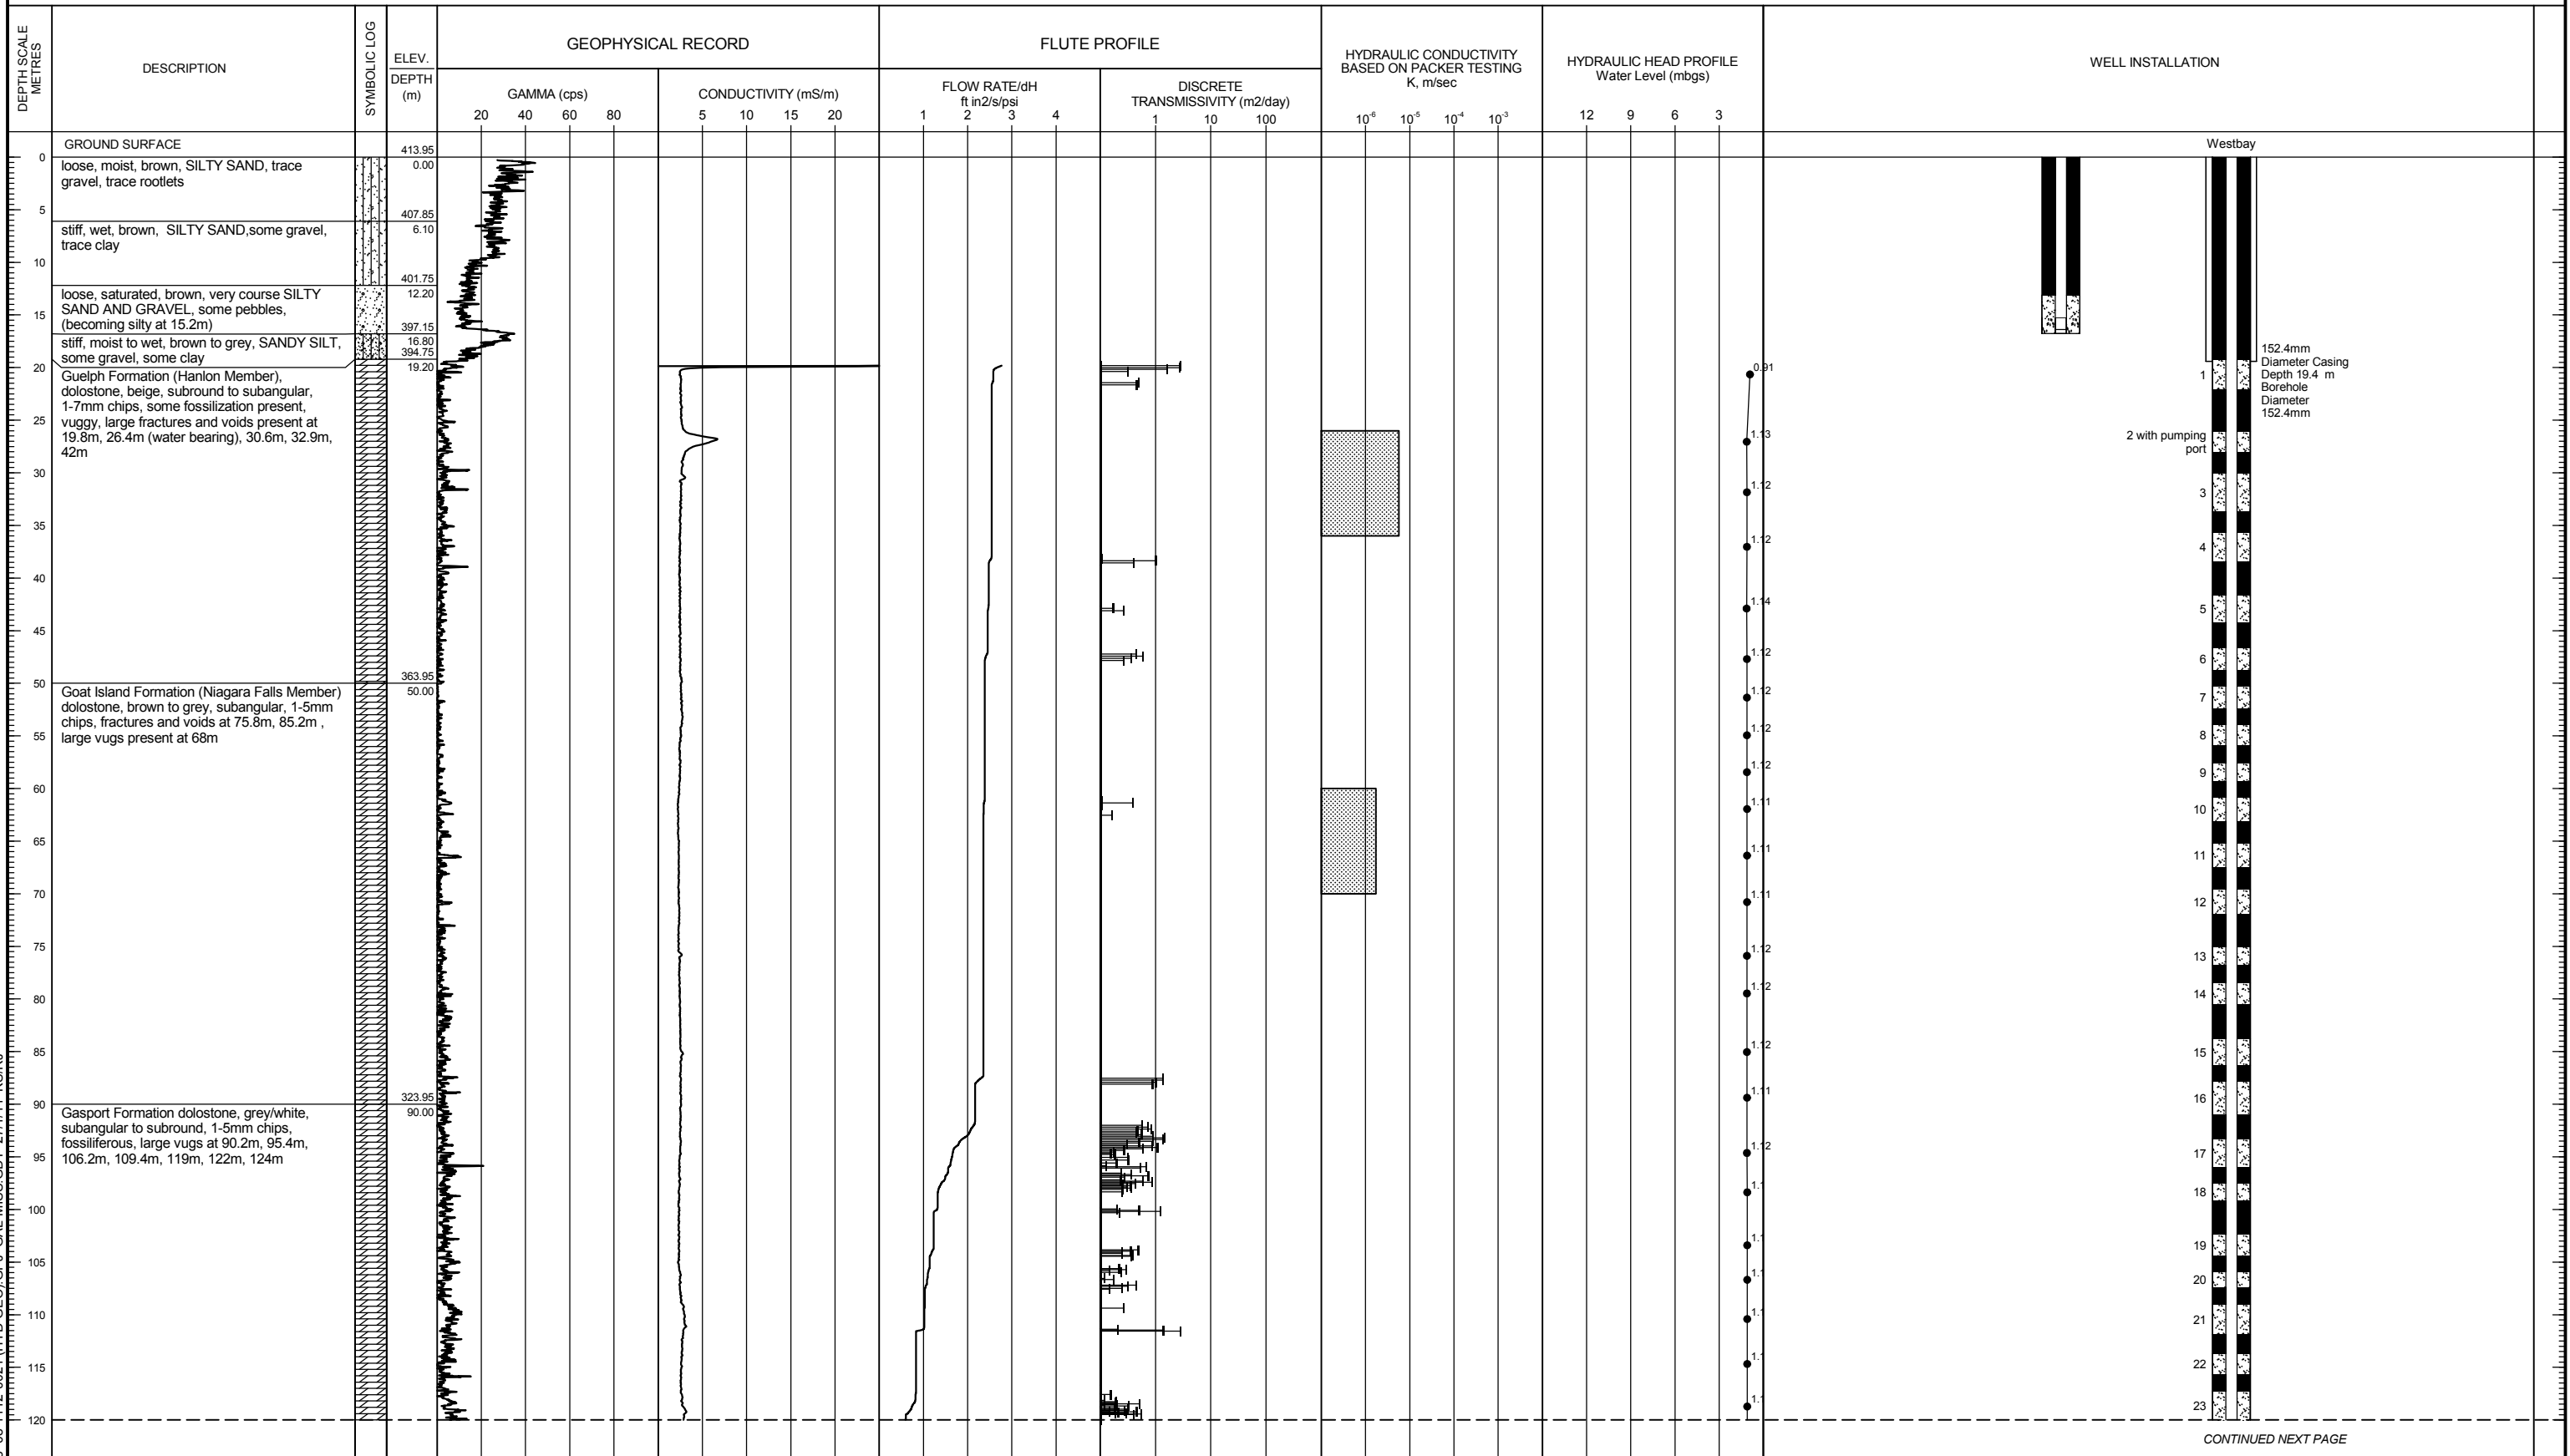

MIS-HYD 008 08-1112-0021 (HYD-GEO).GPJ GAL-MISS.GDT 27/1/11 KS/RJ

DEPTH SCALE
1 : 600



LOGGED: KS
CHECKED: JP

LOCATION: N 4836466.6 ;E 552653.9

RECORD OF DRILLHOLE: MW08-T3-04


DRILLING DATE: 06/08/2008

DRILL RIG: Air Rotary

DRILLING CONTRACTOR: Gerrits Well Drilling

SHEET 2 OF 2

DATUM: Local

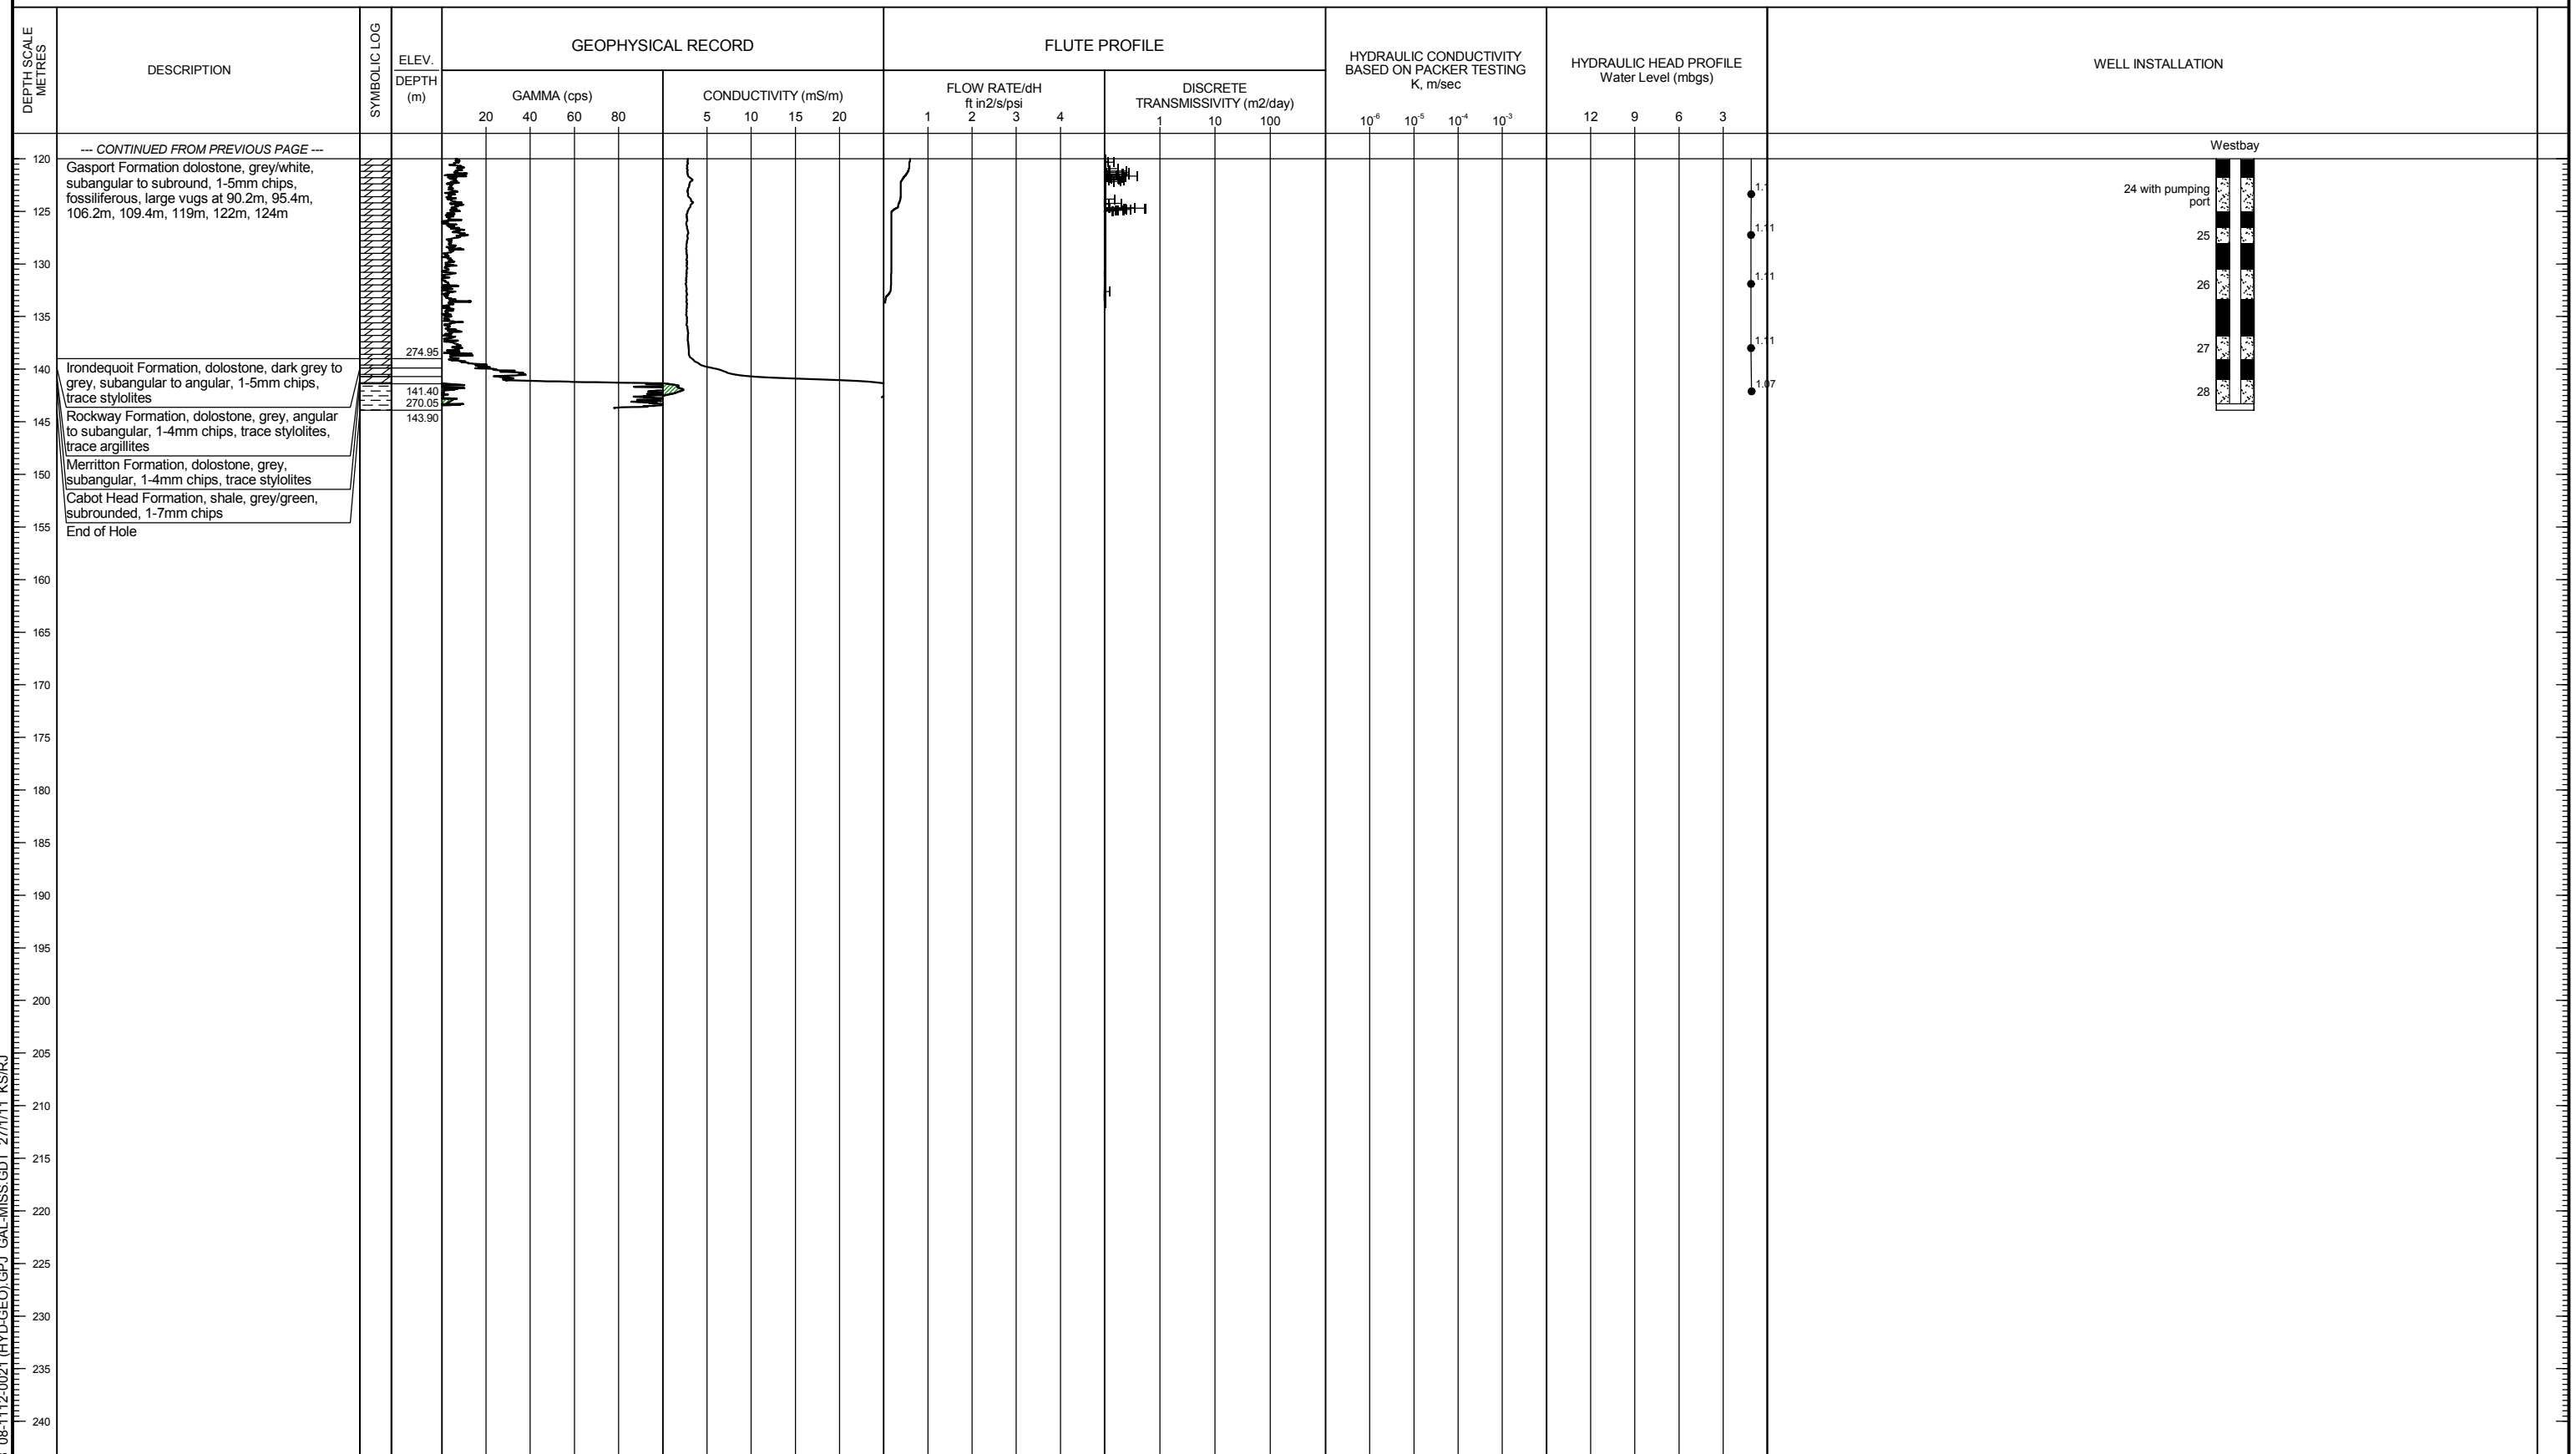

DEPTH SCALE

1 : 600



LOGGED: KS

 
CHECKED: JP

MIS-HYD 008 08-1112-0021 (HYD-GEO).GPJ GAL-MISS.GDT 27/1/11 KS/RJ

LOCATION: N 4845823.6 ;E 562220.3

DRILLING DATE: 15/09/2008
DRILL RIG: CME 75
DRILLING CONTRACTOR: Aardvark Drilling

DATUM: Local



1 : 600

HECKED: JP


LOCATION: N 4834617.4 ;E 568274.1

RECORD OF DRILLHOLE: MW08-T3-06

DRILLING CONTRACTOR: Aardvark Drilling

SHEET 1 OF 1

DATUM: Local

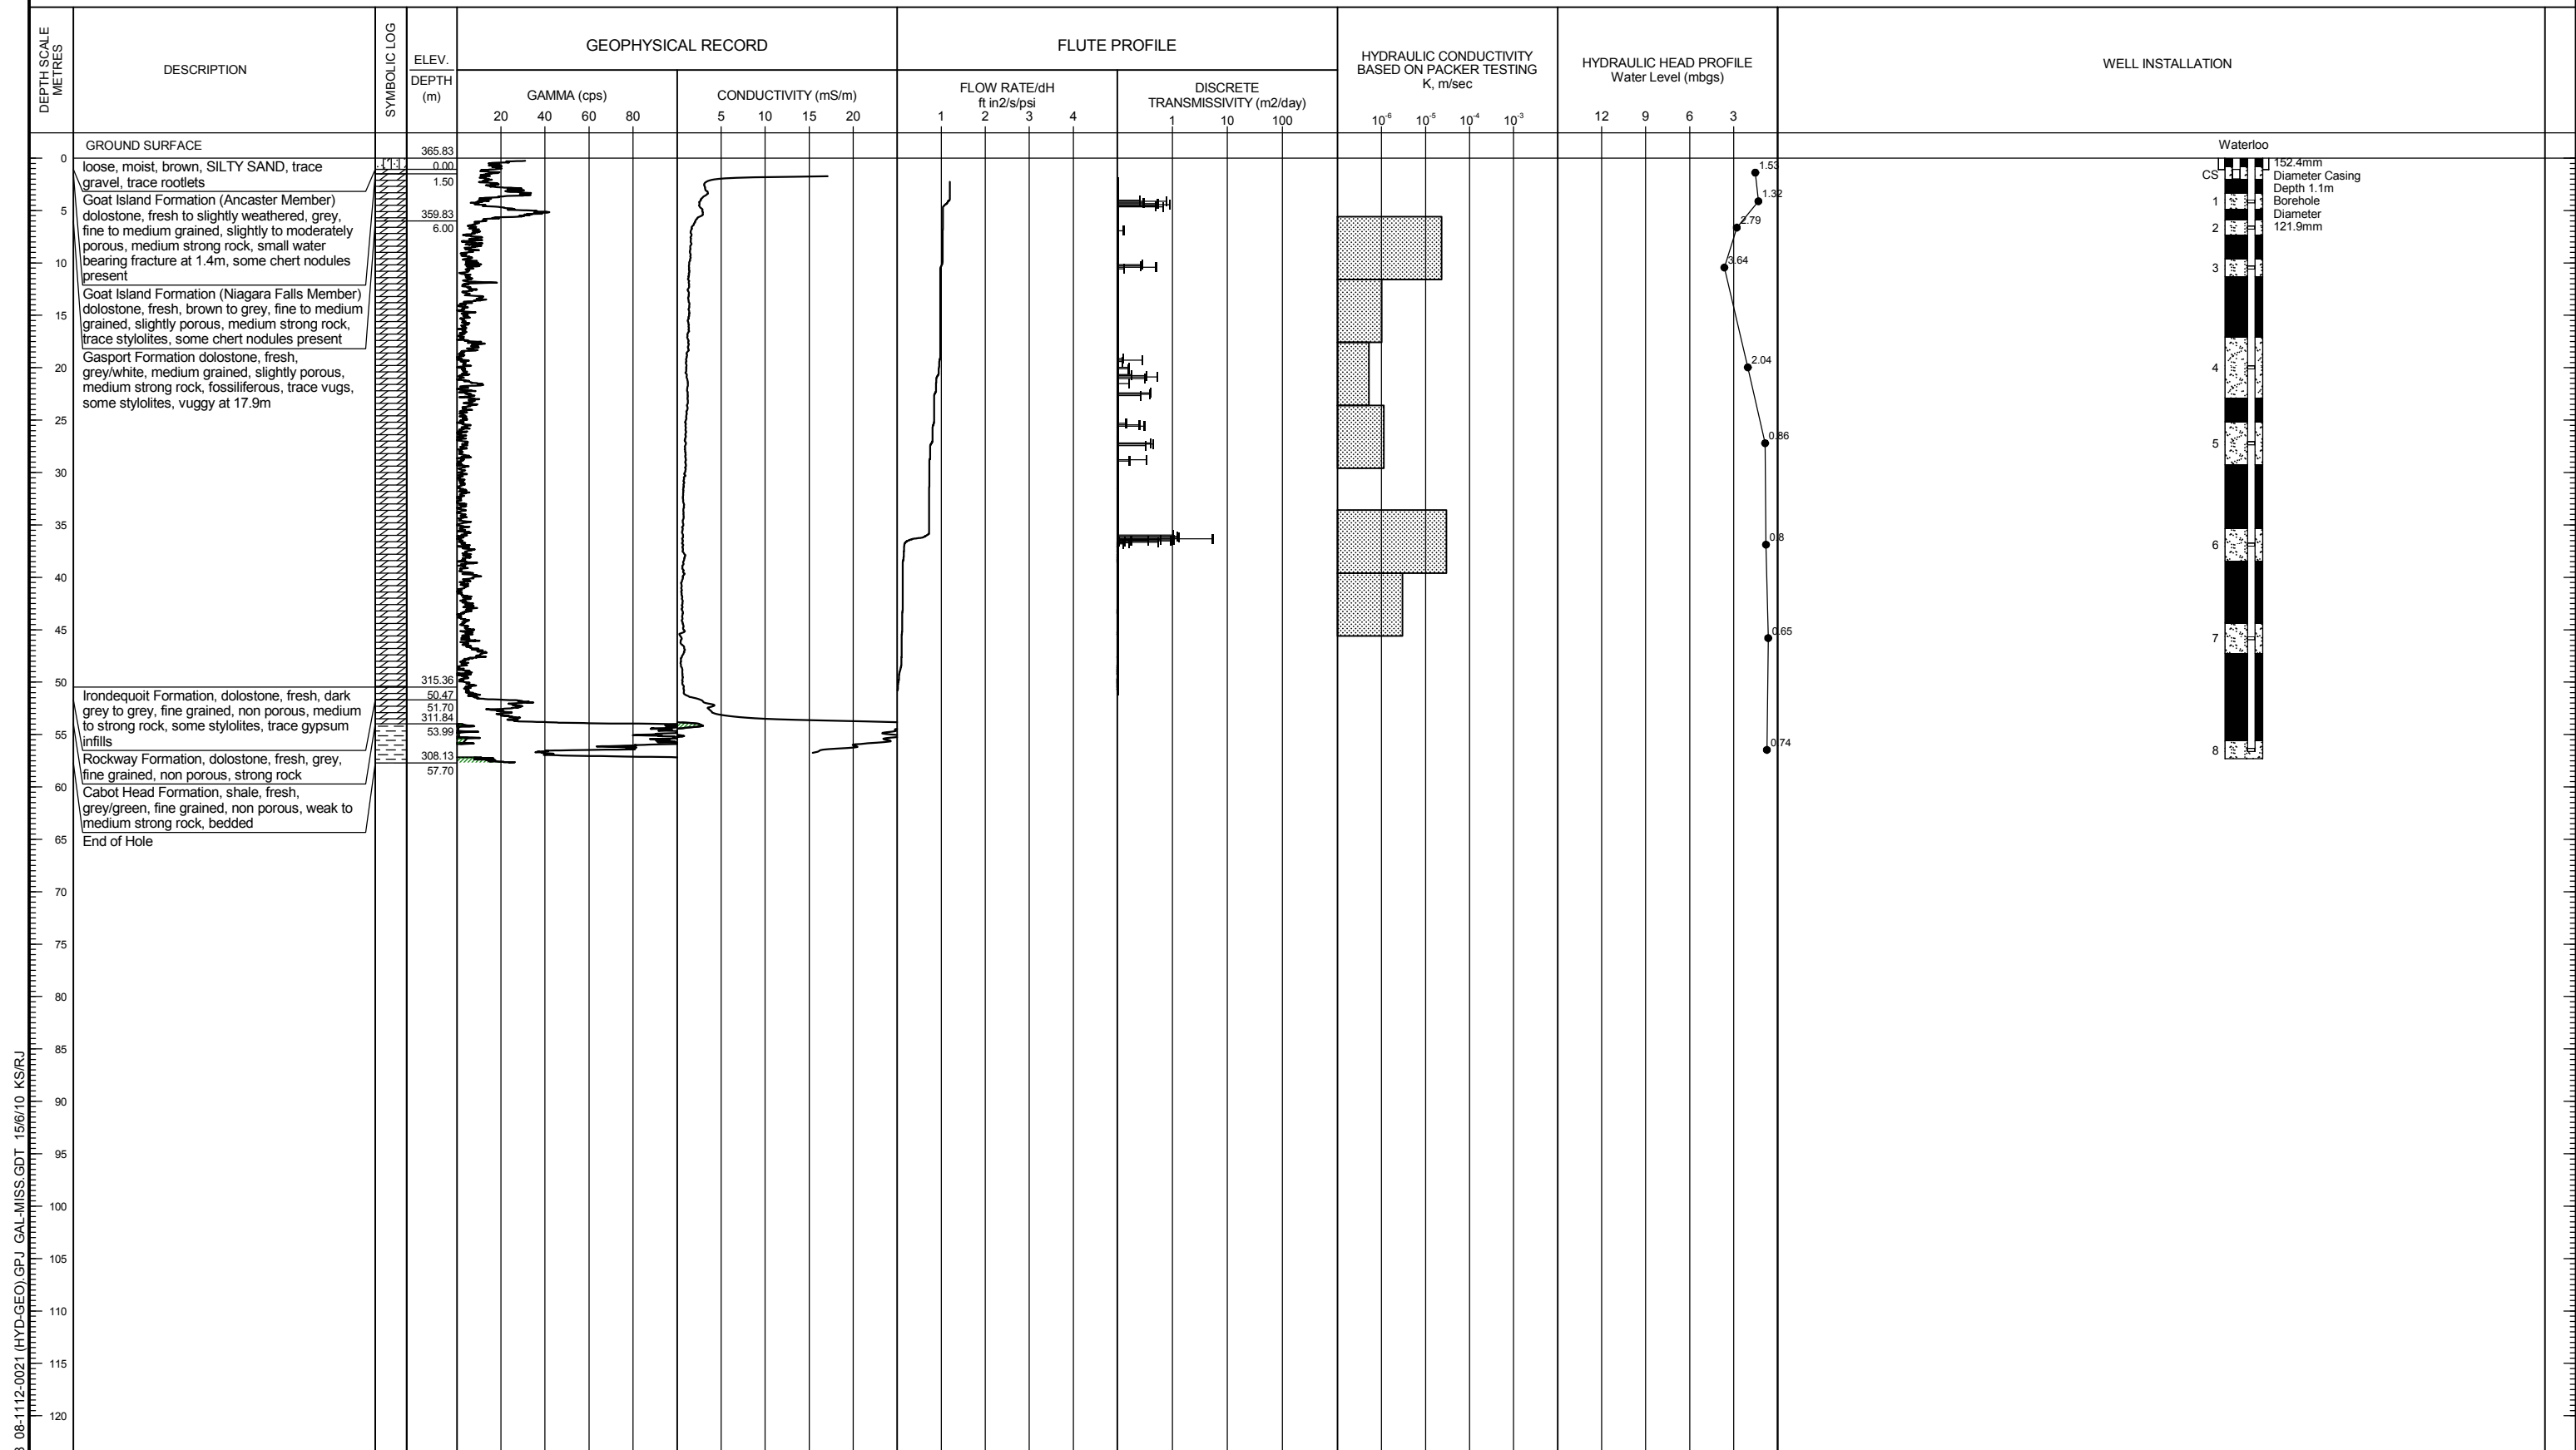

DEPTH SCALE

1 : 600

LOGGED: KS

HECKED: JP

MIS-HYD 008 08-1112-0021 (HYD-GEO).GPJ GAL-MISS.GDT 15/6/10 KS/RJ

LOCATION: N 4828348.6 ;E 564581.3

DRILLING DATE: 30/09/2008

DRILLING CONTRACTOR: Gerrits Well Drilling

DATUM: Local



1 : 600

HECKED: JP

LOCATION: N 4826604.5 ;E 560948.8

DRILLING DATE: 10/07/2008

DRILLING CONTRACTOR: Gerrits Well Drilling

DATUM: Local



1 : 600

HECKED: JP

PROJECT: 08-1112-0021


LOCATION: N 4820064.6 ;E 570645.1

RECORD OF DRILLHOLE: MW08-T3-09

SHEET 1 OF 1

DATUM: Local

DRILLING DATE: 12/08/2008
DRILL RIG: Air Rotary
DRILLING CONTRACTOR: Gerrits Well Drilling

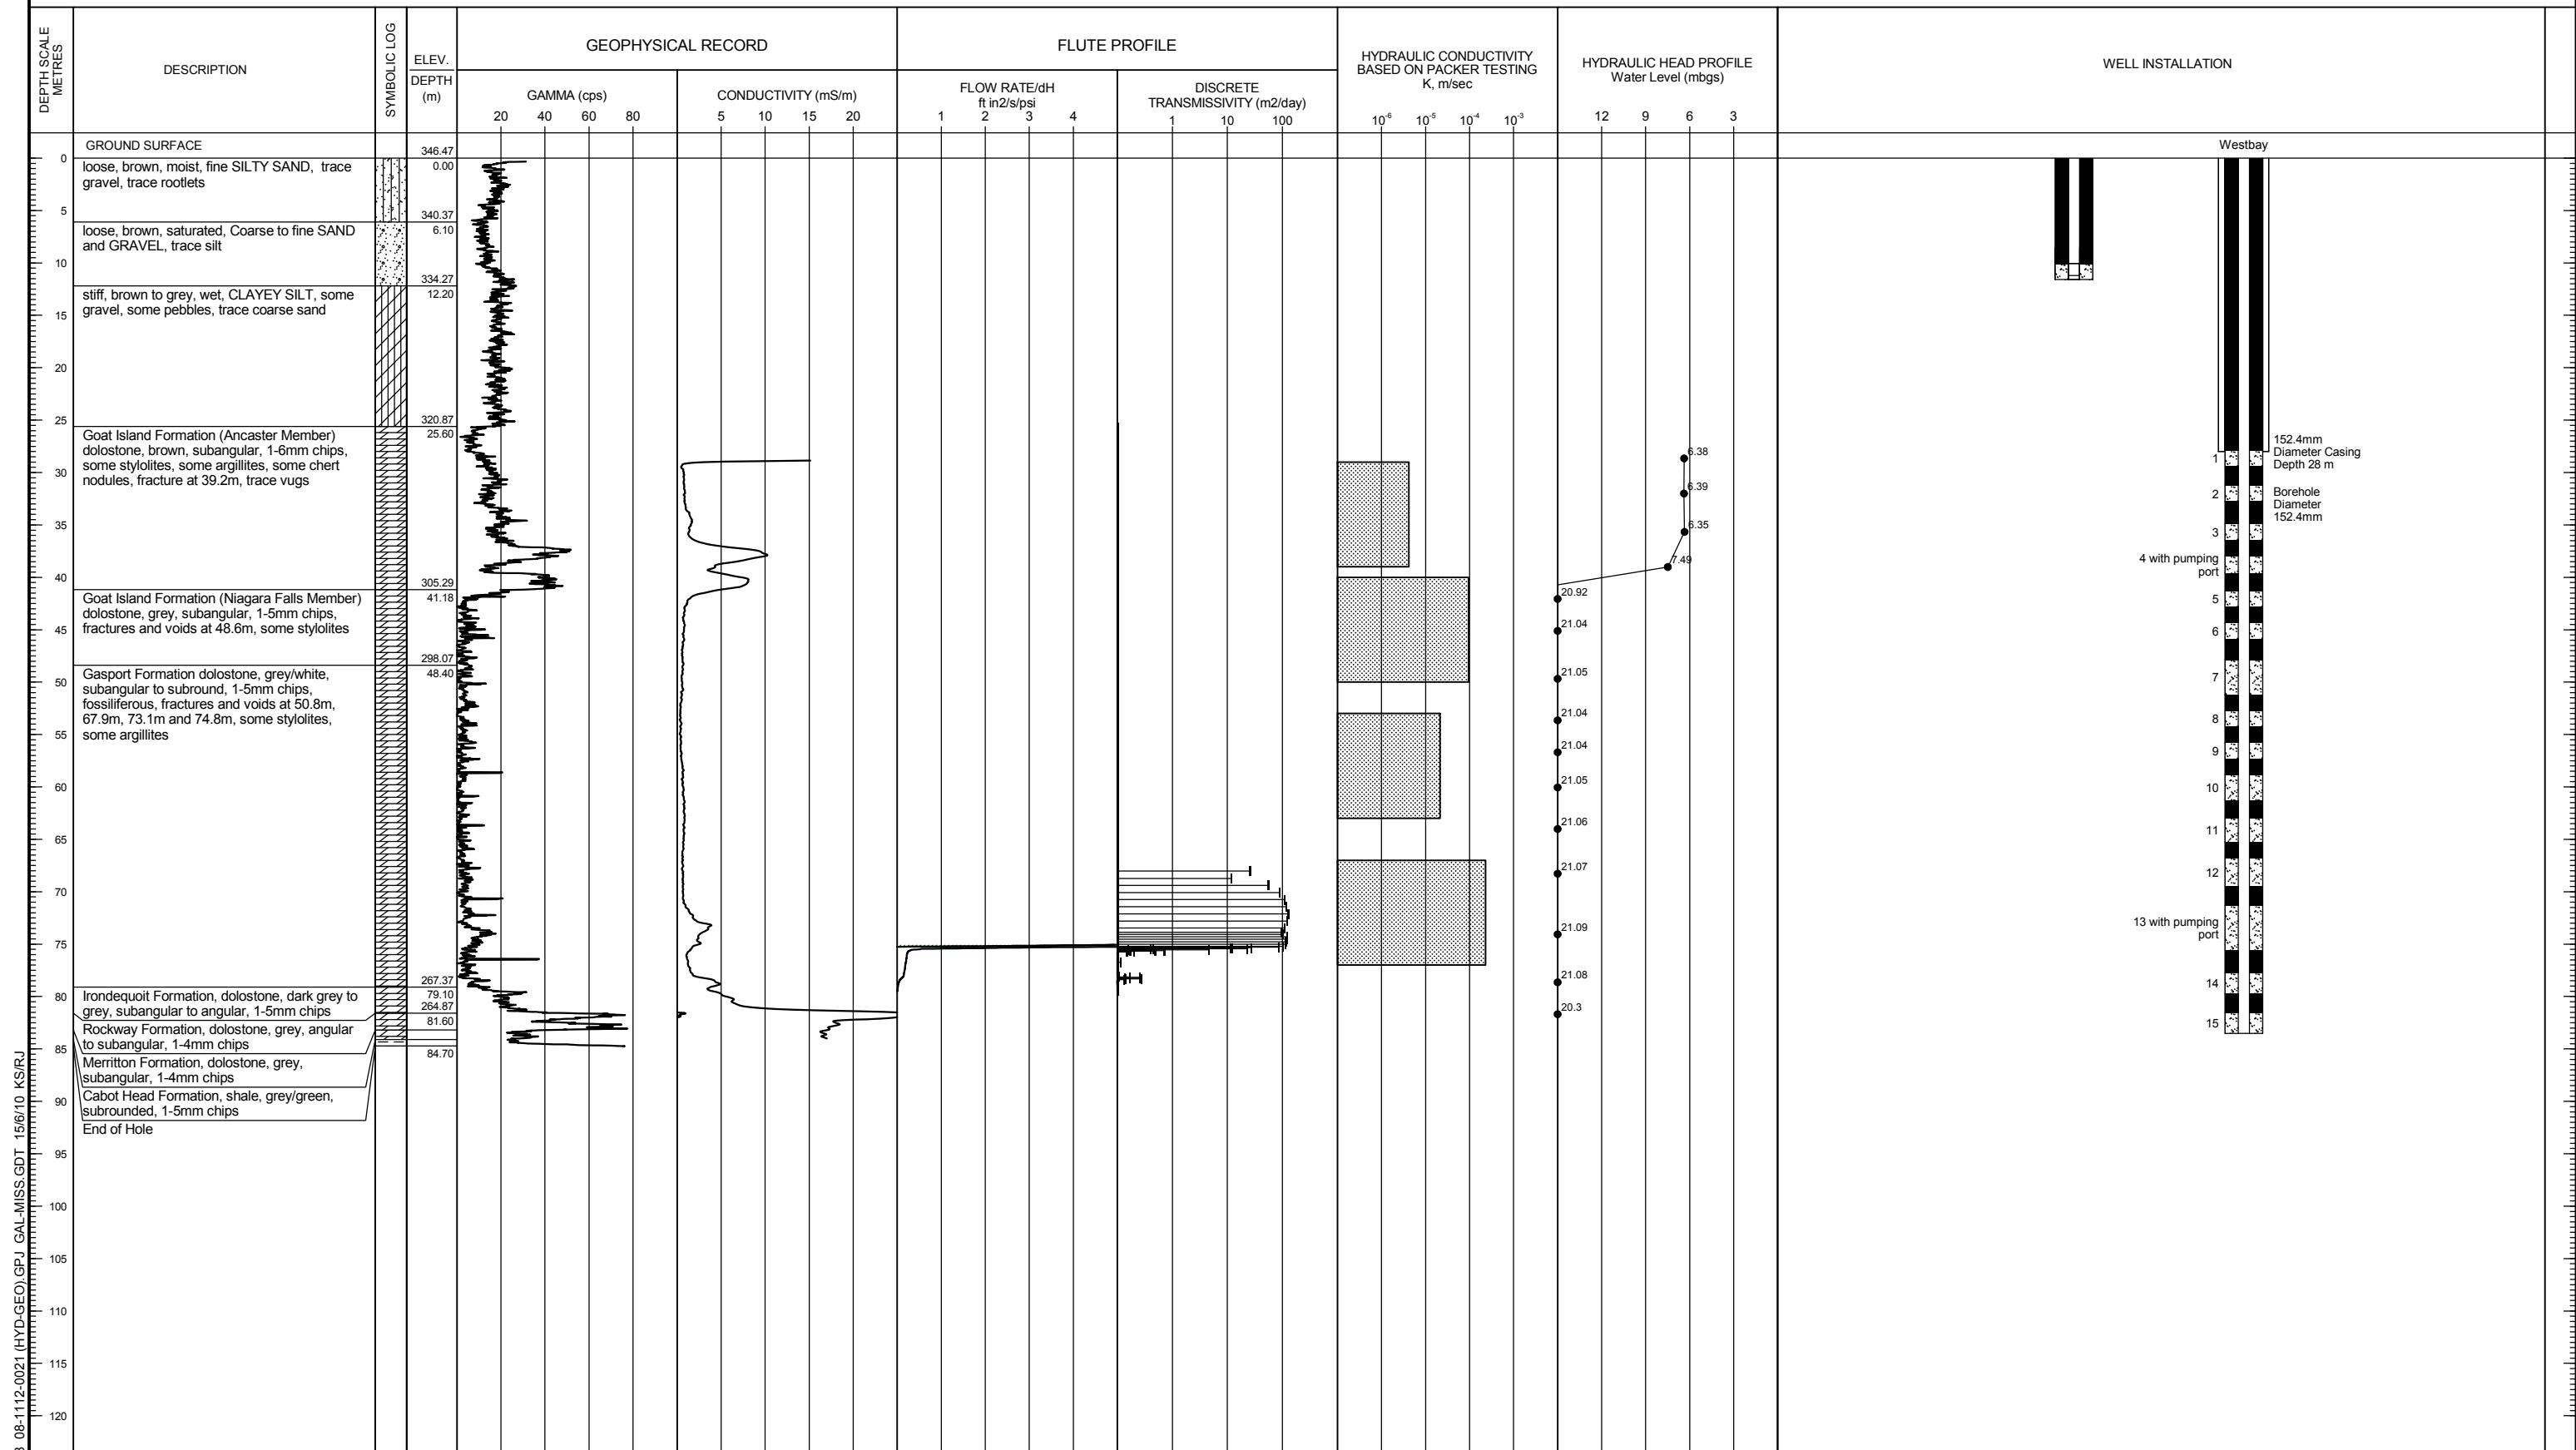

DEPTH SCALE
1 : 600

LOGGED: KS
CHECKED: JP

MIS-HYD 008 08-1112-0021 (HYD-GEO).GPJ GAL-MISS.GDT 15/6/10 KS/RJ

PROJECT: 08-1112-0021


LOCATION: N 4812508.9 ;E 563160.9

RECORD OF DRILLHOLE: MW08-T3-10

SHEET 1 OF 1

DATUM: Local

DRILLING DATE: 17/07/2008
DRILL RIG: Air Rotary
DRILLING CONTRACTOR: Gerrits Well Drilling

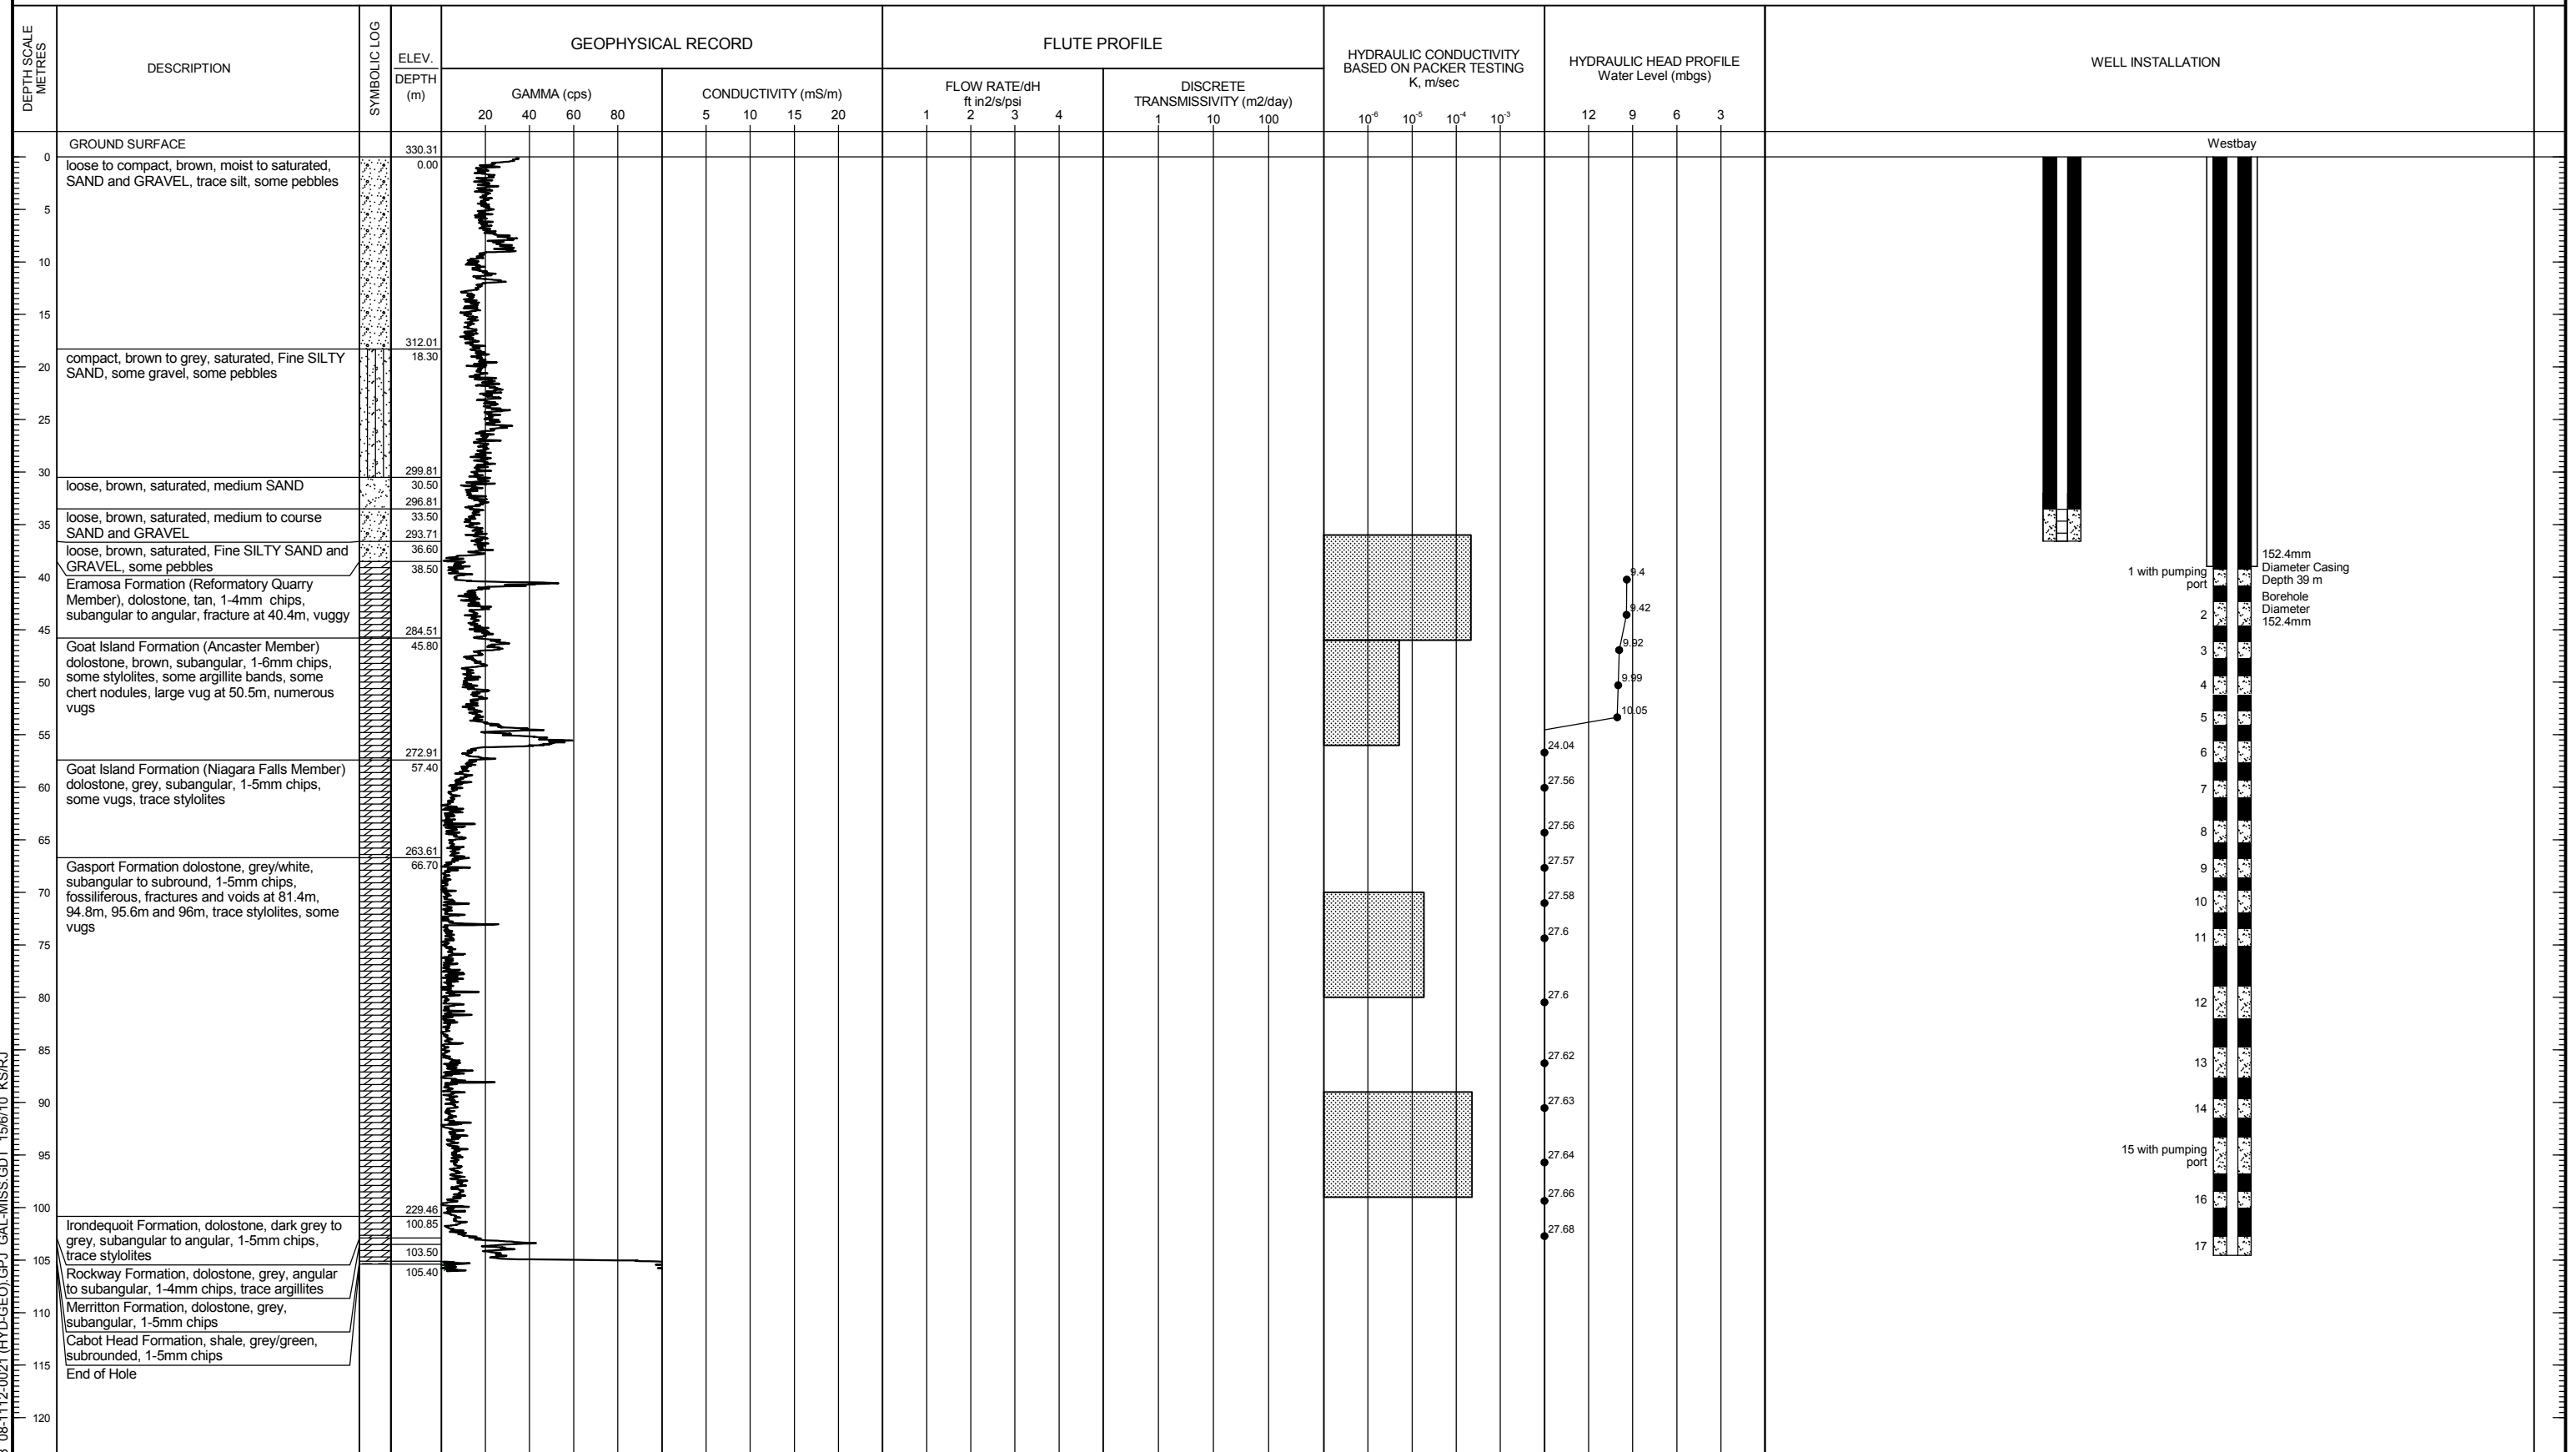

DEPTH SCALE
1 : 600

LOGGED: KS
CHECKED: JP

MIS-HYD 008 08-1112-0021 (HYD-GEO).GPJ GAL-MISS.GDT 15/6/10 KS/RJ

PROJECT: 08-1112-0021


LOCATION: N 4810649.0 ;E 560864.2

RECORD OF DRILLHOLE: MW09-T3-01

SHEET 1 OF 1

DATUM: Local

DRILLING DATE: 05/06/2009
DRILL RIG: CME 75
DRILLING CONTRACTOR: Aardvark Drilling

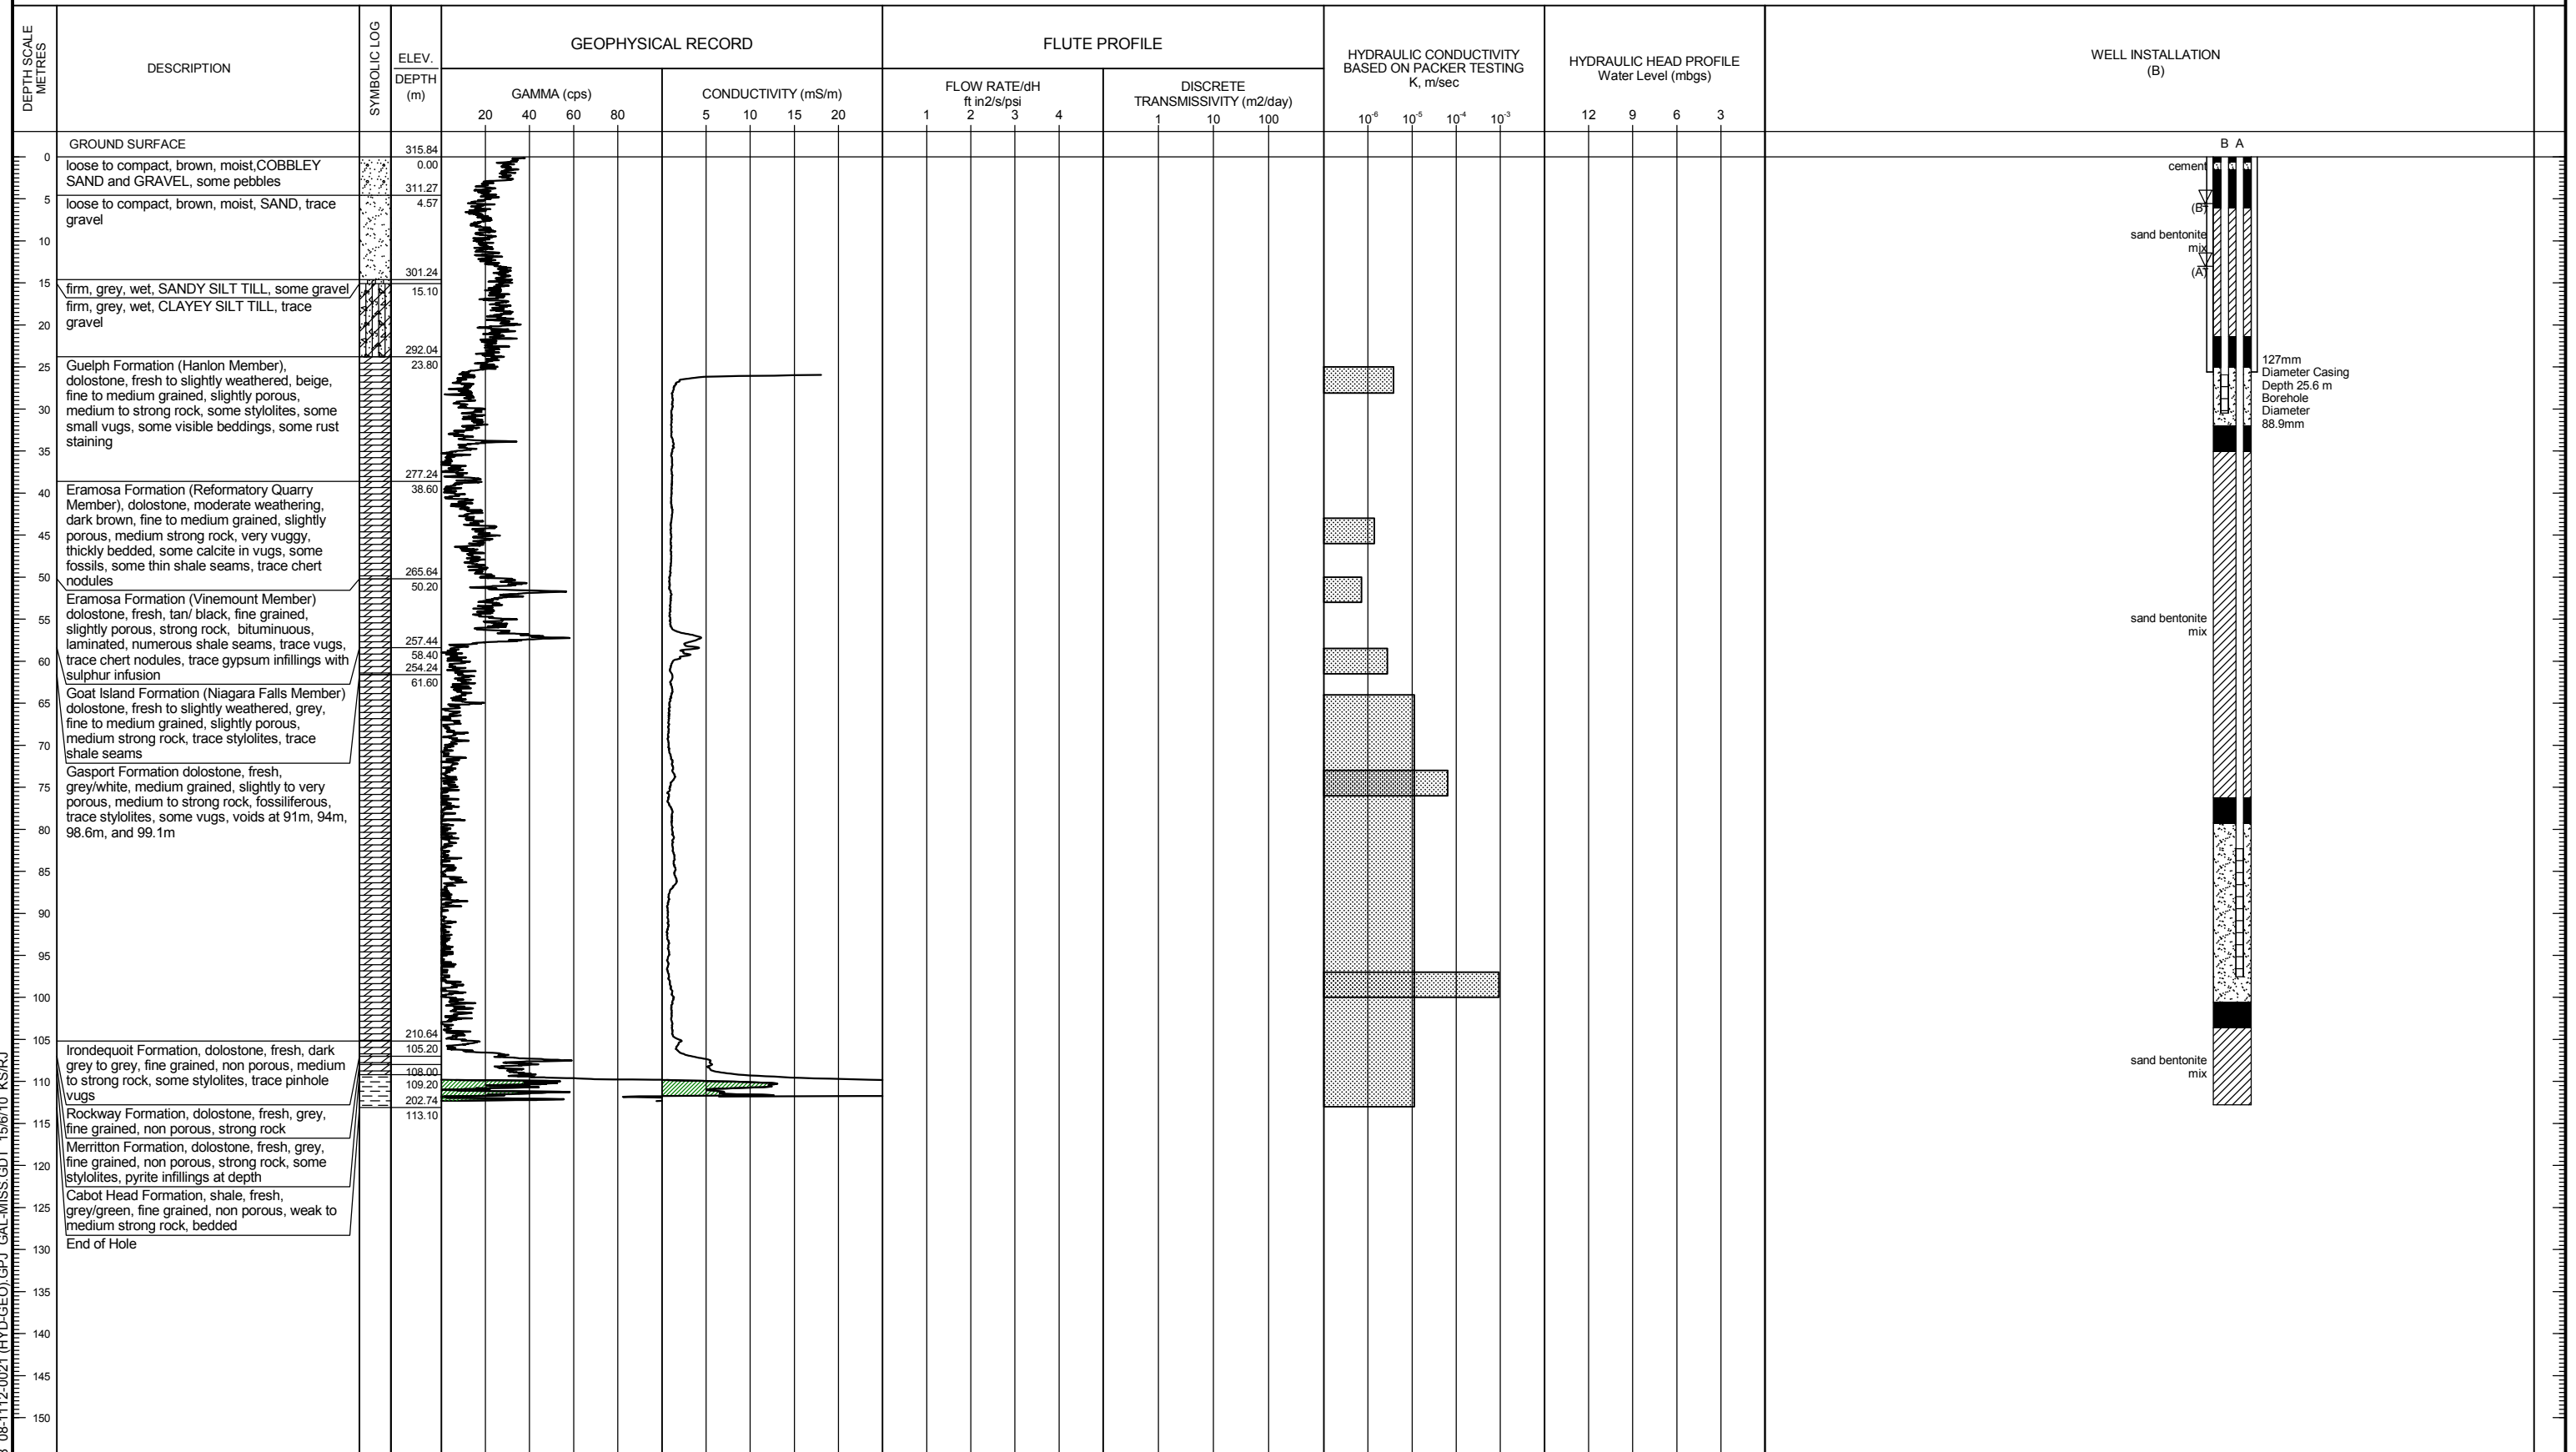

DEPTH SCALE
1 : 750

LOGGED: KS
CHECKED: JP

MIS-HYD 008 08-1112-0021 (HYD-GEO) GP.I GAL -MISS GDT 15/6/10 KS/R.I



APPENDIX C

Field Program Data



CITY OF GUELPH TIER THREE ASSESSMENT CHARACTERIZATION FINAL REPORT

C1: Water Well Records



Well Owner's Information

First Name GRLA City of Guelph	Last Name	E-mail Address	☐ Well Constructed by Well Owner
Mailing Address (Street Number/Name, RR) 59 Garden Street 400 Clyde Rd		Municipality Guelph Cambridge	Province Ontario
Postal Code N1E 3W6		Telephone No. (inc. area code)	

Part A Construction and/or Major Alteration of a Well

Address of Well Location (Street Number/Name, RR)		Township Guelph	Lot 13 Div.D	Concession 4
County/District/Municipality Wellington		City/Town/Village Guelph	Province Ontario	Postal Code
UTM Coordinates NAD 83	Zone 17	Easting 555 102	Northing 46 24 082	GPS Unit Make Magellan
Model		Mode of Operation: ☐ Undifferentiated ☒ Averaged ☐ Differentiated, specify		

Overburden and Bedrock Materials (see instructions on the back of this form)

General Colour	Most Common Material	Other Materials	General Description	Depth (Metres) From	To
Brown	Stones	Sand	Fill	0	1.52
Brown	Sand			1.52	3.04
Grey	Clay	Silt & Stones	Till	3.04	9.14
Brown	Clay	Limestone	Broken/fragmented	9.14	10.66
Brown	Grey	Limestone/Dolostone	Layers	10.66	95.09
Green	Shale			95.09	95.70

Annular Space/Abandonment Sealing Record

Depth Set at (Metres) From	To	Type of Sealant Used (Material and Type)	Volume Placed (Cubic Metres)

Results of Well Yield Testing

Check box if after test of well yield, water was: ☒ Clear and sand free ☐ Cannot develop to sand-free state If pumping discontinued, give reason:	Draw Down	Recovery		
	Time (Min) Static Level	Water Level (Metres) Static Level	Time (Min) Static Level	Water Level (Metres) Static Level
Pumping test method	1		1	
Pump intake set at (Metres)	2		2	
Pumping rate (Litres/min)	3		3	
Duration of pumping hrs + min	4		4	
Final water level end of pumping (Metres)	5		5	
Recommended pump type ☐ Shallow ☐ Deep	10		10	
Recommended pump depth Metres	15		15	
Recommended pump rate (Litres/min)	20		20	
If flowing give rate (Litres/min)	25		25	
	30		30	
	40		40	
	50		50	
	60		60	


Method of Construction	Water Use
☐ Cable Tool ☒ Rotary (Conventional) ☐ Rotary (Reverse) ☒ Rotary (Air) ☐ Air percussion ☐ Other, specify	☐ Diamond ☐ Jetting ☐ Driving ☐ Digging ☐ Boring ☐ Other, specify
☐ Public ☐ Domestic ☐ Livestock ☐ Irrigation ☐ Industrial ☐ Other, specify	☐ Commercial ☐ Municipal ☐ Test Hole ☐ Cooling & Air Conditioning ☒ Not used ☐ Dewatering ☐ Monitoring

Status of Well

☐ Water Supply ☐ Replacement Well ☐ Test Hole ☐ Recharge Well	☐ Dewatering Well ☐ Abandoned, Insufficient Supply ☐ Abandoned, Poor Water Quality ☐ Abandoned, other, specify	☒ Observation and/or Monitoring Hole ☐ Alteration (Construction) ☐ Other, specify
--	---	---

Location of Well

Please provide a map below showing:
- all property boundaries, and measurements sufficient to locate the well in relation to fixed points,
- an arrow indicating the North direction
- detailed drawings can be provided as attachments no larger than legal size (8.5" by 14")
- vidigital pictures of inside of well can also be provided

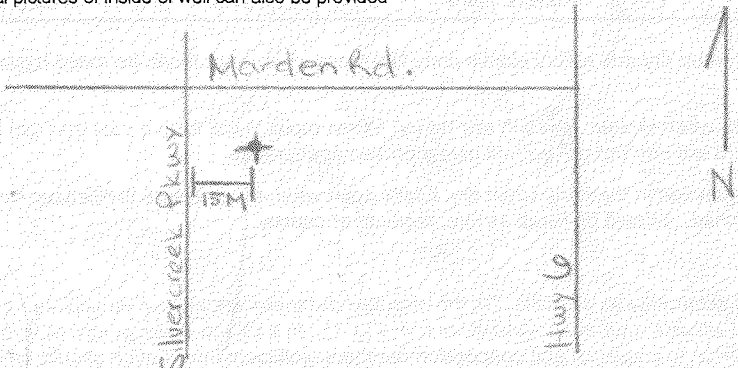

Date Well Completed (yyyy/mm/dd) 2008/07/09	Was the well owner's information package delivered? ☒ Yes ☐ No	Date the Well Record and Package Delivered to Well Owner (yyyy/mm/dd) 2008/07/09
--	--	---

Well Contractor and Well Technician Information

Business Name of Well Contractor Gerrits Drilling & Eng. Ltd.		Well Contractor's Licence No. 3 4 0 6
Business Address (Street No./Name, number, RR) RR#1 Grand Valley		Municipality
Province Ontario	Postal Code L0N 1G0	Business E-mail Address
Bus.Telephone No. (inc. area code) 2 9 6 4		Name of Well Technician (Last Name, First Name) Gerrits, Steve
Well Technician's Licence No. 2 9 6 4		Signature of Technician Steve Gerrits
Date Submitted (yyyy/mm/dd) 2008/07/09		

Water Details

Water found at Depth 4 5 Metres	Kind of Water ☐ Gas ☐ Fresh ☒ Salty ☐ Sulphur ☐ Minerals NOT TESTED
Water found at Depth 6 1 Metres	Kind of Water ☐ Gas ☐ Fresh ☒ Salty ☐ Sulphur ☐ Minerals NOT TESTED
Water found at Depth 6 9 Metres	Kind of Water ☐ Gas ☐ Fresh ☒ Salty ☐ Sulphur ☐ Minerals NOT TESTED

Casing Used

Screen Used

Casing and Well Details

☐ Galvanized ☒ Steel ☐ Fibreglass ☐ Plastic ☐ Concrete	☐ Galvanized ☐ Steel ☐ Fibreglass ☐ Plastic ☐ Concrete	Diameter of the Hole (Centimetres) 15.24 Depth of the Hole (Metres) 95.70 Wall Thickness (Metres) 0.477cm Inside Diameter of the Casing (Metres) 15.24 Depth of the Casing (Metres) 10.82
No Casing and Screen Used ☒ Open Hole		
Disinfected? ☒ Yes ☐ No		

Ministry Use Only

Audit No. 275949	Well Contractor No.
Date Received (yyyy/mm/dd)	Date of Inspection (yyyy/mm/dd)
Remarks	



Ministry of
the Environment

Well 1

A 051725

(Print Below)

MW08-T3-02

Well Record

Regulation 903 Ontario Water Resources Act

Page 1 of 1

Measurements recorded in: ☒ Metric ☐ Imperial

Well Owner's Information

First Name GREA	Last Name / Organization	E-mail Address	☐ Well Constructed by Well Owner
Mailing Address (Street Number/Name) 400 Clyde Rd	Municipality Cambridge	Province ON	Postal Code N1E5W6
Telephone No. (inc. area code)			

Well Location

Address of Well Location (Street Number/Name)		Township Eramosa	Lot 25	Concession 3
County/District/Municipality Wellington		City/Town/Village Guelph	Province Ontario	Postal Code
UTM Coordinates NAD 83	Zone 17	Easting 5519364	Northing 4835572	Municipal Plan and Sublot Number
				Other

Overburden and Bedrock Materials/Abandonment Sealing Record (see instructions on the back of this form)

General Colour	Most Common Material	Other Materials	General Description	Depth (m/ft) From	To
Brown	Sand	Silt/Gravel		0	8.20
Grey	Limestone			8.20	85.90
Grey/Black	Shale			85.90	89.90

Annular Space			
Depth Set at (m/ft) From	To	Type of Sealant Used (Material and Type)	Volume Placed (m³/ft³)
0	8.2	Portland Cement	0.20

Method of Construction		Well Use	
☐ Cable Tool	☐ Diamond	☐ Public	☐ Commercial
☒ Rotary (Conventional)	☐ Jetting	☐ Domestic	☐ Not used
☐ Rotary (Reverse)	☐ Driving	☐ Livestock	☐ Municipal
☐ Boring	☐ Digging	☐ Irrigation	☒ Test Hole
☐ Air percussion		☐ Industrial	☐ Cooling & Air Conditioning
☐ Other, specify		☐ Other, specify	

Construction Record - Casing				Status of Well	
Inside Diameter (cm/in)	Open Hole OR Material (Galvanized, Fibreglass, Concrete, Plastic, Steel)	Wall Thickness (cm/in)	Depth (m/ft) From	To	
15.0	Steel	0.719	10.40	8.50	☐ Water Supply
					☐ Replacement Well
					☐ Test Hole
					☐ Recharge Well
					☐ Dewatering Well
					☒ Observation and/or Monitoring Hole
					☐ Alteration (Construction)
					☐ Abandoned, Insufficient Supply
					☐ Abandoned, Poor Water Quality
					☐ Abandoned, other, specify
					☐ Other, specify

Construction Record - Screen				
Outside Diameter (cm/in)	Material (Plastic, Galvanized, Steel)	Slot No.	Depth (m/ft)	
			From	To

☐ Insufficient Supply

☐ Abandoned, Poor Water Quality

☐ Abandoned, other, *specify* _____

☐ Other, *specify* _____

Water Details		Hole Diameter	
Water found at Depth (m/ft)	Kind of Water: ☐ Fresh ☐ Untested ☐ Gas ☐ Other, specify	Depth (m/ft) From	To
		0	8.50
		8.50	89.70

Well Contractor and Well Technician Information			
Business Name of Well Contractor Gerrits Drilling & Engineering Ltd.		Well Contractor's Licence No. 2191016	
Business Address (Street Number/Name) 215154 10th Line, R.R. #1		Municipality Grand Valley, Ontario L0N 1G0	
Province ON	Postal Code N1E5W6	Business E-mail Address	
Bus. Telephone No. (inc. area code)	Name of Well Technician (Last Name, First Name) Steve Gerrits		
Well Technician's Licence No.	Signature of Technician and/or Contractor		Date Submitted 8/4/16

Results of Well Yield Testing					
After test of well yield, water was:		Draw Down		Recovery	
☐ Clear and sand free		Time	Water Level	Time	Water Level
☐ Other, <i>specify</i> _____		(min)	(m/ft)	(min)	(m/ft)
If pumping discontinued, give reason:		Static Level			
		1		1	
Pump intake set at (m/ft)		2		2	
Pumping rate (l/min / GPM)		3		3	
Duration of pumping		4		4	
_____ hrs + _____ min		5		5	
Final water level end of pumping (m/ft)		10		10	
If flowing give rate (l/min / GPM)		15		15	
Recommended pump depth (m/ft)		20		20	
		25		25	
Recommended pump rate (l/min / GPM)		30		30	
Well production (l/min / GPM)		40		40	
		50		50	
Disinfected?					
☒ Yes ☐ No		60		60	

Map of Well Location	
Please provide a map below following instructions on the back.	
see attached	
Comments:	
Well owner's information package delivered ☒ Yes ☐ No	Date Package Delivered 8/4/16
Date Work Completed 8/4/16	Ministry Use Only Audit No. 2110399 Received



Measurements recorded in: ☐ Metric ☒ Imperial

Well Tag No. **A 051690**
A051690

Page 1 of 1

Well Owner's Information

First Name GRCA	Last Name / Organization	E-mail Address	☐ Well Constructed by Well Owner
Mailing Address (Street Number/Name) 400 Clyde Road PO Box 729	Municipality Cambridge	Province ON	Postal Code N1A 5W6
Telephone No. (inc. area code)			

Well Location

Address of Well Location (Street Number/Name)	Township Eramosa	Lot 24	Concession 4
County/District/Municipality Wellington	City/Town/Village	Province Ontario	Postal Code
UTM Coordinates Zone NAD 83	Easting 17 563022	Northings 4835572	Municipal Plan and Sublot Number
Other			

Overburden and Bedrock Materials/Abandonment Sealing Record (see instructions on the back of this form)

General Colour	Most Common Material	Other Materials	General Description	Depth (m/ft) From	Depth (m/ft) To
Brown	Sand	Gravel		0	6.40
Brown	Clay			6.40	7.01
Brown	Sand	Clay		7.01	21.33
Brown	Clay	Limestone	Layered	21.33	28.95
Brown	Gravel	Limestone	Layered/fragmented	28.95	36.88

Annular Space		
Depth Set at (m/ft) From	To	Type of Sealant Used (Material and Type)
		Volume Placed (m³/ft³)
		See attached diagram

Method of Construction	Well Use
☐ Cable Tool ☐ Rotary (Conventional) ☐ Rotary (Reverse) ☐ Boring ☒ Air percussion ☐ Other, specify	☐ Diamond ☐ Jetting ☐ Driving ☐ Digging ☐ Public ☐ Domestic ☐ Livestock ☐ Irrigation ☐ Industrial ☐ Commercial ☐ Municipal ☐ Test Hole ☐ Cooling & Air Conditioning ☐ Not used ☐ Dewatering ☒ Monitoring

Construction Record - Casing				Status of Well	
Inside Diameter (cm/in)	Open Hole OR Material (Galvanized, Fibreglass, Concrete, Plastic, Steel)	Wall Thickness (cm/in)	Depth (m/ft) From To	☐ Water Supply ☐ Replacement Well ☐ Test Hole ☐ Recharge Well ☐ Dewatering Well ☒ Observation and/or Monitoring Hole ☐ Alteration (Construction) ☐ Abandoned, Insufficient Supply ☐ Abandoned, Poor Water Quality ☐ Abandoned, other, specify ☐ Other, specify	
3.17	sch.40	0.55	35.36		

Construction Record - Screen			
Outside Diameter (cm/in)	Material (Plastic, Galvanized, Steel)	Slot No.	Depth (m/ft) From To
3.59	Plastic	10	35.36 15.56

Water Details		Hole Diameter	
Water found at Depth 35 (m/ft)	Kind of Water: ☐ Fresh ☒ Untested	Depth (m/ft) From To	Diameter (cm/in)
	☐ Gas ☐ Other, specify	0 35.36	15.56
Water found at Depth (m/ft)	Kind of Water: ☐ Fresh ☐ Untested		
	☐ Gas ☐ Other, specify		
Water found at Depth (m/ft)	Kind of Water: ☐ Fresh ☐ Untested		
	☐ Gas ☐ Other, specify		

Well Contractor and Well Technician Information			
Business Name of Well Contractor Gerrits Drilling & Eng. Ltd.	Well Contractor's Licence No. 3 4 0 6		
Business Address (Street Number/Name) RR#1 Grand Valley	Municipality		
Province ON	Postal Code L0N 1G0	Business E-mail Address	
Bus. Telephone No. (inc. area code)	Name of Well Technician (Last Name, First Name) Gerrits, Steve		
Well Technician's Licence No. 2 9 6 4	Signature of Technician and/or Contractor <i>[Signature]</i>		Date Submitted 2008 Y 10 M 20

Results of Well Yield Testing				
After test of well yield, water was: ☒ Clear and sand free ☐ Other, specify	Draw Down		Recovery	
	Time (min)	Water Level (m/ft)	Time (min)	Water Level (m/ft)
If pumping discontinued, give reason:	Static Level			
	1		1	
Pump intake set at (m/ft)	2		2	
Pumping rate (l/min / GPM)	3		3	
Duration of pumping hrs + min	4		4	
Final water level end of pumping (m/ft)	5		5	
If flowing give rate (l/min / GPM)	10		10	
Recommended pump depth (m/ft)	15		15	
Recommended pump rate (l/min / GPM)	20		20	
Well production (l/min / GPM)	25		25	
Disinfected?	30		30	
☒ Yes ☐ No	40		40	
	50		50	
	60		60	

Map of Well Location
Please provide a map below following instructions on the back.
<i>[Hand-drawn map showing location relative to City Rd. 22 and a line, with a north arrow]</i>

Comments: Area 3 Shallow	Well owner's information package delivered ☒ Yes ☐ No	Date Package Delivered 2008 Y 10 M 05 D	Date Work Completed 2008 Y 10 M 05 D
Ministry Use Only		Audit No. Z 84482	
Received			



Well Owner's Information

First Name GRCA	Last Name / Organization	E-mail Address	☐ Well Constructed by Well Owner
Mailing Address (Street Number/Name) 400 Clyde Road Box 729		Municipality Cambridge	Province ON
		Postal Code N1R 5W6	Telephone No. (inc. area code)

Well Location

Address of Well Location (Street Number/Name)		Township Nichol	Lot 12	Concession 2
County/District/Municipality Wellington		City/Town/Village	Province Ontario	Postal Code
UTM Coordinates NAD 83	Zone 17	Easting 55 2662	Northing 48 36 448	Municipal Plan and Sublot Number
				Other

Overburden and Bedrock Materials/Abandonment Sealing Record (see instructions on the back of this form)

General Colour	Most Common Material	Other Materials	General Description	Depth (m/ft) From	To
Brown	Sand			0	6.4
Brown	Gravel	Sand	Coarse	6.4	15.54
Brown	Clay			15.54	18.28
Brown	Gravel	Sand		18.28	19.20
Grey/Brown	limestone/dolostone layers			19.20	140.81
Green	SHale			140.81	143.87

Annular Space

Depth Set at (m/ft) From	To	Type of Sealant Used (Material and Type)	Volume Placed (m³/ft³)
0	6.4	Bank Locking	0.05

Method of Construction

Well Use

☐ Cable Tool	☐ Diamond	☐ Public	☐ Commercial	☐ Not used
☒ Rotary (Conventional)	☐ Jetting	☐ Domestic	☐ Municipal	☐ Dewatering
☐ Rotary (Reverse)	☐ Driving	☐ Livestock	☐ Test Hole	☒ Monitoring
☐ Boring	☐ Digging	☐ Irrigation	☐ Cooling & Air Conditioning	
☒ Air percussion		☐ Industrial		
☐ Other, specify		☐ Other, specify		

Construction Record - Casing

Status of Well

Inside Diameter (cm/in)	Open Hole OR Material (Galvanized, Fibreglass, Concrete, Plastic, Steel)	Wall Thickness (cm/in)	Depth (m/ft) From	To
15.56		0.477	0.43	19.35
	open hole		19.35	143.87

☐ Water Supply	☐ Replacement Well	☐ Test Hole
☐ Recharge Well	☐ Dewatering Well	☒ Observation and/or Monitoring Hole
☐ Alteration (Construction)	☐ Abandoned, Insufficient Supply	☐ Abandoned, Poor Water Quality
☐ Abandoned, other, specify		
☐ Other, specify		

Construction Record - Screen

Outside Diameter (cm/in)	Material (Plastic, Galvanized, Steel)	Slot No.	Depth (m/ft) From	To

Water Details

Hole Diameter

Water found at Depth 27 (m/ft)	Kind of Water: ☐ Fresh ☒ Untested	Depth (m/ft) From	To	Diameter (cm/in)
	☐ Gas ☐ Other, specify	0	140.87	15.56
Water found at Depth 85 (m/ft)	Kind of Water: ☐ Fresh ☒ Untested			
	☐ Gas ☐ Other, specify			
Water found at Depth 109 (m/ft)	Kind of Water: ☐ Fresh ☒ Untested			
	☐ Gas ☐ Other, specify			

Well Contractor and Well Technician Information

Business Name of Well Contractor Gerrits Drilling & Eng. Ltd.	Well Contractor's Licence No. 3 4 0 6
Business Address (Street Number/Name) RR#1 Grand Valley	Municipality
Province ON	Postal Code L0N1G0
Business E-mail Address	

Bus. Telephone No. (inc. area code)	Name of Well Technician (Last Name, First Name) Gerrits, Steve
Well Technician's Licence No. 2 9 6 4	Signature of Technician and/or Contractor [Signature]
	Date Submitted 2008 Y 08 M 28 D

Results of Well Yield Testing

After test of well yield, water was: ☒ Clear and sand free ☐ Other, specify	Draw Down		Recovery	
	Time (min)	Water Level (m/ft)	Time (min)	Water Level (m/ft)
If pumping discontinued, give reason:	Static Level	10.19		19.35
	1	13.92	1	15.80
Pump intake set at (m/ft) 30.48	2	14.72	2	15.00
	3	15.16	3	14.63
Pumping rate (l/min / GPM) 189.6	4	15.43	4	14.37
	5	15.67	5	14.16
Duration of pumping 4 hrs + 0 min	10	15.82	10	13.63
	15	16.70	15	
Final water level end of pumping (m/ft) 19.35	20	17.01	20	13.09
	25	17.26	25	
If flowing give rate (l/min / GPM)	30	17.43	30	12.77
	40	17.71	40	12.54
Recommended pump depth (m/ft) 30.48	50	17.91	50	12.36
	60	18.06	60	12.20
Recommended pump rate (l/min / GPM) 189.6				
Well production (l/min / GPM)				
Disinfected? ☒ Yes ☐ No				

Map of Well Location

Please provide a map below following instructions on the back.

Map showing well location relative to Fergus and Hwy 6. The map includes a north arrow and a scale bar indicating 2438 feet. The well is located near the intersection of Hwy 6 and a road labeled 'To Fergus'.

Comments: Area 4 deep

Well owner's information package delivered ☒ Yes ☐ No	Date Package Delivered 2008 Y 08 M 08 D	Date Work Completed 2008 Y 08 M 08 D	Ministry Use Only Audit No. Z 84526 Received
--	--	---	--



Measurements recorded in: ☒ Metric ☐ Imperial

A051692

Page 1 of 1

Well Owner's Information

First Name GRCA	Last Name / Organization	E-mail Address	☐ Well Constructed by Well Owner
Mailing Address (Street Number/Name) 400 Clyde Road PO Box 729		Municipality Cambridge	Province ON
		Postal Code N1R 5W6	Telephone No. (inc. area code)

Well Location

Address of Well Location (Street Number/Name)		Township Nichol	Lot 12	Concession 2
County/District/Municipality Wellington		City/Town/Village	Province Ontario	Postal Code
UTM Coordinates NAD 83 17 552656 4836469	Zone 17	Easting 552656	Northings 4836469	Municipal Plan and Sublot Number
				Other

Overburden and Bedrock Materials/Abandonment Sealing Record (see instructions on the back of this form)

General Colour	Most Common Material	Other Materials	General Description	Depth (m/ft) From	To
Brown	Sand			0	3.96
Brown	Clay	Sand		3.96	7.92
Brown	Gravel	Sand	Coarse	7.92	16.76
Grey	Clay			16.76	17.06

Annular Space			
Depth Set at (m/ft) From	To	Type of Sealant Used (Material and Type)	Volume Placed (m³/ft³)
		See attached diagram	

Method of Construction		Well Use	
☐ Cable Tool	☐ Diamond	☐ Public	☐ Commercial
☒ Rotary (Conventional)	☐ Jetting	☐ Domestic	☐ Municipal
☐ Rotary (Reverse)	☐ Driving	☐ Livestock	☐ Test Hole
☐ Boring	☐ Digging	☐ Irrigation	☐ Cooling & Air Conditioning
☐ Air percussion		☐ Industrial	☒ Monitoring
☐ Other, specify		☐ Other, specify	

Construction Record - Casing				Status of Well	
Inside Diameter (cm/in)	Open Hole OR Material (Galvanized, Fibreglass, Concrete, Plastic, Steel)	Wall Thickness (cm/in)	Depth (m/ft) From	To	
3.17		sch 40	0.50	15.24	☐ Water Supply
					☐ Replacement Well
					☐ Test Hole
					☐ Recharge Well
					☐ Dewatering Well
					☒ Observation and/or Monitoring Hole
					☐ Alteration (Construction)
					☐ Abandoned, Insufficient Supply
					☐ Abandoned, Poor Water Quality
					☐ Abandoned, other, specify
					☐ Other, specify

Construction Record - Screen					☐ Abandoned, Poor Water Quality ☐ Abandoned, other, <i>specify</i> ☐ Other, <i>specify</i>
Outside Diameter (cm/in)	Material (Plastic, Galvanized, Steel)	Slot No.	Depth (m/ft)		
			From	To	
3.59	Plastic	10	15.24	16.76	

Water Details		Hole Diameter	
Water found at Depth 15 (m/ft)	Kind of Water: ☐ Fresh ☒ Untested	Depth (m/ft) From	To
	☐ Gas ☐ Other, specify	0	17.06
Water found at Depth (m/ft)	Kind of Water: ☐ Fresh ☐ Untested		
	☐ Gas ☐ Other, specify		
Water found at Depth (m/ft)	Kind of Water: ☐ Fresh ☐ Untested		
	☐ Gas ☐ Other, specify		

Well Contractor and Well Technician Information			
Business Name of Well Contractor Gerrits Drilling & Eng. Ltd.		Well Contractor's Licence No. 3 4 0 6	
Business Address (Street Number/Name) RR#1 Grand Valley		Municipality	
Province ON	Postal Code L0N 1B0	Business E-mail Address	
Bus. Telephone No. (inc. area code)		Name of Well Technician (Last Name, First Name) Gerrits, Steve	
Well Technician's Licence No.		Signature of Technician and/or Contractor [Signature]	
Date Submitted 2008 08 20			

Results of Well Yield Testing				
After test of well yield, water was: ☒ Clear and sand free ☐ Other, specify _____	Draw Down		Recovery	
	Time (min)	Water Level (m/ft)	Time (min)	Water Level (m/ft)
If pumping discontinued, give reason:	Static Level	10		
	1	10	1	
	2	10	2	
	3	10	3	
Pump intake set at (m/ft) 5.916	4	10	4	
Pumping rate (l/min / GPM) 12.57	5	10	5	
Duration of pumping 4 hrs + 0 min	10	10	10	
Final water level end of pumping (m/ft) 16.76	15	10	15	
If flowing give rate (l/min-/ GPM)	20		20	
Recommended pump depth (m/ft) 16.76	25		25	
Recommended pump rate (l/min / GPM) 12.57	30		30	
Well production (l/min / GPM)	40		40	
Disinfected?	50		50	
☒ Yes ☐ No	60		60	

Map of Well Location	
Please provide a map below following instructions on the back. see attached	
Comments: Area 4 Shallow	
Well owner's information package delivered ☒ Yes ☐ No	Date Package Delivered 2008 08 01 Date Work Completed 2008 08 01
Ministry Use Only Audit No. Z 84525 Received	



Ministry of
the Environment

Well

A 051724

Print Below)

MW08 - T3 - 05

Well Record

Regulation 903 Ontario Water Resources Act

Measurements recorded in: ☒ Metric ☐ Imperial

Page 1 of 1

Well Owner's Information

First Name GRCA	Last Name / Organization	E-mail Address	☐ Well Constructed by Well Owner
Mailing Address (Street Number/Name) 400 Clyde Rd	Municipality Cambridge	Province ON	Postal Code N1E5W4
Telephone No. (inc. area code)			

Well Location

Address of Well Location (Street Number/Name)	Township Eramosa	Lot 30	Concession 3
County/District/Municipality Wellington	City/Town/Village	Province Ontario	Postal Code
UTM Coordinates Zone NAD 83	Easting 175612217	Northing 41845821	Municipal Plan and Sublot Number
Other			

Overburden and Bedrock Materials/Abandonment Sealing Record (see instructions on the back of this form)

General Colour	Most Common Material	Other Materials	General Description	Depth (m/ft) From	To
Brown	Sand			3.05	3.05
Brown	Sand	Silt		3.05	9.75
Brown	Sand / Gravel			9.75	14.63
Brown / Grey	Silt	Clay		14.63	16.76
Brown / Grey	Loess-like			16.76	101.70
Grey / Brown	Shale			101.70	104.90

Annular Space		
Depth Set at (m/ft) From	Type of Sealant Used (Material and Type)	Volume Placed (m³/ft³)
	See Attached	

Method of Construction	Well Use
☐ Cable Tool ☒ Rotary (Conventional) ☐ Rotary (Reverse) ☐ Boring ☐ Air percussion ☐ Other, specify	☐ Public ☐ Domestic ☐ Livestock ☐ Irrigation ☐ Industrial ☐ Other, specify
☐ Diamond ☐ Jetting ☐ Driving ☐ Digging	☐ Commercial ☐ Municipal ☒ Test Hole ☐ Cooling & Air Conditioning ☐ Not used ☐ Dewatering ☒ Monitoring

Construction Record - Casing				Status of Well	
Inside Diameter (cm/in)	Open Hole OR Material (Galvanized, Fibreglass, Concrete, Plastic, Steel)	Wall Thickness (cm/in)	Depth (m/ft) From	To	
15	Steel	0.219	104.11	19.20	☐ Water Supply
17.2	Open Hole		19.20	104.90	☐ Replacement Well
	see attached				☐ Test Hole
					☐ Recharge Well
					☐ Dewatering Well
					☒ Observation and/or Monitoring Hole
					☐ Alteration (Construction)
					☐ Abandoned, Insufficient Supply
					☐ Abandoned, Poor Water Quality
					☐ Abandoned, other, specify
					☐ Other, specify

Construction Record - Screen				
Outside Diameter (cm/in)	Material (Plastic, Galvanized, Steel)	Slot No.	Depth (m/ft) From	To

Water Details		Hole Diameter	
Water found at Depth (m/ft)	Kind of Water: ☐ Fresh ☐ Untested ☐ Gas ☐ Other, specify	Depth (m/ft) From	Diameter (cm/in) To
Water found at Depth (m/ft)	Kind of Water: ☐ Fresh ☐ Untested ☐ Gas ☐ Other, specify	0	14.20 15.7
Water found at Depth (m/ft)	Kind of Water: ☐ Fresh ☐ Untested ☐ Gas ☐ Other, specify	19.70	104.90 12.2

Well Contractor and Well Technician Information			
Business Name of Well Contractor Gerrits Drilling & Engineering Ltd.	Well Contractor's Licence No. 41016		
Business Address (Street Number/Name) 215154 10th Line, R.R. #1	Municipality Grand Valley, Ontario		
Province ON	Postal Code L0N 1G0	Business E-mail Address	
Bus. Telephone No. (inc. area code)	Name of Well Technician (Last Name, First Name) Steve Gerrits		
Well Technician's Licence No.	Signature of Technician and/or Contractor	Date Submitted 8/14/16	

Results of Well Yield Testing			
After test of well yield, water was: ☐ Clear and sand free ☐ Other, specify		Draw Down Time (min)	Recovery Time (min)
If pumping discontinued, give reason:		Water Level (m/ft)	Water Level (m/ft)
Pump intake set at (m/ft)		Static Level	
Pumping rate (l/min / GPM)		1	1
Duration of pumping hrs + min		2	2
Final water level end of pumping (m/ft)		3	3
If flowing give rate (l/min / GPM)		4	4
Recommended pump depth (m/ft)		5	5
Recommended pump rate (l/min / GPM)		10	10
Well production (l/min / GPM)		15	15
Disinfected? ☒ Yes ☐ No		20	20
		25	25
		30	30
		40	40
		50	50
		60	60

Map of Well Location	
Please provide a map below following instructions on the back. See Attached	
Comments:	
Well owner's information package delivered ☒ Yes ☐ No	Date Package Delivered 8/14/16 Date Work Completed 8/14/16
Ministry Use Only Audit No. 2110398 Received	



Measurements recorded in: ☒ Metric ☐ Imperial

Page of

Well Owner's Information

First Name	Last Name / Organization	E-mail Address	☐ Well Constructed by Well Owner	
GRCA				
Mailing Address (Street Number/Name)	Municipality	Province	Postal Code	Telephone No. (inc. area code)
400 Clyde RD PO Box 729	Cambridge	ON	N1R 5W6	

Well Location

Address of Well Location (Street Number/Name)	Township	Lot	Concession			
County/District/Municipality	City/Town/Village	Province	Postal Code			
		Ontario				
UTM Coordinates	Zone	Easting	Northing	Municipal Plan and Sublot Number	Other	
NAD	8	3	1	560656	4246464	

Overburden and Bedrock Materials/Abandonment Sealing Record (see instructions on the back of this form)

General Colour	Most Common Material	Other Materials	General Description	Depth (m/ft)	From	To
Brown	sand			0		3.05
Grey	silt	sand		3.05		9.75
Brown	sand	gravel		9.75		10.67

Annular Space			
Depth Set at (m/ft)	Type of Sealant Used (Material and Type)	Volume Placed (m³/ft³)	
From	To		
	See Attached Diagram		

Method of Construction	Well Use
☐ Cable Tool ☒ Rotary (Conventional) ☐ Rotary (Reverse) ☐ Boring ☐ Air percussion ☐ Other, specify	☐ Diamond ☐ Jetting ☐ Driving ☐ Digging ☐ Public ☐ Domestic ☐ Livestock ☐ Irrigation ☐ Industrial ☐ Other, specify
☐ Commercial ☐ Municipal ☐ Test Hole ☐ Cooling & Air Conditioning ☐ Not used ☐ Dewatering ☒ Monitoring	

Construction Record - Casing				Status of Well	
Inside Diameter (cm/in)	Open Hole OR Material (Galvanized, Fibreglass, Concrete, Plastic, Steel)	Wall Thickness (cm/in)	Depth (m/ft)	From	To
3.17	Plastic	sch 40	+ .45		9.14

☐ Water Supply ☐ Replacement Well ☐ Test Hole ☐ Recharge Well ☐ Dewatering Well ☒ Observation and/or Monitoring Hole ☐ Alteration (Construction) ☐ Abandoned, Insufficient Supply ☐ Abandoned, Poor Water Quality ☐ Abandoned, other, specify ☐ Other, specify
--

Construction Record - Screen				Status of Well	
Outside Diameter (cm/in)	Material (Plastic, Galvanized, Steel)	Slot No.	Depth (m/ft)	From	To
3.34	Plastic	10	9.14		10.67

☐ Other, specify

Water Details		Hole Diameter	
Water found at Depth	Kind of Water: ☐ Fresh ☒ Untested	Depth (m/ft)	Diameter (cm/in)
8.5 (m/ft) ☐ Gas ☐ Other, specify		From	To
		0	10.67
Water found at Depth	Kind of Water: ☐ Fresh ☐ Untested		
(m/ft) ☐ Gas ☐ Other, specify			
Water found at Depth	Kind of Water: ☐ Fresh ☐ Untested		
(m/ft) ☐ Gas ☐ Other, specify			

Well Contractor and Well Technician Information			
Business Name of Well Contractor	Well Contractor's Licence No.		
Gerrits Drilling & Eng. Ltd.	3 4 0 6		
Business Address (Street Number/Name)	Municipality		
RR #1 Grand Valley			
Province	Postal Code	Business E-mail Address	
ON	L9N 1G0		
Bus. Telephone No. (inc. area code)	Name of Well Technician (Last Name, First Name)		
	Gerrits, Steve		
Well Technician's Licence No.	Signature of Technician and/or Contractor	Date Submitted	
2 9 6 4		7/10/08	

Results of Well Yield Testing			
After test of well yield, water was:		Draw Down	
☐ Clear and sand free ☐ Other, specify		Time (min)	Water Level (m/ft)
If pumping discontinued, give reason:		Time (min)	Recovery Water Level (m/ft)
		Static Level	
Pump intake set at (m/ft)		1	1
Pumping rate (l/min / GPM)		2	2
Duration of pumping		3	3
hrs + min		4	4
Final water level end of pumping (m/ft)		5	5
If flowing give rate (l/min / GPM)		10	10
Recommended pump depth (m/ft)		15	15
Recommended pump rate (l/min / GPM)		20	20
Well production (l/min / GPM)		25	25
Disinfected?		30	30
☒ Yes ☐ No		40	40
		50	50
		60	60

Map of Well Location	
Please provide a map below following instructions on the back.	
Comments:	
Area 5	
Well owner's information package delivered	Date Package Delivered
☒ Yes ☐ No	2/10/08
Date Work Completed	
	2/10/08
Ministry Use Only	
Audit No.	Z 84488
Received	



Measurements recorded in: ☒ Metric ☐ Imperial

Page of

Well Owner's Information

First Name GRCA	Last Name / Organization	E-mail Address	☐ Well Constructed by Well Owner
Mailing Address (Street Number/Name) 400 Clyde Rd		Municipality Cambridge	Province ON
		Postal Code N1E5W6	Telephone No. (inc. area code)

Well Location

Address of Well Location (Street Number/Name)		Township Eramosa	Lot 11	Concession 7
County/District/Municipality Wellington		City/Town/Village	Province Ontario	Postal Code
UTM Coordinates Zone NAD 83	Easting 1756627541834621	Northings	Municipal Plan and Sublot Number	
		Other		

Overburden and Bedrock Materials/Abandonment Sealing Record (see instructions on the back of this form)

General Colour	Most Common Material	Other Materials	General Description	Depth (m/ft) From	To
Brown	Sand	Soft mud		0	1.06
Grey	Limestone			1.06	53.94
Grey/brown	Shale			53.94	57.70

Annular Space			
Depth Set at (m/ft) From		Type of Sealant Used (Material and Type)	Volume Placed (m³/ft³)
		see attached	

Method of Construction	Well Use
☐ Cable Tool ☐ Rotary (Conventional) ☐ Rotary (Reverse) ☐ Boring ☐ Air percussion ☒ Other, specify Percussion	☐ Public ☐ Domestic ☐ Livestock ☐ Irrigation ☐ Industrial ☐ Other, specify
☐ Diamond ☐ Jetting ☐ Driving ☐ Digging	☐ Commercial ☐ Municipal ☒ Test Hole ☐ Cooling & Air Conditioning ☐ Not used ☐ Dewatering ☒ Monitoring

Construction Record - Casing				Status of Well	
Inside Diameter (cm/in)	Open Hole OR Material (Galvanized, Fibreglass, Concrete, Plastic, Steel)	Wall Thickness (cm/in)	Depth (m/ft) From To		
12.7	Steel	0.219	0.50	12.20	☐ Water Supply ☐ Replacement Well ☐ Test Hole ☐ Recharge Well ☐ Dewatering Well ☒ Observation and/or Monitoring Hole ☐ Alteration (Construction) ☐ Abandoned, Insufficient Supply ☐ Abandoned, Poor Water Quality ☐ Abandoned, other, specify ☐ Other, specify
12.2			1.20	57.70	

Construction Record - Screen			
Outside Diameter (cm/in)	Material (Plastic, Galvanized, Steel)	Slot No.	Depth (m/ft) From To

Water Details		Hole Diameter	
Water found at Depth (m/ft) ☐ Gas ☐ Other, specify	Kind of Water: ☐ Fresh ☐ Untested	Depth (m/ft) From To	Diameter (cm/in)
Water found at Depth (m/ft) ☐ Gas ☐ Other, specify	Kind of Water: ☐ Fresh ☐ Untested	0 1.20	12.7
Water found at Depth (m/ft) ☐ Gas ☐ Other, specify	Kind of Water: ☐ Fresh ☐ Untested	1.20 57.70	12.2

Well Contractor and Well Technician Information			
Business Name of Well Contractor Gerrits Drilling & Engineering Ltd.		Well Contractor's Licence No. 341016	
Business Address (Street Number/Name) 215154 10th Line, R.R. #1		Municipality Grand Valley, Ontario	
Province ON	Postal Code N1A 1G0	Business E-mail Address	
Bus. Telephone No. (inc. area code)		Name of Well Technician (Last Name, First Name)	
Well Technician's Licence No.		Signature of Technician and/or Contractor	
2191614		Date Submitted 7/19/07	

Results of Well Yield Testing			
After test of well yield, water was: ☐ Clear and sand free ☐ Other, specify		Draw Down	
If pumping discontinued, give reason:		Time (min)	Water Level (m/ft)
Pump intake set at (m/ft)		Static Level	Recovery
Pumping rate (l/min / GPM)		1	1
Duration of pumping hrs + min		2	2
Final water level end of pumping (m/ft)		3	3
If flowing give rate (l/min / GPM)		4	4
Recommended pump depth (m/ft)		5	5
Recommended pump rate (l/min / GPM)		10	10
Well production (l/min / GPM)		15	15
Disinfected? ☒ Yes ☐ No		20	20
		25	25
		30	30
		40	40
		50	50
		60	60

Map of Well Location	
Please provide a map below following instructions on the back.	
see attached	
Comments:	
Well owner's information package delivered ☐ Yes ☐ No	Date Package Delivered 7/19/07
Date Work Completed 7/19/07	Ministry Use Only Audit No. 2110397 Received



Measurements recorded in: ☒ Metric ☐ Imperial

A051674

Page _____ of _____

Well Owner's Information

First Name GRCA	Last Name / Organization	E-mail Address	☐ Well Constructed by Well Owner
Mailing Address (Street Number/Name) 400 Clyde Rd. PO Box 729	Municipality Cambridge	Province ON	Postal Code N1R 5W6
Telephone No. (inc. area code)			

Well Location

Address of Well Location (Street Number/Name)		Township Eramosa	Lot 9	Concession 1
County/District/Municipality Wellington		City/Town/Village	Province Ontario	Postal Code
UTM Coordinates NAD 83	Zone 17	Easting 564581	Northing 4828350	Municipal Plan and Sublot Number
				Other

Overburden and Bedrock Materials/Abandonment Sealing Record (see instructions on the back of this form)

General Colour	Most Common Material	Other Materials	General Description	Depth (m/ft) From	Depth (m/ft) To
Black	Loam			0	0.61
Brown	Sand		Fine	0.61	7.92
Brown	Sand	Gravel, Silt	Fine	7.92	13.41

Annular Space			
Depth Set at (m/ft) From	Depth Set at (m/ft) To	Type of Sealant Used (Material and Type)	Volume Placed (m ³ /ft ³)
		See Attached	

Method of Construction		Well Use	
☐ Cable Tool	☐ Diamond	☐ Public	☐ Commercial
☒ Rotary (Conventional)	☐ Jetting	☐ Domestic	☐ Municipal
☐ Rotary (Reverse)	☐ Driving	☐ Livestock	☒ Test Hole
☐ Boring	☐ Digging	☐ Irrigation	☐ Cooling & Air Conditioning
☐ Air percussion		☐ Industrial	
☐ Other, specify		☐ Other, specify	

Construction Record - Casing				Status of Well	
Inside Diameter (cm/in)	Open Hole OR Material (Galvanized, Fibreglass, Concrete, Plastic, Steel)	Wall Thickness (cm/in)	Depth (m/ft) From	Depth (m/ft) To	
					☐ Water Supply
					☐ Replacement Well
					☐ Test Hole
					☐ Recharge Well
					☐ Dewatering Well
					☒ Observation and/or Monitoring Hole
					☐ Alteration (Construction)
					☐ Abandoned, Insufficient Supply
					☐ Abandoned, Poor Water Quality
					☐ Abandoned, other, specify
					☐ Other, specify

Construction Record - Screen			
Outside Diameter (cm/in)	Material (Plastic, Galvanized, Steel)	Slot No.	Depth (m/ft) From
12x2x			To

Water Details		Hole Diameter	
Water found at Depth 12.2 (m/ft)	Kind of Water: ☐ Fresh ☒ Untested	Depth (m/ft) From	Depth (m/ft) To
	☐ Gas ☐ Other, specify	0	13.41
Water found at Depth (m/ft)	Kind of Water: ☐ Fresh ☐ Untested		15.24
	☐ Gas ☐ Other, specify		
Water found at Depth (m/ft)	Kind of Water: ☐ Fresh ☐ Untested		
	☐ Gas ☐ Other, specify		

Well Contractor and Well Technician Information			
Business Name of Well Contractor Gerrits Drilling 7 Eng. Ltd.		Well Contractor's Licence No. 3 4 0 6	
Business Address (Street Number/Name) RR #1 Grand Valley		Municipality	
Province ON	Postal Code L0N 1G0	Business E-mail Address	
Bus. Telephone No. (inc. area code)		Name of Well Technician (Last Name, First Name) Gerrits, Chris	
Well Technician's Licence No. 2 7 3 8		Signature of Technician and/or Contractor Chris Gerrits	
		Date Submitted 2008 10 01	

Results of Well Yield Testing				
After test of well yield, water was: ☐ Clear and sand free ☐ Other, <i>specify</i>	Draw Down		Recovery	
	Time (min)	Water Level (m/ft)	Time (min)	Water Level (m/ft)
If pumping discontinued, give reason:	Static Level			
	1		1	
Pump intake set at (m/ft)	2		2	
Pumping rate (l/min / GPM)	3		3	
	4		4	
Duration of pumping ____ hrs + ____ min	5		5	
Final water level end of pumping (m/ft)	10		10	
If flowing give rate (l/min-/ GPM)	15		15	
	20		20	
Recommended pump depth (m/ft)	25		25	
	30		30	
Recommended pump rate (l/min / GPM)	40		40	
Well production (l/min / GPM)	50		50	
	60		60	
Disinfected? ☐ Yes ☐ No				

Map of Well Location	
Please provide a map below following instructions on the back.	
Comments: Area 7 shallow	
Well owner's information package delivered ☒ Yes ☐ No	Date Package Delivered 2008 Y 10 M 01 D
Date Work Completed 2008 Y 10 M 01 D	Ministry Use Only Audit No. Z 84517
Received	



Well Owner's Information

First Name XXXX XXXXXXX	Last Name G R C A	E-mail Address	☐ Well Constructed by Well Owner
Mailing Address (Street Number/Name, RR) 400 Apple Road Box 729	Municipality Cambridge	Province Ontario	Postal Code N1A 8X1
Telephone No. (inc. area code)			

Part A Construction and/or Major Alteration of a Well

Address of Well Location (Street Number/Name, RR) Kaine Hill Drive		Township Guelph	Lot 5	Concession 7
County/District/Municipality Wellington		City/Town/Village Guelph	Province Ontario	Postal Code
UTM Coordinates NAD 83	Zone 18	Easting 756094	Northing 44826609	GPS Unit Make Magellan
Model		Mode of Operation: ☐ Undifferentiated ☒ Averaged ☐ Differentiated, specify		

Overburden and Bedrock Materials (see instructions on the back of this form)

General Colour	Most Common Material	Other Materials	General Description	Depth (Metres) From	Depth (Metres) To
Brown	Sand			0	1.52
Grey	Clay			1.52	4.57
Grey	Silt	Clay and Stones	Till	4.57	14.63
Brown	Sand	Gravel		14.63	15.97
Brown/Grey	Limestone	Dolostone	Layers	15.97	75.59
Green	Shale			75.59	76.20

Annular Space/Abandonment Sealing Record

Depth Set at (Metres) From	Depth Set at (Metres) To	Type of Sealant Used (Material and Type)	Volume Placed (Cubic Metres)
0	6.1	Bentonite Slurry	0.05

Results of Well Yield Testing

Check box if after test of well yield, water was:		Draw Down		Recovery	
☒ Clear and sand free ☐ Cannot develop to sand-free state		Time (Min)	Water Level (Metres)	Time (Min)	Water Level (Metres)
If pumping discontinued, give reason:		Static Level	11.81	Static Level	21.12
Pumping test method pump		1	14.84	1	17.91
Pump intake set at (Metres) 51.816		2	15.23	2	17.84
Pumping rate (Litres/min) 170.34		3	15.41	3	17.72
Duration of pumping 4 hrs + 0 min		4	15.52	4	17.59
Final water level end of pumping (Metres) 21.12		5	15.61	5	17.54
Recommended pump type ☐ Shallow ☒ Deep		10	15.935	10	17.26
Recommended pump depth 51.816 Metres		15	16.23	15	17.03
Recommended pump rate (Litres/min) 170.34		20	16.43	20	16.825
If flowing give rate (Litres/min)		25	16.615	25	14.03
		30	16.76	30	13.92
		40	17.02	40	13.69
		50	17.255	50	13.52
		60	17.44	60	13.34

Method of Construction


☐ Cable Tool ☒ Rotary (Conventional) ☒ Rotary (Reverse) ☐ Rotary (Air) ☐ Air percussion ☐ Other, specify	☐ Diamond ☐ Jetting ☐ Driving ☐ Digging ☐ Boring ☐ Other, specify	☐ Public ☐ Domestic ☐ Livestock ☐ Irrigation ☐ Industrial ☐ Other, specify	☐ Commercial ☐ Municipal ☐ Test Hole ☐ Cooling & Air Conditioning ☒ Not used ☐ Dewatering ☒ Monitoring
---	--	---	---

Status of Well

☐ Water Supply ☐ Replacement Well ☐ Test Hole ☐ Recharge Well	☐ Dewatering Well ☐ Abandoned, Insufficient Supply ☐ Abandoned, Poor Water Quality ☐ Abandoned, other, specify	☒ Observation and/or Monitoring Hole ☐ Alteration (Construction) ☐ Other, specify
--	---	---

Location of Well

Please provide a map below showing:
- all property boundaries, and measurements sufficient to locate the well in relation to fixed points,
- an arrow indicating the North direction
- detailed drawings can be provided as attachments no larger than legal size (8.5" by 14")
- vidigital pictures of inside of well can also be provided

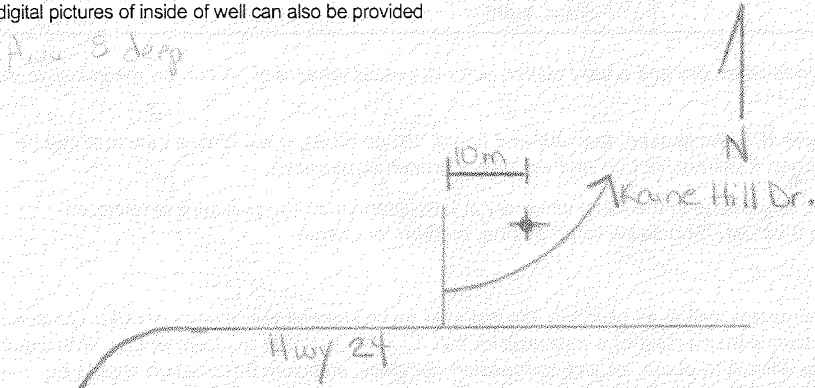

Date Well Completed (yyyy/mm/dd) 2008/07/11	Was the well owner's information package delivered? ☒ Yes ☐ No	Date the Well Record and Package Delivered to Well Owner (yyyy/mm/dd) 2008/07/12 mail
--	--	--

Well Contractor and Well Technician Information

Business Name of Well Contractor Gerrits Drilling & Eng. Ltd.		Well Contractor's Licence No. 3 4 0 6
Business Address (Street No./Name, number, RR) RR#1 Grand Valley		Municipality
Province Ontario	Postal Code L0N 1G0	Business E-mail Address
Bus.Telephone No. (inc. area code)		Name of Well Technician (Last Name, First Name) Gerrits, Steve
Well Technician's Licence No. 2 9 6 4	Signature of Technician <i>[Signature]</i>	Date Submitted (yyyy/mm/dd) 2008/07/12

Water Details

Water found at Depth 2 3 Metres	Kind of Water ☐ Gas ☒ Fresh ☐ Salty ☐ Sulphur ☐ Minerals
Water found at Depth 3 6 Metres	Kind of Water ☐ Gas ☒ Fresh ☐ Salty ☐ Sulphur ☐ Minerals
Water found at Depth 4 5 Metres	Kind of Water ☐ Gas ☒ Fresh ☐ Salty ☐ Sulphur ☐ Minerals

Casing Used

☐ Galvanized ☒ Steel ☐ Fibreglass ☐ Plastic ☐ Concrete
--

Screen Used

☐ Galvanized ☐ Steel ☐ Fibreglass ☐ Plastic ☐ Concrete

Casing and Well Details

Diameter of the Hole (Centimetres) 15.24
Depth of the Hole (Metres) 76.20
Wall Thickness (Metres) 0.477cm
Inside Diameter of the Casing (Metres) 15.24cm
Depth of the Casing (Metres) 16.76

No Casing and Screen Used

☒ Open Hole
Disinfected? ☒ Yes ☐ No

Ministry Use Only

Audit No. 275948	Well Contractor No.
Date Received (yyyy/mm/dd)	Date of Inspection (yyyy/mm/dd)
Remarks	

Well Owner's Information

First Name: GRCA Last Name: E-mail Address: Well Constructed by Well Owner: Mailing Address (Street Number/Name, RR): 400 Clyde Road PO Box 729 Municipality: Cambridge Province: ON Postal Code: N1R5W6 Telephone No. (inc. area code):

Part A Construction and/or Major Alteration of a Well

Address of Well Location (Street Number/Name, RR): Kaine Hill Drive Township: Guelph Lot: 5 Concession: 7 County/District/Municipality: Wellington City/Town/Village: Province: Ontario Postal Code: UTM Coordinates: Zone: Easting: Northing: GPS Unit Make: Model: Mode of Operation: Undifferentiated Averaged Differentiated, specify:


Overburden and Bedrock Materials (see instructions on the back of this form)

General Colour	Most Common Material	Other Materials	General Description	Depth From	Depth To
Brown	Sand			0	1.52
Grey	Clay			1.52	4.57
Grey	Silt	Clay and stones		4.57	14.63
Brown	Sand	Gravel	Course	14.63	15.97

Annular Space/Abandonment Sealing Record			
Depth Set at (Metres) From	To	Type of Sealant Used (Material and Type)	Volume Placed (Cubic Metres)
		See Attached	

Method of Construction: Cable Tool, Rotary (Conventional), Rotary (Reverse), Rotary (Air), Air percussion, Other, specify. Water Use: Public, Commercial, Not used, Domestic, Municipal, Dewatering, Livestock, Test Hole, Monitoring, Irrigation, Cooling & Air Conditioning, Industrial, Other, specify. Status of Well: Water Supply, Replacement Well, Test Hole, Recharge Well, Dewatering Well, Abandoned, Insufficient Supply, Abandoned, Poor Water Quality, Abandoned, other, specify, Observation and/or Monitoring Hole, Alteration (Construction), Other, specify.

Location of Well: Please provide a map below showing: - all property boundaries, and measurements sufficient to locate the well in relation to fixed points, - an arrow indicating the North direction, - detailed drawings can be provided as attachments no larger than legal size (8.5" by 14"), - digital pictures of inside of well can also be provided.

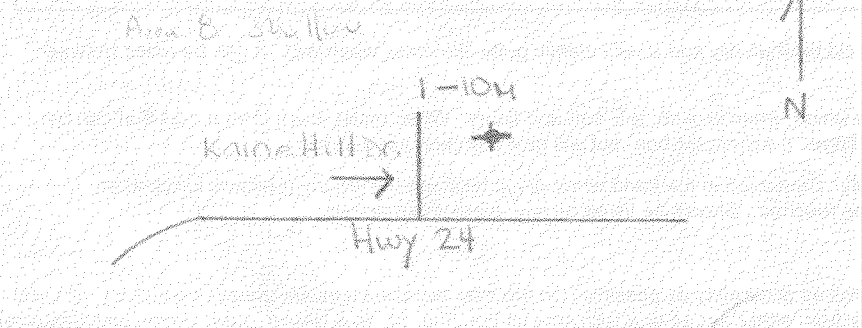

Date Well Completed (yyyy/mm/dd): 2008/07/11 Was the well owner's information package delivered? Yes No Date the Well Record and Package Delivered to Well Owner (yyyy/mm/dd): 2008/07/11

Well Contractor and Well Technician Information: Business Name of Well Contractor: Gerrits Drilling & Eng. Ltd. Well Contractor's Licence No.: 3406 Business Address (Street No./Name, number, RR): RR#1 Grand Valley Municipality: Province: Ontario Postal Code: L9N 1G0 Business E-mail Address: Bus. Telephone No. (inc. area code): Name of Well Technician (Last Name, First Name): Gerrits, Steve Well Technician's Licence No.: Signature of Technician: Date Submitted (yyyy/mm/dd): 2008/07/11

Results of Well Yield Testing				
Check box if after test of well yield, water was: ☒ Clear and sand free ☐ Cannot develop to sand-free state	Draw Down		Recovery	
	Time (Min)	Water Level (Metres)	Time (Min)	Water Level (Metres)
If pumping discontinued, give reason:	Static Level		Static Level	
	1		1	
Pumping test method	2		2	
Pump intake set at (Metres)	3		3	
Pumping rate (Litres/min)	4		4	
Duration of pumping _____ hrs + _____ min	5		5	
Final water level end of pumping (Metres)	10		10	
	15		15	
Recommended pump type ☐ Shallow ☐ Deep	20		20	
	25		25	
Recommended pump depth _____ Metres	30		30	
Recommended pump rate (Litres/min)	40		40	
	50		50	
If flowing give rate (Litres/min)	60		60	

Water Details	
Water found at Depth: 1.52 Metres ☐ Gas ☒ Fresh ☒ Salty ☐ Sulphur ☐ Minerals	Kind of Water: NOT TESTED
Water found at Depth: Metres ☐ Gas ☐ Fresh ☐ Salty ☐ Sulphur ☐ Minerals	Kind of Water:
Water found at Depth: Metres ☐ Gas ☐ Fresh ☐ Salty ☐ Sulphur ☐ Minerals	Kind of Water:

Casing Used: Galvanized, Steel, Fibreglass, Plastic, Concrete. Screen Used: Galvanized, Steel, Fibreglass, Plastic, Concrete. Casing and Well Details: Diameter of the Hole (Centimetres): 15.24 Depth of the Hole (Metres): 15.97 Wall Thickness (Metres): Schedule 40 Inside Diameter of the Casing (Metres): 3.17cm Depth of the Casing (Metres): 14.32 No Casing and Screen Used: Open Hole. Disinfected? Yes No

Ministry Use Only: Audit No.: 275950 Well Contractor No.: Date Received (yyyy/mm/dd): Date of Inspection (yyyy/mm/dd): Remarks:



Ministry of
the Environment

Well

AO56849

Print Below)

MW08 - T3 - 09 - 0B

Well Record

Regulation 903 Ontario Water Resources Act

Measurements recorded in: ☒ Metric ☐ Imperial

Page 1 of 1

Well Owner's Information

First Name GRC	Last Name / Organization	E-mail Address	☐ Well Constructed by Well Owner
Mailing Address (Street Number/Name) 4160 Clyde Rd	Municipality Cambridge	Province ON	Postal Code N1H 5W6
Telephone No. (inc. area code)			

Well Location

Address of Well Location (Street Number/Name) Wellington	Township Puslinch	Lot 14	Concession 11
County/District/Municipality	City/Town/Village	Province Ontario	Postal Code
UTM Coordinates NAD 83	Zone 17	Easting 571064	Northing 481400614
Municipal Plan and Sublot Number		Other	

Overburden and Bedrock Materials/Abandonment Sealing Record (see instructions on the back of this form)

General Colour	Most Common Material	Other Materials	General Description	Depth (m/ft) From	To
Brown	Sand	Silt			
Brown	Sand	Gravel		0	6.10
				6.10	11.00

Annular Space			
Depth Set at (m/ft) From	To	Type of Sealant Used (Material and Type)	Volume Placed (m³/ft³)
		See Attached	

Method of Construction		Well Use	
☐ Cable Tool	☐ Diamond	☐ Public	☐ Commercial
☒ Rotary (Conventional)	☐ Jetting	☐ Domestic	☐ Not used
☐ Rotary (Reverse)	☐ Driving	☐ Livestock	☐ Dewatering
☐ Boring	☐ Digging	☐ Irrigation	☒ Test Hole
☐ Air percussion		☐ Industrial	☐ Monitoring
☐ Other, specify		☐ Cooling & Air Conditioning	

Construction Record - Casing					Status of Well	
Inside Diameter (cm/in)	Open Hole OR Material (Galvanized, Fibreglass, Concrete, Plastic, Steel)	Wall Thickness (cm/in)	Depth (m/ft)			
			From	To		
	See Attached				☐ Water Supply	
					☐ Replacement Well	
					☐ Test Hole	
					☐ Recharge Well	
					☐ Dewatering Well	
					☐ Observation and/or Monitoring Hole	
					☐ Alteration (Construction)	
					☐ Abandoned, Insufficient Supply	
					☐ Abandoned, Poor Water Quality	
					☐ Abandoned, other, specify	
					☐ Other, specify	

Construction Record - Screen				
Outside Diameter (cm/in)	Material (Plastic, Galvanized, Steel)	Slot No.	Depth (m/ft)	
			From	To
	See Attached			

Water Details		Hole Diameter	
Water found at Depth (m/ft) ☐ Gas ☐ Other, specify	Kind of Water: ☐ Fresh ☐ Untested	Depth (m/ft) From	To
Water found at Depth (m/ft) ☐ Gas ☐ Other, specify	Kind of Water: ☐ Fresh ☐ Untested	0	11.00
Water found at Depth (m/ft) ☐ Gas ☐ Other, specify	Kind of Water: ☐ Fresh ☐ Untested		15.7

Business Name of Well Contractor Gerrits Drilling & Engineering Ltd.		Well Contractor's Licence No. 394106
Business Address (Street Number/Name) #1 Grand Valley, Ontario L0N 1G0		Municipality
Province	Postal Code	Business E-mail Address

Bus. Telephone No. (inc. area code)	Name of Well Technician (Last Name, First Name) Eric Gerrits	
Well Technician's Licence No.	Signature of Technician and/or Contractor	Date Submitted 10/09/06

Results of Well Yield Testing				
After test of well yield, water was: ☐ Clear and sand free ☐ Other, <i>specify</i> _____	Draw Down		Recovery	
	Time (min)	Water Level (m/ft)	Time (min)	Water Level (m/ft)
If pumping discontinued, give reason: _____	Static Level			
	1		1	
Pump intake set at (m/ft) _____	2		2	
Pumping rate (l/min / GPM) _____	3		3	
Duration of pumping _____ hrs + _____ min	4		4	
	5		5	
Final water level end of pumping (m/ft) _____	10		10	
If flowing give rate (l/min / GPM) _____	15		15	
	20		20	
Recommended pump depth (m/ft) _____	25		25	
	30		30	
Recommended pump rate (l/min / GPM) _____	40		40	
	50		50	
Well production (l/min / GPM) _____	60		60	
Disinfected? ☐ Yes ☐ No				

Map of Well Location	
Please provide a map below following instructions on the back.	
See Attached	
Comments:	
Well owner's information package delivered ☒ Yes ☐ No	Date Package Delivered 10/09/06
Date Work Completed 10/09/06	Ministry Use Only
	Audit No. 2110395
	Received



Measurements recorded in: ☒ Metric ☐ Imperial

Page 1 of 1

Well Owner's Information

First Name GRCA	Last Name / Organization	E-mail Address	☐ Well Constructed by Well Owner
Mailing Address (Street Number/Name) 400 Clyde Road PO Box 709	Municipality Cambridge	Province ON	Postal Code N1R5W6
Telephone No. (inc. area code)			

Well Location

Address of Well Location (Street Number/Name) Vance Tract	Township Puslinch	Lot 16	Concession 3
County/District/Municipality Wellington	City/Town/Village	Province Ontario	Postal Code
UTM Coordinates NAD 83 17 56 31 69 48 12 507	Municipal Plan and Sublot Number		Other

Overburden and Bedrock Materials/Abandonment Sealing Record (see instructions on the back of this form)

General Colour	Most Common Material	Other Materials	General Description	Depth (m/ft) From	To
Brown	Sand	Boulders		0	3.05
Brown	sand		wet	3.05	15.24
Grey	clay	silt		15.24	24.99
Brown	sand	silt		24.99	33.52
Brown	gravel	sand	coarse	33.52	33.96

Annular Space		
Depth Set at (m/ft) From	To	Type of Sealant Used (Material and Type)
		Volume Placed (m³/ft³)
		See attached diagram

Method of Construction	Well Use
☐ Cable Tool ☒ Rotary (Conventional) ☐ Rotary (Reverse) ☐ Boring ☐ Air percussion ☐ Other, specify	☐ Diamond ☐ Jetting ☐ Driving ☐ Digging ☐ Public ☐ Domestic ☐ Livestock ☐ Irrigation ☐ Industrial ☐ Other, specify
☐ Commercial ☐ Municipal ☐ Test Hole ☐ Cooling & Air Conditioning	☐ Not used ☐ Dewatering ☒ Monitoring

Construction Record - Casing				Status of Well	
Inside Diameter (cm/in)	Open Hole OR Material (Galvanized, Fibreglass, Concrete, Plastic, Steel)	Wall Thickness (cm/in)	Depth (m/ft) From	To	
3.17		Sch 40	0.60	33.83	☐ Water Supply ☐ Replacement Well ☐ Test Hole ☐ Recharge Well ☐ Dewatering Well ☒ Observation and/or Monitoring Hole ☐ Alteration (Construction) ☐ Abandoned, Insufficient Supply ☐ Abandoned, Poor Water Quality ☐ Abandoned, other, specify ☐ Other, specify

Construction Record - Screen			
Outside Diameter (cm/in)	Material (Plastic, Galvanized, Steel)	Slot No.	Depth (m/ft) From
4.21	Plastic		33.83
			35.30

Water Details		Hole Diameter	
Water found at Depth (m/ft)	Kind of Water: ☐ Fresh ☒ Untested	Depth (m/ft) From	To
33	☐ Gas ☐ Other, specify	0	33.96
			15.71
Water found at Depth (m/ft)	Kind of Water: ☐ Fresh ☐ Untested		
	☐ Gas ☐ Other, specify		
Water found at Depth (m/ft)	Kind of Water: ☐ Fresh ☐ Untested		
	☐ Gas ☐ Other, specify		

Well Contractor and Well Technician Information			
Business Name of Well Contractor Gerrits Drilling & Eng. Ltd.	Well Contractor's Licence No. 3 4 0 6		
Business Address (Street Number/Name) RR#1 Grand Valley	Municipality		
Province ON	Postal Code L0N 1G0	Business E-mail Address	
Bus. Telephone No. (inc. area code)	Name of Well Technician (Last Name, First Name) Steve Gerrits		
Well Technician's Licence No. 2 9 6 4	Signature of Technician and/or Contractor		Date Submitted 20080733

Results of Well Yield Testing			
After test of well yield, water was: ☒ Clear and sand free ☐ Other, specify	Draw Down		Recovery
	Time (min)	Water Level (m/ft)	Time (min)
If pumping discontinued, give reason:	Static Level		Water Level (m/ft)
	1		1
Pump intake set at (m/ft)	2		2
Pumping rate (l/min / GPM)	3		3
Duration of pumping hrs + min	4		4
Final water level end of pumping (m/ft)	5		5
If flowing give rate (l/min / GPM)	10		10
Recommended pump depth (m/ft)	15		15
Recommended pump rate (l/min / GPM)	20		20
Well production (l/min / GPM)	25		25
Disinfected? ☒ Yes ☐ No	30		30
	40		40
	50		50
	60		60

Map of Well Location
Please provide a map below following instructions on the back.

Comments: Area 10 shallow	Well owner's information package delivered ☒ Yes ☐ No	Date Package Delivered 20080733	Date Work Completed 20080733
Ministry Use Only		Audit No. 2 84498	Received



Well Owner's Information

First Name GRCA	Last Name / Organization	E-mail Address	☐ Well Constructed by Well Owner
Mailing Address (Street Number/Name) 400 Clyde Road P.O. Box 729 Cambridge	Municipality ON	Postal Code N1R5W6	Telephone No. (inc. area code)

Well Location

Address of Well Location (Street Number/Name) Vance Tract	Township Puslinch	Lot 16	Concession 3
County/District/Municipality Wellington	City/Town/Village	Province Ontario	Postal Code
UTM Coordinates NAD 83 17 56 3 190 48 12 531	Municipal Plan and Sublot Number	Other	

Overburden and Bedrock Materials/Abandonment Sealing Record (see instructions on the back of this form)

General Colour	Most Common Material	Other Materials	General Description	Depth (m/ft) From	To
Brown	sand	boulders		0	1.52
Brown	sand	gravel		1.52	15.24
Brown	sand	gravel & silt		15.24	17.37
Grey	silt	clay		17.37	19.81
Brown	sand	silt		19.81	35.66
Grey	silt	clay & gravel		35.66	38.10
Brown/grey	Limestone & dolostone layers			38.10	105.16
Green	shale			105.16	105.46

Annular Space			
Depth Set at (m/ft) From	To	Type of Sealant Used (Material and Type)	Volume Placed (m³/ft³)
0	61	Grout with string	0.05

Method of Construction		Well Use	
☐ Cable Tool	☐ Diamond	☐ Public	☐ Commercial
☒ Rotary (Conventional)	☐ Jetting	☐ Domestic	☐ Municipal
☐ Rotary (Reverse)	☐ Driving	☐ Livestock	☐ Test Hole
☐ Boring	☐ Digging	☐ Irrigation	☐ Cooling & Air Conditioning
☐ Air percussion		☐ Industrial	
☐ Other, specify		☐ Other, specify	

Construction Record - Casing				Status of Well	
Inside Diameter (cm/in)	Open Hole OR Material (Galvanized, Fibreglass, Concrete, Plastic, Steel)	Wall Thickness (cm/in)	Depth (m/ft) From	To	
15.24		0.477	0.50	39.10	☐ Water Supply
	open hole		39.10	105.46	☐ Replacement Well
					☐ Test Hole
					☐ Recharge Well
					☐ Dewatering Well
					☒ Observation and/or Monitoring Hole
					☐ Alteration (Construction)
					☐ Abandoned, Insufficient Supply
					☐ Abandoned, Poor Water Quality
					☐ Abandoned, other, specify
					☐ Other, specify

Construction Record - Screen				
Outside Diameter (cm/in)	Material (Plastic, Galvanized, Steel)	Slot No.	Depth (m/ft) From	To

Water Details		Hole Diameter		
Water found at Depth 40 (m/ft)	Kind of Water: ☐ Fresh ☒ Untested	Depth (m/ft) From	To	Diameter (cm/in)
	☐ Gas ☐ Other, specify	0	39.1	15.71
Water found at Depth 51 (m/ft)	Kind of Water: ☐ Fresh ☒ Untested			
	☐ Gas ☐ Other, specify			
Water found at Depth 82 (m/ft)	Kind of Water: ☐ Fresh ☒ Untested			
	☐ Gas ☐ Other, specify			

Well Contractor and Well Technician Information			
Business Name of Well Contractor Gerrits Drilling & Eng. Ltd.		Well Contractor's Licence No. 3 4 0 6	
Business Address (Street Number/Name) RR#1 Grand Valley		Municipality	
Province ON	Postal Code L0N 1G0	Business E-mail Address	
Bus. Telephone No. (inc. area code)	Name of Well Technician (Last Name, First Name) Gerrits, Steve		
Well Technician's Licence No. 2 9 8 4	Signature of Technician and/or Contractor		Date Submitted 20080723

Results of Well Yield Testing				
After test of well yield, water was: ☒ Clear and sand free ☐ Other, specify	Draw Down		Recovery	
	Time (min)	Water Level (m/ft)	Time (min)	Water Level (m/ft)
If pumping discontinued, give reason:	Static Level	12.91		13.31
	1	12.12	1	13.075
Pump intake set at (m/ft) * 30.48	2	13.14	2	13.06
Pumping rate (l/min / GPM) 170.34	3	13.15	3	13.075
Duration of pumping 4 hrs + 0 min	4	13.15	4	13.065
Final water level end of pumping (m/ft) 13.305	5	13.15	5	13.06
If flowing give rate (l/min / GPM)	10	13.18	10	13.035
	15	13.19	15	13.025
Recommended pump depth (m/ft) 30.48	20	13.195	20	13.005
Recommended pump rate (l/min / GPM) 170.34	25	13.20	25	13.0
Well production (l/min / GPM)	30	13.22	30	13.0
Disinfected? ☒ Yes ☐ No	40	13.25	40	12.97
	50	13.255	50	12.975
	60	13.26	60	12.975

Map of Well Location	
Please provide a map below following instructions on the back.	
Comments: Aren 10 deep	
Well owner's information package delivered ☒ Yes ☐ No	Date Package Delivered 20080723
Date Work Completed 20080723	Ministry Use Only Audit No. Z 84497
Received	



Ministry of
the Environment

Well Tag No. (Below)

A 083366

MW09 - T3 - 01

09-0078-00

Well Record

Regulation 903 Ontario Water Resources Act

Page 1 of 1

Measurements recorded in: ☐ Metric ☒ Imperial

Well Owner's Information

First Name	Last Name / Organization	E-mail Address	☐ Well Constructed by Well Owner
Wellington County			
Mailing Address (Street Number/Name)	Municipality	Province	Postal Code
74 Woolwich St	Guelph	ON	N1H3T9
Telephone No. (inc. area code)			
866 899 6245			

Well Location

Address of Well Location (Street Number/Name)		Township	Lot	Concession
Little Tract Trail 6714 County Rd 34			9	3
County/District/Municipality	City/Town/Village	Province	Postal Code	
	Reslinch	Ontario	N1H3T9	
UTM Coordinates	Zone	Easting	Northing	Municipal Plan and Sublot Number
NAD 83	11	746086	648116	419
Other				

Overburden and Bedrock Materials/Abandonment Sealing Record (see instructions on the back of this form)

General Colour	Most Common Material	Other Materials	General Description	Depth (m/ft)
				From To
Brown	Gravel			0 15
	Sand			15 26
	Gravel			26 48
Grey	Silt	Sand		48 53
	Clay			53 74
	Gravel			74 76
	Clay			76 78
	Bedrock			78 370

Annular Space		
Depth Set at (m/ft)	Type of Sealant Used (Material and Type)	Volume Placed (m³/ft³)
From To		
0 82	Portland Cement	
82 110	sand	
110 260	Portland Cement	
260 329	sand	

Method of Construction	Well Use
☐ Cable Tool ☐ Rotary (Conventional) ☐ Rotary (Reverse) ☐ Boring ☐ Air percussion ☒ Other, specify	☐ Public ☐ Domestic ☐ Livestock ☐ Irrigation ☐ Industrial ☐ Other, specify
☐ Diamond ☐ Jetting ☐ Driving ☐ Digging	☐ Commercial ☐ Municipal ☐ Test Hole ☐ Cooling & Air Conditioning ☐ Not used ☐ Dewatering ☐ Monitoring

Construction Record - Casing				Status of Well	
Inside Diameter (cm/in)	Open Hole OR Material (Galvanized, Fibreglass, Concrete, Plastic, Steel)	Wall Thickness (cm/in)	Depth (m/ft)		
			From To		
1	Plastic	5.410	0 270	☐ Water Supply ☐ Replacement Well ☐ Test Hole ☐ Recharge Well ☐ Dewatering Well ☐ Observation and/or Monitoring Hole ☐ Alteration (Construction) ☐ Abandoned, Insufficient Supply ☐ Abandoned, Poor Water Quality ☐ Abandoned, other, specify	
1	Plastic	5.410	0 85		

Construction Record - Screen				
Outside Diameter (cm/in)	Material (Plastic, Galvanized, Steel)	Slot No.	Depth (m/ft)	
			From To	
1	Plastic	10	270 320	
1	Plastic	10	85 100	

Water Details		Hole Diameter	
Water found at Depth	Kind of Water: ☐ Fresh ☐ Untested	Depth (m/ft)	Diameter (cm/in)
30 (m/ft)	☐ Gas ☐ Other, specify	From To	
		0 80	6
Water found at Depth	Kind of Water: ☐ Fresh ☐ Untested		
(m/ft)	☐ Gas ☐ Other, specify	80 370	3.75
Water found at Depth	Kind of Water: ☐ Fresh ☐ Untested		
(m/ft)	☐ Gas ☐ Other, specify		

Well Contractor and Well Technician Information			
Business Name of Well Contractor		Well Contractor's Licence No.	
Aardvark Drilling Inc		7121318	
Business Address (Street Number/Name)		Municipality	
25 Lewis Road - Unit C		Guelph	
Province	Postal Code	Business E-mail Address	
ON	N1H3T9		
Bus. Telephone No. (inc. area code)		Name of Well Technician (Last Name, First Name)	
519 836 1934		Gina T.M.	
Well Technician's Licence No.		Signature of Technician and/or Contractor	
13141314		2004 07 03	
Date Submitted			

Results of Well Yield Testing				
After test of well yield, water was: ☐ Clear and sand free ☐ Other, specify	Draw Down		Recovery	
	Time (min)	Water Level (m/ft)	Time (min)	Water Level (m/ft)
If pumping discontinued, give reason:	Static Level			
	1		1	
Pump intake set at (m/ft)	2		2	
	3		3	
Pumping rate (l/min / GPM)	4		4	
	5		5	
Duration of pumping hrs + min	10		10	
	15		15	
Final water level end of pumping (m/ft)	20		20	
	25		25	
If flowing give rate (l/min / GPM)	30		30	
	40		40	
Recommended pump depth (m/ft)	50		50	
	60		60	
Recommended pump rate (l/min / GPM)				
Well production (l/min / GPM)				
Disinfected? ☐ Yes ☐ No				

Map of Well Location	
Please provide a map below following instructions on the back.	
Comments:	

Well owner's information package delivered		Date Package Delivered		Ministry Use Only	
☐ Yes ☐ No		Y/Y/Y/M/M/D/D		Audit No.	
		Date Work Completed		2098724	
				Received	



CITY OF GUELPH TIER THREE ASSESSMENT CHARACTERIZATION FINAL REPORT

C2: Core and Chip Photographs

TOP



10.7 – 12.2 m
12.2 – 15.2 m
15.2 – 18.3 m
18.3 – 21.3 m
21.3 – 24.4 m
24.4 – 27.4 m
27.4 – 30.5 m
30.5 – 33.5 m
33.5 – 36.6 m
36.6 – 39.6 m
39.6 – 42.7 m
42.7 – 45.7 m
45.7 – 48.8 m
48.8 – 51.8 m
51.8 – 54.9 m
54.9 – 57.9 m
57.9 – 61.0 m
61.0 – 64.0 m
64.0 – 67.1 m
67.1 – 70.1 m

BOTTOM

TOP



70.1 – 73.2 m
73.2 – 76.2 m
76.2 – 79.2 m
79.2 – 82.3 m
82.3 – 85.3 m
85.3 – 88.4 m
88.4 – 91.4 m
91.4 – 94.5 m
94.5 – 95.7 m

BOTTOM

EOH

PROJECT					City of Guelph Tier Three Local Area Risk Assessment					
TITLE					MW08-T3-01 Bedrock Chip Photos					
					PROJECT No. 08-1112-0021			FILE No. MW08-T3-01		
					DESIGN	KS	APR 2010	SCALE	NTS	REV. 2
					CADD	KS	APR 2010	Plate C1		
					CHECK	--				
					REVIEW	JAP	NOV 2010			

BOTTOM

TOP

TOP 8.6 m



8.6 – 9.1 m

9.1 – 10.7 m

10.7 – 12.2 m

12.2 – 13.7 m

13.7 – 15.2 m

15.2 – 16.8 m

16.8 – 18.3 m

18.3 -19.8 m

19.8 – 21.3 m

21.3 – 22.9 m

22.9 – 24.4 m

24.4 – 25.9 m

25.9 – 27.4 m

27.4 – 29.0 m

29.0 – 30.5 m

30.5 – 32.0 m

30.5 – 33.5 m

PROJECT						
City of Guelph Tier Three Local Area Risk Assessment						
TITLE						
MW08-T3-02 Core Photos						
	PROJECT No.			08-1112-0021		FILE No. MW08-T3-02
	DESIGN	KS	FEB 2010		SCALE	NTS
	CADD	KS	APR 2010		REV. 2	
	CHECK	--			Plate C2	
	REVIEW	JAP	NOV 2010			

BOTTOM

TOP



33.5 – 35.1 m

35.1 – 36.6 m

36.6 – 38.1 m

38.1 – 39.6 m

39.6 – 41.1 m

41.1 – 42.7 m

42.7 – 44.2 m

44.2 – 45.7 m

45.7 – 47.2 m

47.2 – 48.8 m

48.8 – 50.3 m

50.3 – 51.8 m

51.8 – 53.3 m

53.3 – 54.9 m

54.9 – 56.4 m

56.4 – 57.9 m

57.9 – 59.4 m


59.4 – 61.0 m

61.0 – 62.5 m

PROJECT				
City of Guelph Tier Three Local Area Risk Assessment				
TITLE				
MW08-T3-02 Core Photos				
	PROJECT No.		08-1112-0021	
	FILE No.		MW08-T3-02	
	DESIGN	KS	FEB 2010	SCALE NTS
	CADD	KS	APR 2010	REV. 2
	CHECK	---		
REVIEW				JAP NOV 2010
Plate C3				

BOTTOM

TOP

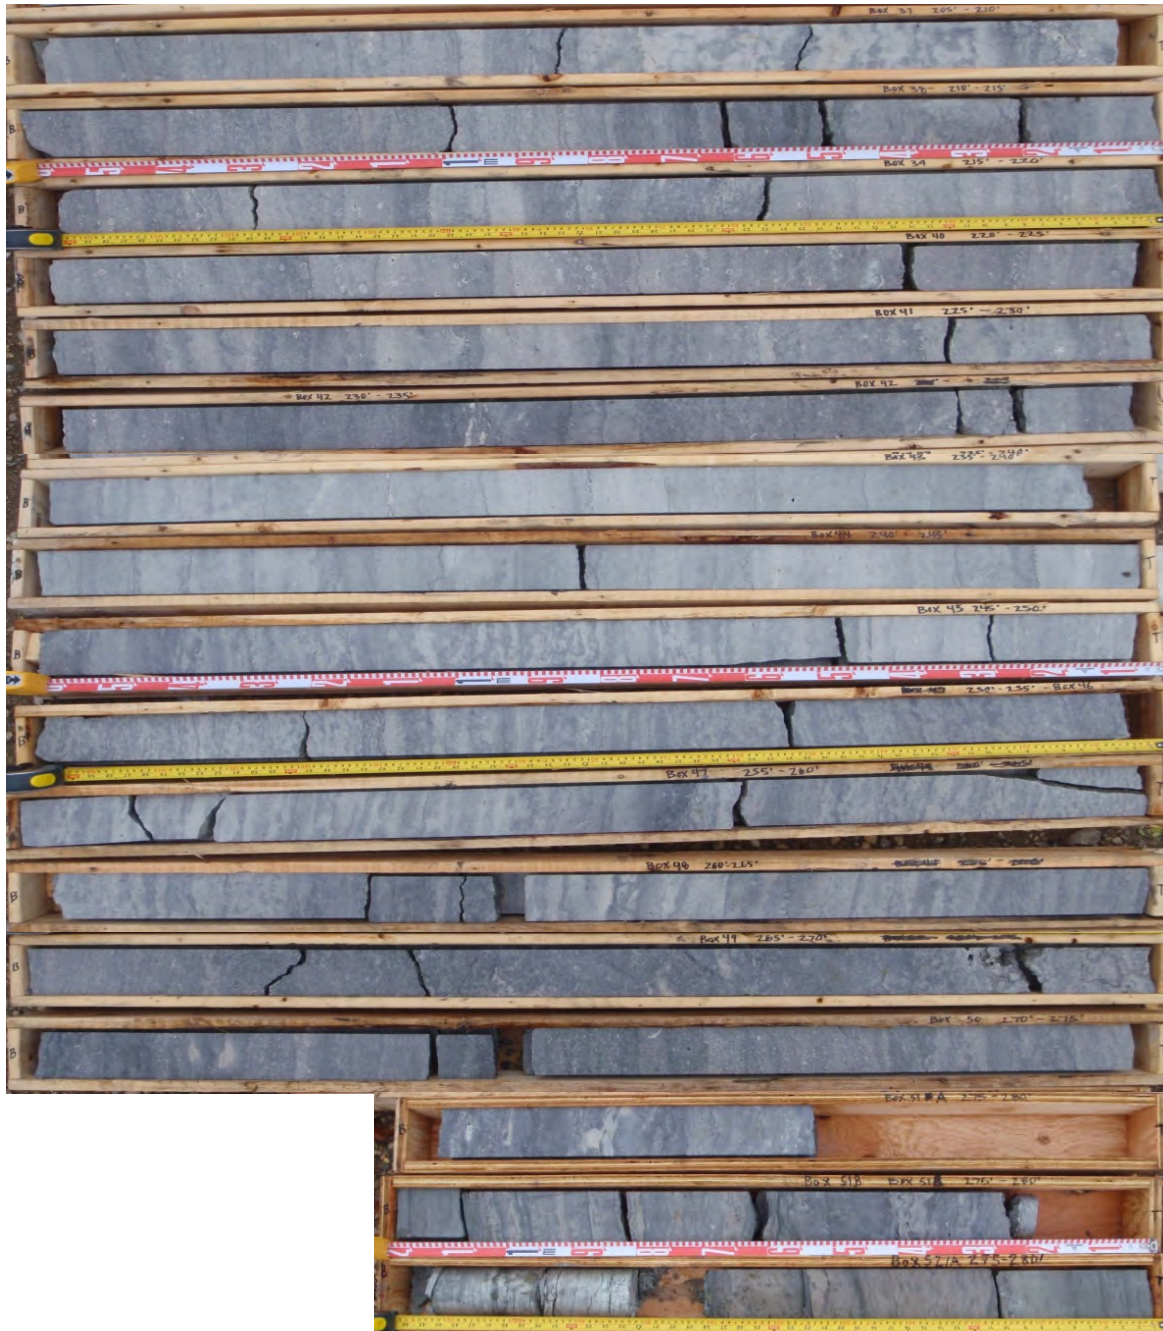

62.5 – 64.0 m

64.0 – 65.5 m

65.5 – 67.1 m

67.1 – 68.6 m

68.6 – 70.1 m

70.1 – 71.6 m

71.6 – 73.2 m

73.2 – 74.7 m

74.7 – 76.2 m

76.2 – 77.7 m

77.7 – 79.2 m

79.2 – 80.8 m

80.8 – 82.3 m

82.3 – 83.8 m

83.8 – 85.3 m

BOTTOM 85.3 m

PROJECT					City of Guelph Tier Three Local Area Risk Assessment		
TITLE					MW08-T3-02 Core Photos		
		PROJECT No.		08-1112-0021	FILE No. MW08-T3-02		
		DESIGN	KS	FEB 2010	SCALE	NTS	REV. 2
		CADD	KS	APR 2010	Plate C4		
		CHECK	--	NOV 2010			
		REVIEW	JAP	NOV 2010			

TOP



30.5 - 33.5 m
33.5 - 36.6 m
36.6 - 39.6 m
39.6 - 42.7 m
42.7 - 45.7 m

BOTTOM

TOP



45.7 - 48.8 m
48.8 - 51.8 m
51.8 - 54.9 m
54.9 - 57.9 m
57.9 - 61.0 m
61.0 - 64.0 m
64.0 - 70.1 m
70.1 - 73.2 m
73.2 - 76.2 m
76.2 - 79.2 m
79.2 - 82.3 m
82.3 - 85.3 m
85.3 - 88.4 m
88.4 - 91.4 m
91.4 - 94.5 m
94.5 - 97.2 m

BOTTOM

EOH

PROJECT					City of Guelph Tier Three Local Area Risk Assessment				
TITLE					MW08-T3-03 Bedrock Chip Photos				
					PROJECT No. 08-1112-0021		FILE No. MW08-T3-03		
					DESIGN	KS	APR 2010	SCALE	NTS
					CADD	KS	APR 2010	REV. 2	
					CHECK	--			
					REVIEW	JAP	NOV 2010	Plate C5	

TOP



BOTTOM

19.8 – 22.9 m

22.9 – 25.9 m

25.9 – 28.9 m

28.9 – 32.0 m

32.0 – 35.0 m

35.0 – 38.1 m

38.1 – 41.1 m

41.1 – 44.2 m

44.2 – 47.2 m

47.2 – 50.3 m

50.3 – 53.3 m

53.3 – 56.4 m

56.4 – 59.4 m

59.4 – 62.5 m

62.5 – 65.5 m

65.5 – 68.6 m

68.6 – 71.6 m

71.6 – 74.7 m

74.7 – 77.7 m

77.7 – 80.8 m

TOP



BOTTOM

80.8 – 83.8 m

140.2 – 143.3 m

83.8 – 86.9 m

143.3 – 146.3 m

86.9 – 89.9 m

EOH

89.9 – 93.0 m

93.0 – 96.0 m

96.0 – 99.1 m

99.1 – 102.1 m

102.1 – 105.2 m

105.2 – 108.2 m

108.2 – 111.3 m

111.3 – 114.3 m

114.3 – 115.8 m

115.8 – 118.9 m

118.9 – 121.9 m

121.9 – 125.0 m

125.0 – 128.0 m

128.0 – 131.1 m

131.1 – 134.1 m

134.1 – 137.2 m

137.2 – 140.2 m

TOP



BOTTOM

PROJECT

City of Guelph
Tier Three Local Area Risk Assessment

TITLE

MW08-T3-04 Bedrock Chip Photos



PROJECT No. 08-1112-0021			FILE No. MW08-T3-04		
DESIGN	KS	Apr 2010	SCALE	NTS	REV. 2
CADD	KS	APR 2010	Plate C6		
CHECK	--				
REVIEW	JAP	NOV 2010			

BOTTOM

TOP



TOP 19.2 m
19.2 - 20.0 m
20.0 - 21.0 m
21.0 - 22.3 m
22.3 - 23.2 m
23.2 - 24.1 m
24.1 - 25.3 m
25.3 - 25.9 m
25.9 - 27.1 m
27.1 - 28.2 m
28.2 - 29.3 m
29.3 - 30.5 m
30.5 - 31.5 m
31.5 - 32.6 m
32.6 - 33.8 m
32.6 - 34.7 m
34.7 - 35.7 m
35.7 - 36.9 m
36.9 - 37.8 m
37.8 - 39.2 m

PROJECT		City of Guelph Tier Three Local Area Risk Assessment			
TITLE		MW08-T3-05 Core Photos			
	PROJECT No.	08-1112-0021		FILE No. MW08-T3-05	
	DESIGN	KS	FEB 2010	SCALE	NTS
	CADD	KS	APR 2010	REV. 2	
	CHECK	--		Plate C7	
	REVIEW	JAP	NOV 2010		

BOTTOM

TOP



39.2 – 39.9 m

39.9 – 41.1 m

41.1 – 42.4 m

42.4 – 43.6 m

43.6 – 44.8 m

44.8 – 45.7 m

45.7 – 46.8 m

46.8 – 47.9 m

47.9 – 49.1 m

49.1 – 50.0 m

50.0 – 51.2 m

51.2 – 52.4 m

52.4 – 53.0 m

53.0 – 54.3 m

54.3 – 55.5 m

55.5 – 56.1 m

56.1 – 57.3 m

57.3 – 58.2 m

Scale is Approximate

PROJECT		City of Guelph Tier Three Local Area Risk Assessment			
TITLE		MW08-T3-05 Core Photos			
		PROJECT No. 08-1112-0021		FILE No. MW08-T3-05	
		DESIGN	KS	FEB 2010	SCALE NTS
		CADD	KS	APR 2010	REV. 2
		CHECK	--		Plate C8
		REVIEW	JAP	NOV 2010	

BOTTOM

TOP



58.2 - 59.1 m

59.1 - 60.4 m

60.4 - 61.4 m

61.4 - 62.3 m

62.3 - 63.1 m

63.1 - 64.3 m

64.3 - 65.2 m

65.2 - 66.2 m

66.2 - 67.1 m

67.1 - 68.2 m

68.2 - 69.2 m

69.2 - 70.3 m

70.3 - 71.3 m

71.3 - 72.4 m

72.4 - 73.4 m

73.4 - 74.5 m

PROJECT					City of Guelph Tier Three Local Area Risk Assessment				
TITLE					MW08-T3-05 Core Photos				
					PROJECT No. 08-1112-0021		FILE No. MW08-T3-05		
					DESIGN	KS	FEB 2010	SCALE	NTS
					CADD	KS	APR 2010	REV. 2	
					CHECK	--			
					REVIEW	JAP	NOV 2010	Plate C9	

BOTTOM

TOP



74.5 – 75.6 m
75.6 – 76.5 m
76.5 – 77.7 m
77.7 – 78.8 m
78.8 – 79.8 m
79.8 – 80.9 m
80.9 – 82.0 m
82.0 – 83.1 m
83.1 – 83.5 m
83.5 – 84.7 m
84.7 – 85.9 m
85.9 – 86.8 m
86.8 – 87.7 m
87.7 – 88.9 m
88.9 – 90.0 m
90.0 – 91.1 m
91.1 – 92.3 m
92.3 – 93.4 m

PROJECT

City of Guelph
Tier Three Local Area Risk Assessment

TITLE

MW08-T3-05 Core Photos



PROJECT No. 08-1112-0021		FILE No. MW08-T3-05	
DESIGN	KS	FEB 2010	SCALE NTS
CADD	KS	APR 2010	REV. 2
CHECK	--		
REVIEW	JAP	NOV 2010	

Plate C10

BOTTOM

TOP



93.4 – 94.4 m

94.4 – 95.5 m

95.5 – 96.6 m

96.6 – 97.6 m

97.6 – 98.8 m

98.8 – 99.9 m

99.9 – 101.0 m

101.0 – 102.1 m

102.1 – 103.3 m

103.3 – 104.3 m

104.3 – 104.9 m

BOTTOM 104.9 m

PROJECT					City of Guelph Tier Three Local Area Risk Assessment		
TITLE					MW08-T3-05 Core Photos		
					PROJECT No. 08-1112-0021		FILE No. MW08-T3-05
					DESIGN	KS	FEB 2010
					CADD	KS	APR 2010
					CHECK	--	
					REVIEW	JAP	NOV 2010
					Plate C11		

BOTTOM

TOP



TOP 1.1 m

1.1 – 2.1 m

2.1 – 3.1 m

3.1 – 4.3 m

4.3 – 5.3 m

5.3 – 6.4 m

6.4 – 7.5 m

7.5 – 8.6 m

8.6 – 9.5 m

9.5 – 10.5 m

10.5 – 11.4 m

11.4 – 12.0 m

12.0 – 13.1 m

13.1 – 14.0 m

14.0 – 15.1 m

15.1 – 16.0 m

16.0 – 16.6 m

16.6 – 17.7 m

17.7 – 18.8 m

18.8 – 19.7 m

PROJECT				
City of Guelph Tier Three Local Area Risk Assessment				
TITLE				
MW08-T3-06 Core Photos				
		PROJECT No. 08-1112-0021		FILE No. MW08-T3-06
		DESIGN	KS	FEB 2010
		CADD	KS	APR 2010
		CHECK	--	
		REVIEW	JAP	NOV 2010
				Plate C12

BOTTOM

TOP



18.8 – 20.7 m
20.7 – 21.8 m
21.8 – 22.7 m
22.7 – 23.8 m
23.8 – 24.7 m
24.7 – 25.8 m
25.8 – 26.8 m
26.8 – 27.9 m
27.9 – 29.1 m
29.1 – 30.4 m
30.4 – 31.2 m
31.2 – 32.2 m
32.2 – 33.4 m
33.4 – 34.4 m
34.4 – 35.6 m
35.6 – 36.7 m
36.7 – 37.8 m
37.8 – 38.9 m
38.9 – 39.9 m
39.9 – 41.0 m
41.0 – 42.0 m

PROJECT

City of Guelph
Tier Three Local Area Risk Assessment

TITLE

MW08-T3-06 Core Photos



**Golder
Associates**

PROJECT No. 08-1112-0021		FILE No. MW08-T3-06	
DESIGN	KS	FEB 2010	SCALE NTS
CADD	KS	APR 2010	REV. 2
CHECK	--		Plate C13
REVIEW	JAP	NOV 2010	

BOTTOM

TOP



Note: Borehole advanced to 57.7mbgs.
Photos not taken.

BOTTOM 57.7 m

PROJECT				
City of Guelph Tier Three Local Area Risk Assessment				
TITLE				
MW08-T3-06 Core Photos				
		PROJECT No.	08-1112-0021	FILE No. MW08-T3-06
		DESIGN	KS	FEB 2010
		CADD	KS	APR 2010
		CHECK	--	
		REVIEW	JAP	NOV 2010
				Plate C14

TOP



15.2 – 18.3 m
 18.3 – 21.3 m
 21.3 – 24.4 m
 24.4– 27.4 m
 27.4 – 30.5 m
 30.5 -33.5 m
 33.5– 36.6 m
 36.6 – 39.6 m
 39.6 – 42.7 m
 42.7 – 45.7 m
 45.7 – 48.8 m
 48.8 – 51.8 m
 51.8 – 54.9 m
 54.9 – 57.9 m
 57.9 – 61.0 m
 61.0 – 64.0 m
 64.0 – 67.1 m
 67.1 – 70.1 m
 70.1– 73.2 m
 73.2– 76.5 m EOH

BOTTOM

PROJECT		City of Guelph Tier Three Local Area Risk Assessment			
TITLE		MW08-T3-07 Bedrock Chip Photos			
		PROJECT No. 08-1112-0021		FILE No. MW08-T3-07	
		DESIGN	KS	APR 2010	SCALE NTS
		CADD	KS	APR 2010	REV. 2
		CHECK	--		
		REVIEW	JAP	NOV 2010	
Plate C15					

TOP



18.3 – 21.3 m

21.3 – 24.4 m

24.4– 27.4 m

27.4 – 30.5 m

30.5 -33.5 m

33.5– 36.6 m

36.6 – 39.6 m

39.6 – 42.7 m

42.7 – 45.7 m

45.7 – 48.8 m

48.8 – 51.8 m

51.8 – 54.9 m

54.9 – 57.9 m

57.9 – 61.0 m

61.0 – 64.0 m

64.0 – 67.1 m

67.1 – 70.1 m

70.1– 73.2 m

73.2– 75.6 m

75.6– 76.2 m EOH

BOTTOM

PROJECT

City of Guelph
Tier Three Local Area Risk Assessment

TITLE

MW08-T3-08 Bedrock Chip Photos



PROJECT No. 08-1112-0021			FILE No. MW08-T3-08		
DESIGN	KS	APR 2010	SCALE	NTS	REV. 2
CADD	KS	APR 2010	Plate C16		
CHECK	--				
REVIEW	JAP	NOV 2010			

TOP



27.4 – 30.5 m

30.5 -33.5 m

33.5– 36.6 m

36.6 – 39.6 m

39.6 – 42.7 m

42.7 – 45.7 m

45.7 – 48.8 m

48.8 – 51.8 m

51.8 – 54.9 m

54.9 – 57.9 m

57.9 – 61.0 m

61.0 – 64.0 m

64.0 – 67.1 m

67.1 – 70.1 m

70.1– 73.2 m

73.2– 76.2 m

76.2 – 79.2 m

79.2 – 82.3 m

82.3 – 85.3 m

EOH

BOTTOM

PROJECT				
City of Guelph Tier Three Local Area Risk Assessment				
TITLE				
MW08-T3-09 Bedrock Chip Photos				
		PROJECT No.	08-1112-0021	FILE No. MW08-T3-09
		DESIGN	KS	APR 2010
		CADD	KS	APR 2010
		CHECK	--	
		REVIEW	JAP	NOV 2010
				SCALE NTS
				REV. 2
Plate C17				


TOP



39.6 – 42.7 m
42.7 – 45.7 m
45.7 – 48.8 m
48.8 – 51.8 m
51.8 – 54.9 m
54.9 – 57.9 m
57.9 – 61.0 m
61.0 – 64.0 m
64.0 – 67.1 m
67.1 – 70.1 m
70.1 – 73.2 m
73.2 – 76.2 m
76.2 – 79.2 m
79.2 – 82.3 m
82.3 – 85.3 m
85.3 – 88.4 m
88.4 – 91.4 m
91.4 – 94.5 m
94.5 – 97.5 m
97.5 – 100.6 m

BOTTOM

TOP

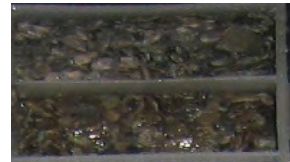

100.6 – 103.6 m
103.6 – 106.7 m

BOTTOM

EOH

PROJECT										City of Guelph Tier Three Local Area Risk Assessment																													
TITLE																				MW08-T3-10 Bedrock Chip Photos																			
										PROJECT No. 08-1112-0021										FILE No. MW08-T3-10																			
										DESIGN					KS					APR 2010					SCALE					NTS					REV. 2				
										CADD					KS					APR 2010					Plate C18														
										CHECK					--																								
										REVIEW					JAP					NOV 2010																			





Core photo



Optical televIEWER image

PROJECT		City of Guelph Tier Three Local Area Risk Assessment			
TITLE		Guelph Formation Example			
		PROJECT No.		FILE No.	
		DESIGN	KS	APR 2010	SCALE NTS
		CADD	KS	APR 2010	REV. 2
		CHECK	--		
		REVIEW	JAP	NOV 2010	
					Plate C19



Core photo



Optical televIEWER image

PROJECT		City of Guelph Tier Three Local Area Risk Assessment			
TITLE		Eramosa Formation Example			
		PROJECT No. 08-1112-0021		FILE No.	
		DESIGN	KS	APR 2010	SCALE NTS
		CADD	KS	APR 2010	REV. 2
		CHECK	--		
		REVIEW	JAP	NOV 2010	
Plate C20					



Core photo



Optical televIEWER image


PROJECT		City of Guelph Tier Three Local Area Risk Assessment			
TITLE		Goat Island Formation Example			
		PROJECT No. 08-1112-0021		FILE No.	
		DESIGN	KS	APR 2010	SCALE NTS
		CADD	KS	APR 2010	REV. 2
		CHECK	--		
		REVIEW	JAP	NOV 2010	
Plate C21					



Core photo




Optical televIEWER image

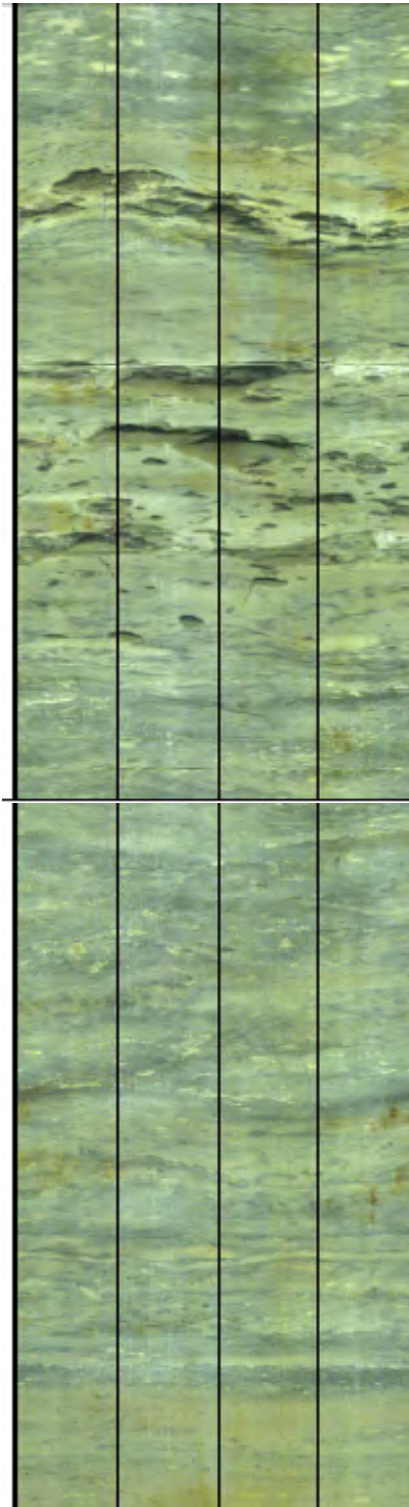

PROJECT		City of Guelph Tier Three Local Area Risk Assessment			
TITLE		Gasport Formation Example			
		PROJECT No. 08-1112-0021		FILE No.	
		DESIGN	KS	APR 2010	SCALE NTS
		CADD	KS	APR 2010	REV. 2
		CHECK	--		
		REVIEW	JAP	NOV 2010	
Plate C22					



Core photo

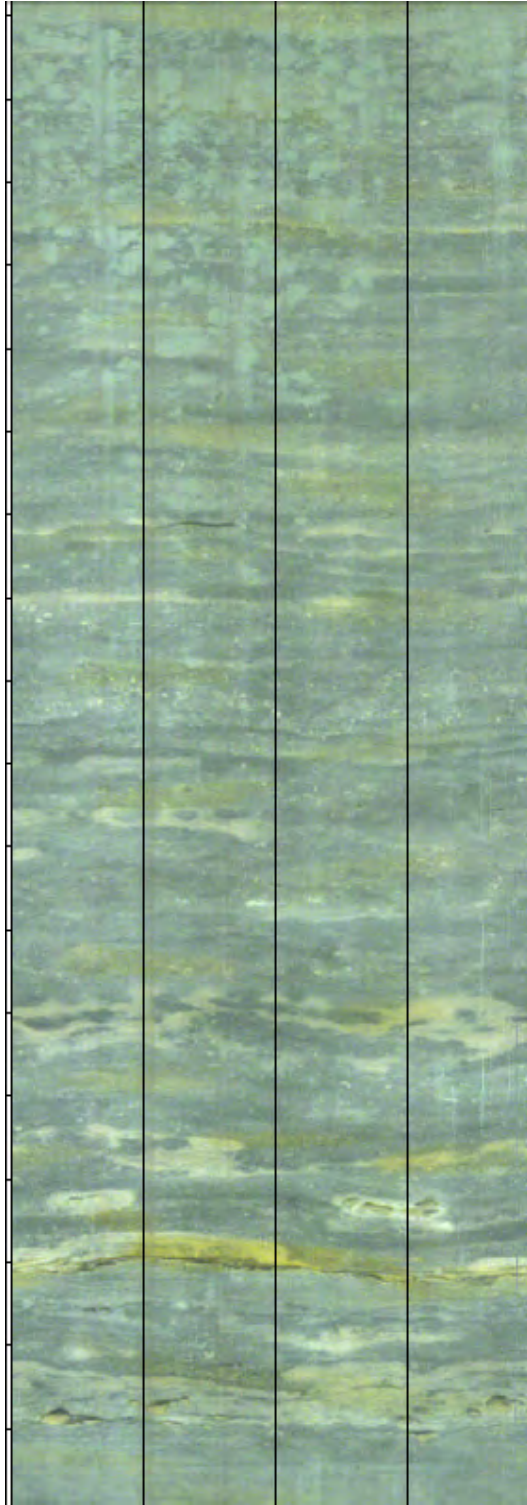


Optical televIEWER image

PROJECT		City of Guelph Tier Three Local Area Risk Assessment			
TITLE		Irondequoit Formation Example			
		PROJECT No. 08-1112-0021		FILE No.	
		DESIGN	KS	APR 2010	SCALE NTS
		CADD	KS	APR 2010	REV. 2
		CHECK	--		
		REVIEW	JAP	NOV 2010	
Plate C23					



Core photo

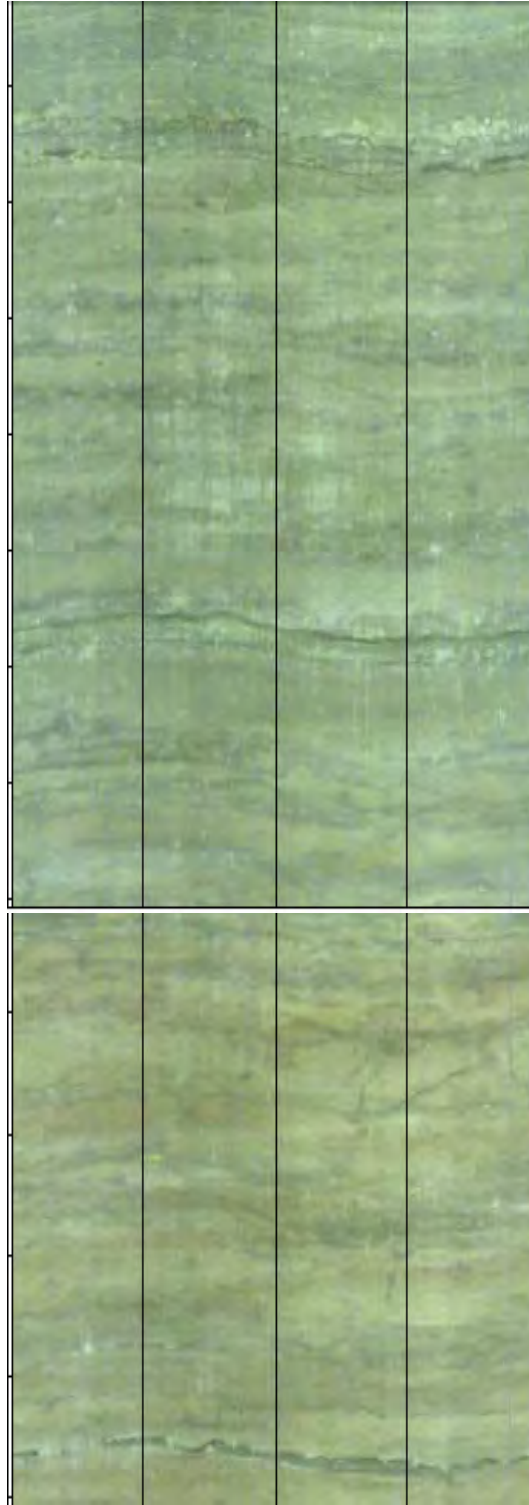

Optical televIEWER image

PROJECT		City of Guelph Tier Three Local Area Risk Assessment			
TITLE		Rockway Formation Example			
		PROJECT No. 08-1112-0021		FILE No.	
		DESIGN	KS	APR 2010	SCALE NTS
		CADD	KS	APR 2010	REV. 2
		CHECK	--		
		REVIEW	JAP	NOV 2010	
Plate C24					



Core photo



Optical televiewer image

PROJECT		City of Guelph Tier Three Local Area Risk Assessment			
TITLE		Merriton Formation Example			
		PROJECT No.		FILE No.	
		DESIGN	KS	APR 2010	SCALE NTS
		CADD	KS	APR 2010	REV. 2
		CHECK	--		
		REVIEW	JAP	NOV 2010	
					Plate C25



Core photo



Optical televiever image

PROJECT		City of Guelph Tier Three Local Area Risk Assessment			
TITLE		Cabothead Formation Example			
		PROJECT No.		FILE No.	
		DESIGN	KS	APR 2010	SCALE NTS
		CADD	KS	APR 2010	REV. 2
		CHECK	--		
		REVIEW	JAP	NOV 2010	
Plate C26					



CITY OF GUELPH TIER THREE ASSESSMENT CHARACTERIZATION FINAL REPORT

C3: Survey Data



LAND SURVEYORS and ENGINEERS

October 19, 2009

19055-09

jbuisman@vanharten.com

Golder Associates Inc
210 Sheldon Drive
Cambridge, Ontario
N1T 1A8

Attention: Kurt Stamm

Dear Sir:

Re: **Survey of Wells in the Guelph Area**
Part Lot 5, Concession 3, Part 1, 61R-8414
PIN 71211-0147 & PIN 71211-0012
Township of Puslinch

Please find enclosed a print out of the spreadsheet presenting the surveyed results of the wells in the Guelph area. The field work was completed Oct. 16 and the spreadsheet was emailed to you on Oct. 19.

Also find enclosed an invoice for our services to complete this work.

Please contact me if you have any questions or comments. Thanks for this opportunity to be of service.

Very truly yours,
Van Harten Surveying Inc.

Jeffrey E. Buisman B.E.S, B.Sc.
Ontario Land Surveyor

JEB:lb
encl.

100	4826603.263	560950.213	35.834	EL
101	4826604.365	560948.66	345.33	EL
102	4826603.332	560950.249	345.083	MW08 T3 08 OB
103	4826604.451	560948.755	346.173	MW08-T3-08
105	4845822.629	562218.53	428.364	MW08 T3 05 OB
106	4845823.573	562220.256	428.443	MW08-T3-05
107	4845823.633	562220.191	428.627	MW08-T3-05 CS
108	4845822.811	562218.862	427.537	EL
109	4845823.471	562219.931	427.585	EL
110	4834617.455	568274.137	366.579	MW08 T3 06 CS
111	4834617.385	568274.077	366.486	MW08-T3-06
112	4834617.298	568274.416	365.83	EL
113	4828350.267	564582.613	355.129	MW08 T3 07 OB
114	4828348.616	564581.254	354.898	MW08-T3-07
115	4828348.567	564581.571	354.286	EL
116	4828350.538	564582.823	354.204	EL
117	4820063.833	570645.73	346.965	MW08 T3 09 OB
118	4820064.572	570645.118	347.002	MW08-T3-09
119	4820064.831	570644.929	346.468	EL
120	4820064.08	570645.644	346.374	EL
121	4812507.57	563159.396	330.922	MW08 T3 10 OB
122	4812508.87	563160.895	331.046	MW08-T3-10
123	4812507.284	563159.696	330.312	EL
124	4812508.69	563160.918	330.256	EL
125	4810648.969	560864.121	317.037	MW09 T3 01 D
126	4810648.968	560864.183	317.01	MW09-T3-01
127	4810649.151	560864.277	315.837	EL
128	4824026.405	555101.114	339.954	MW08 T3 01
129	4824026.292	555101.126	339.801	MW08-T3-01 CS
130	4824026.147	555101.119	339.25	EL



CITY OF GUELPH TIER THREE ASSESSMENT CHARACTERIZATION FINAL REPORT


C4: Optical Televiewer Logs


GEOPHYSICAL RECORD OF BOREHOLE MW08-T3-01


PROJECT NO. 08-1112-0021
 LOCATION Marden Tract
 LOG DATE August 7, 2008
 LOGGED BY BB



LOG REFERENCE Ground Surface
 ELEVATION (masl) 339.25
 WATER LEVEL (mbgs) 2.52
 BORING METHOD Diamond Coring
 REVIEWED BY JAP

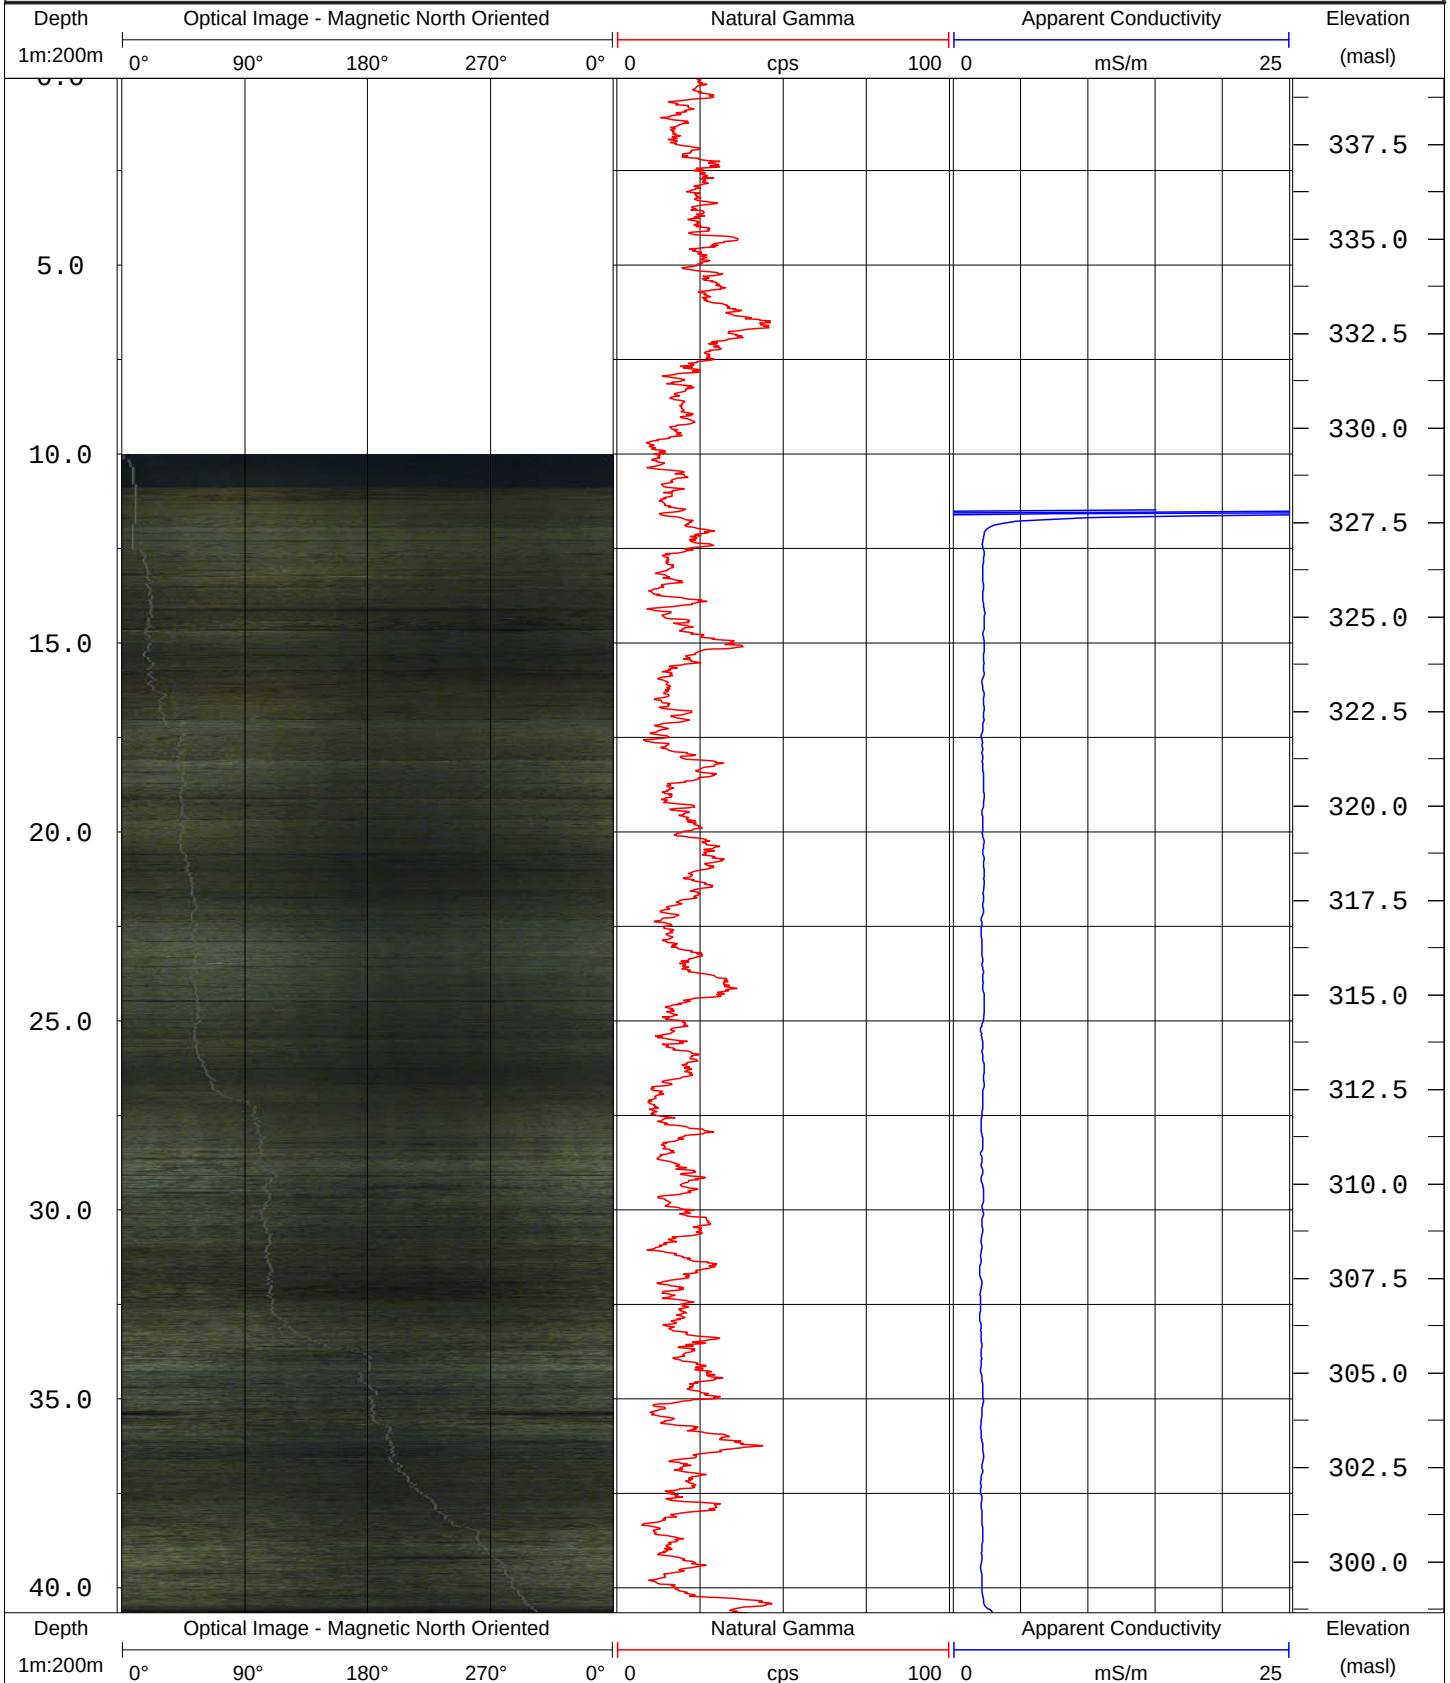

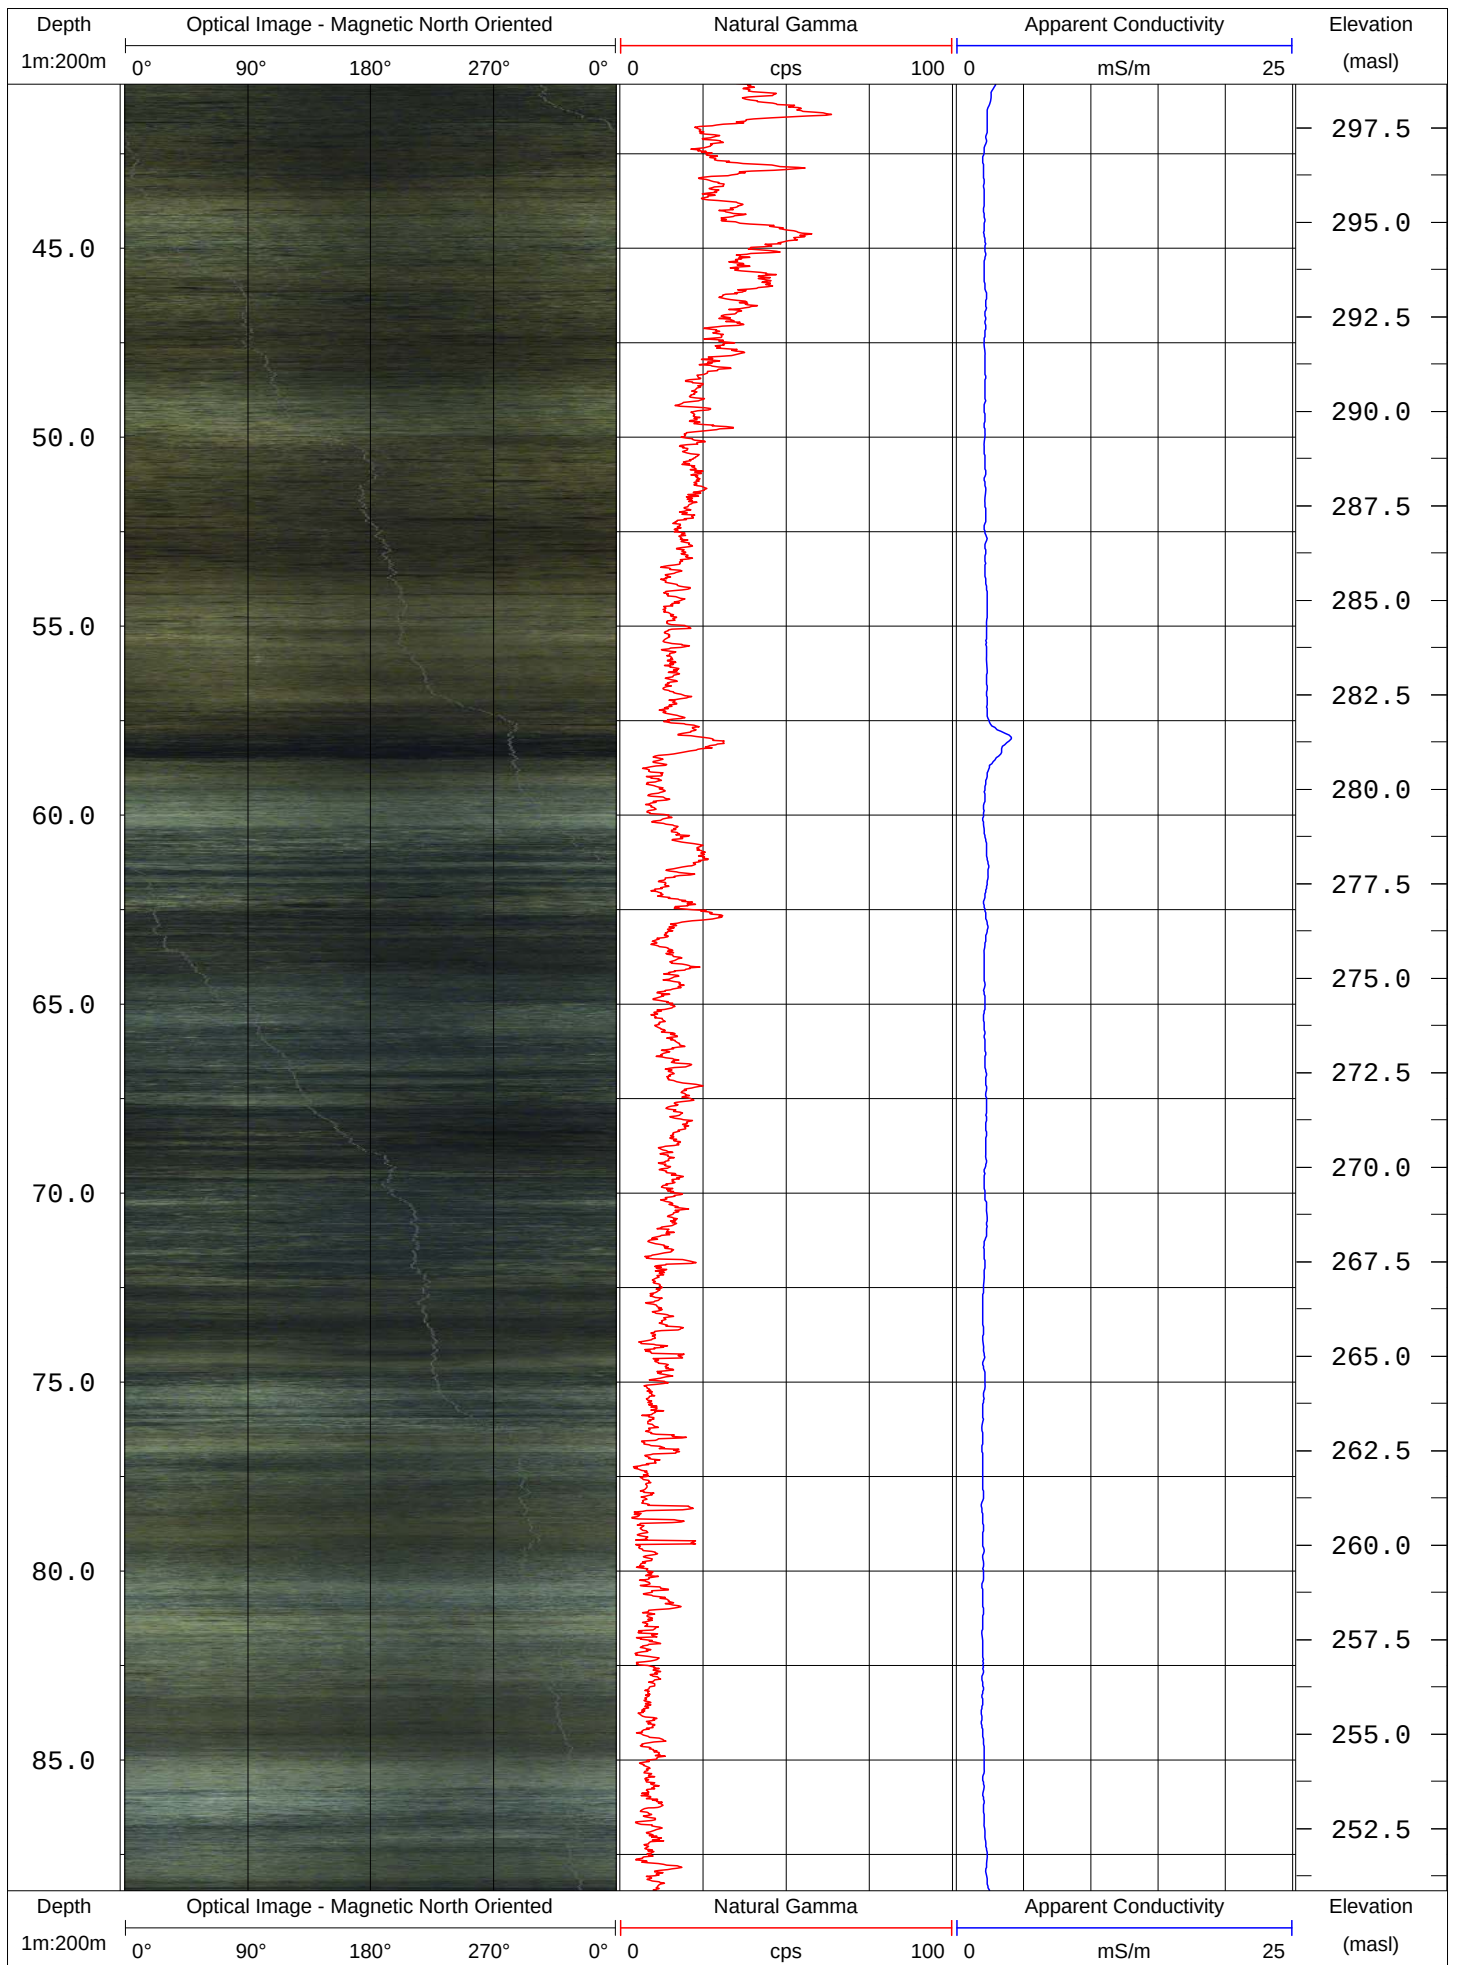

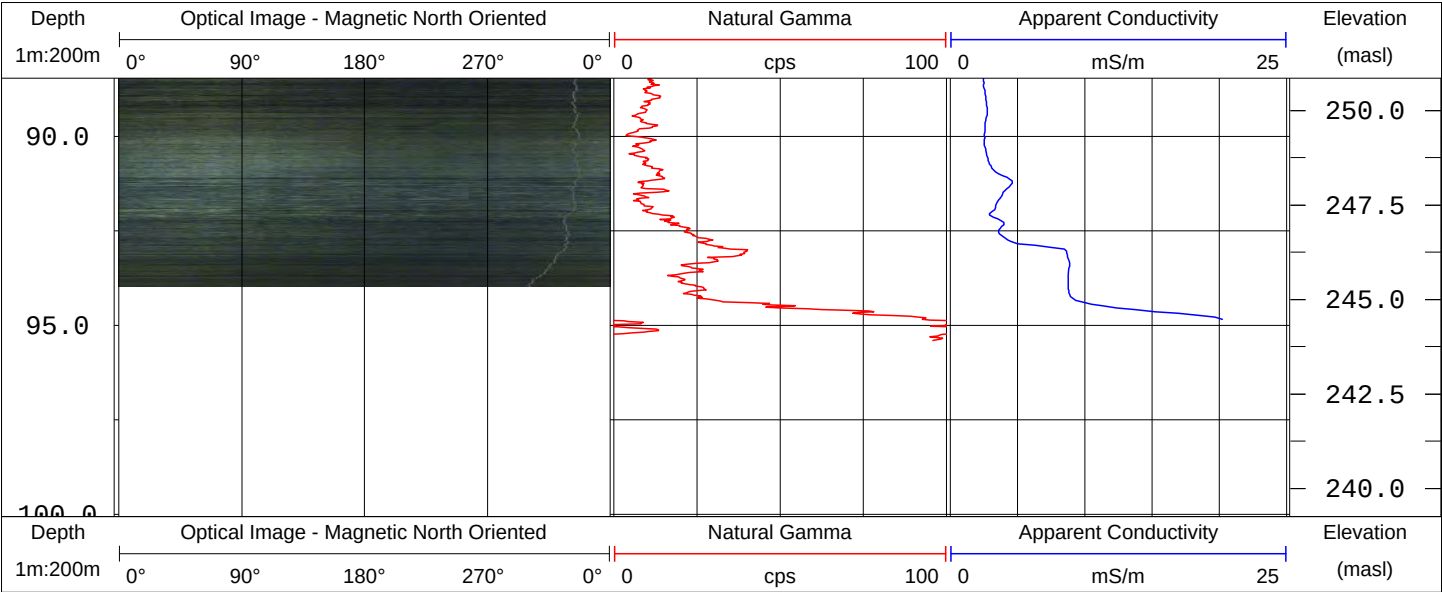



GEOPHYSICAL RECORD OF BOREHOLE MW08-T3-02


PROJECT NO. 08-1112-0021
 LOCATION Mill Road
 LOG DATE September 24, 2008
 LOGGED BY BB



LOG REFERENCE Ground Surface
 ELEVATION (masl) 362.64
 WATER LEVEL (mbgs) 12.52
 BORING METHOD PQ Coring
 REVIEWED BY JAP

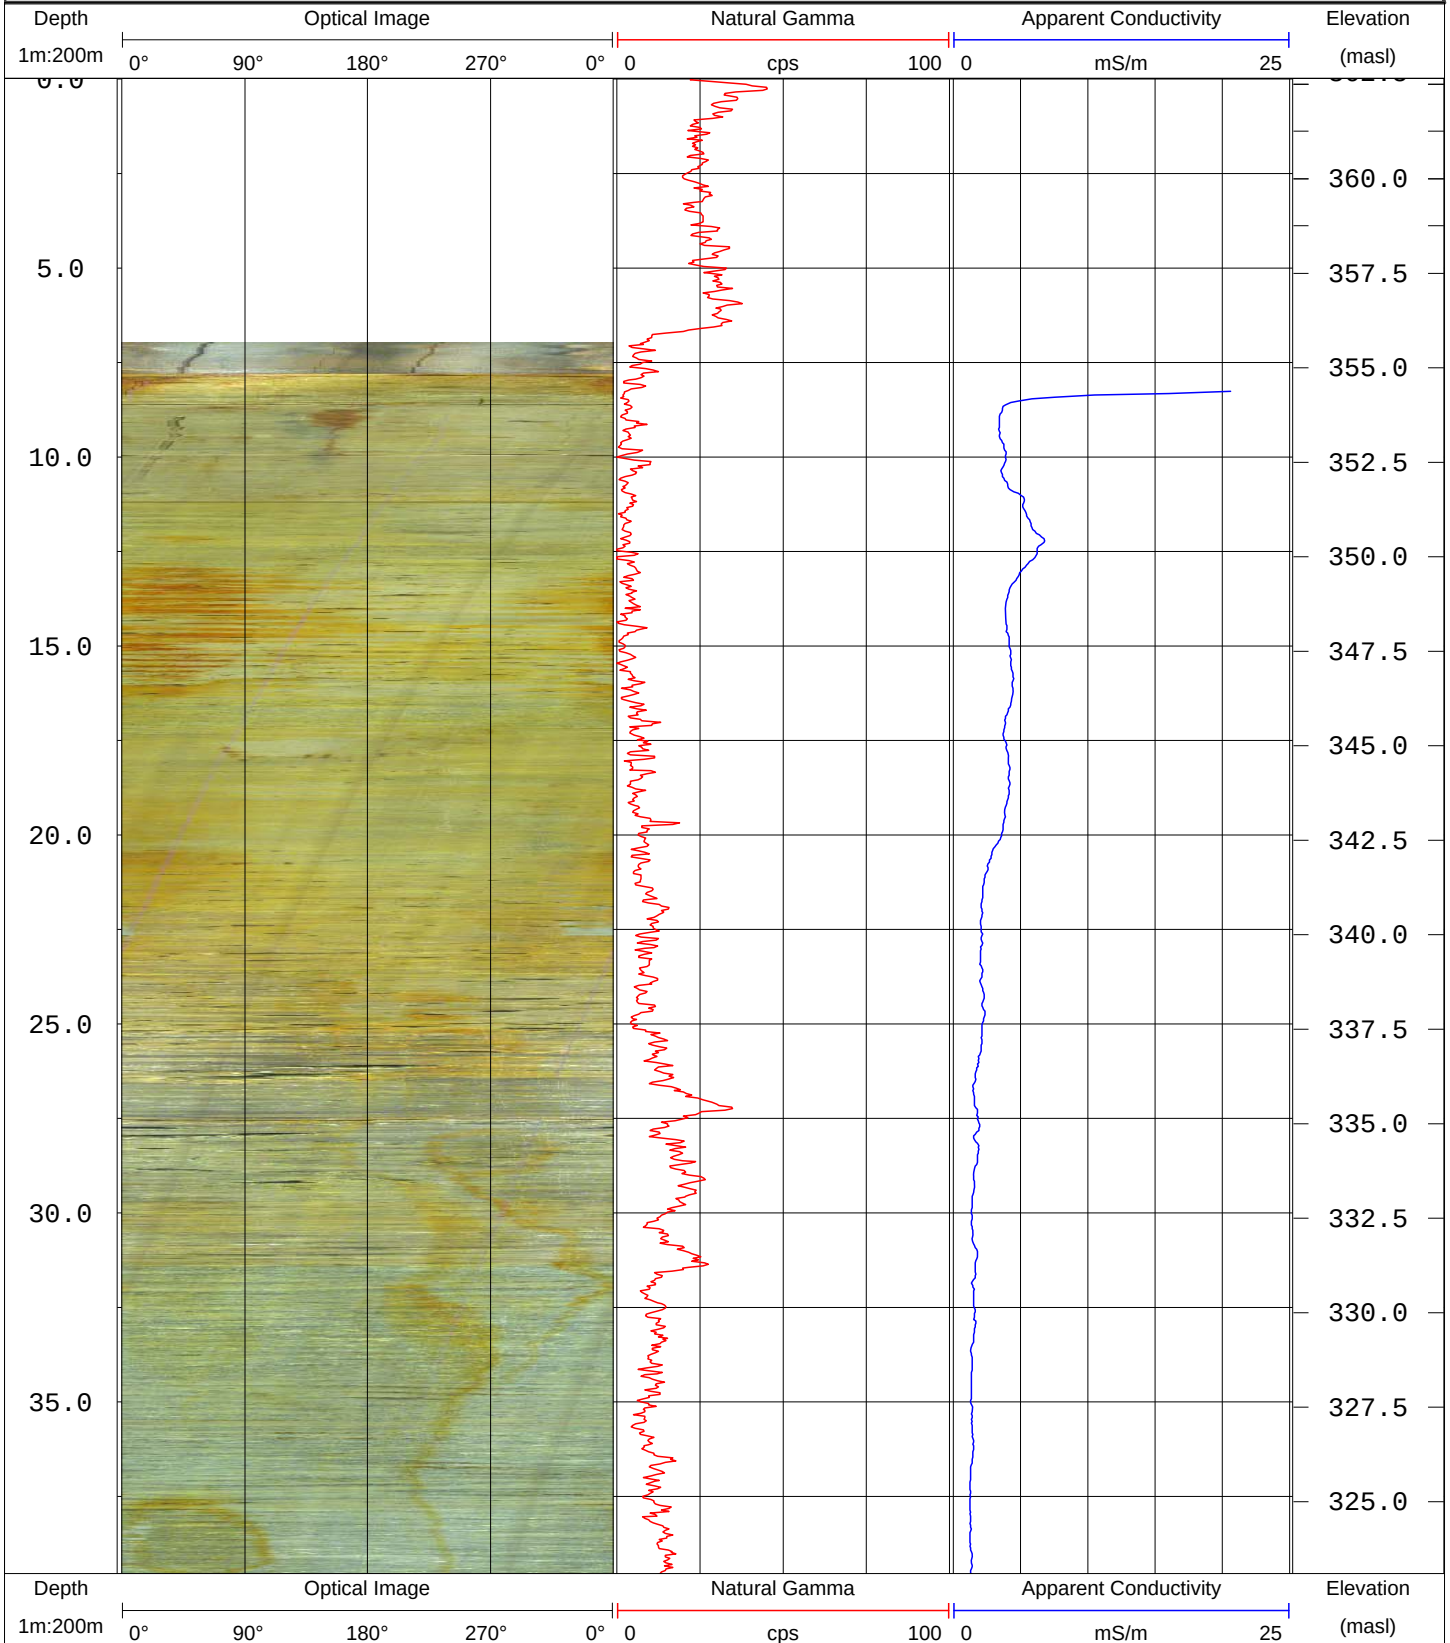

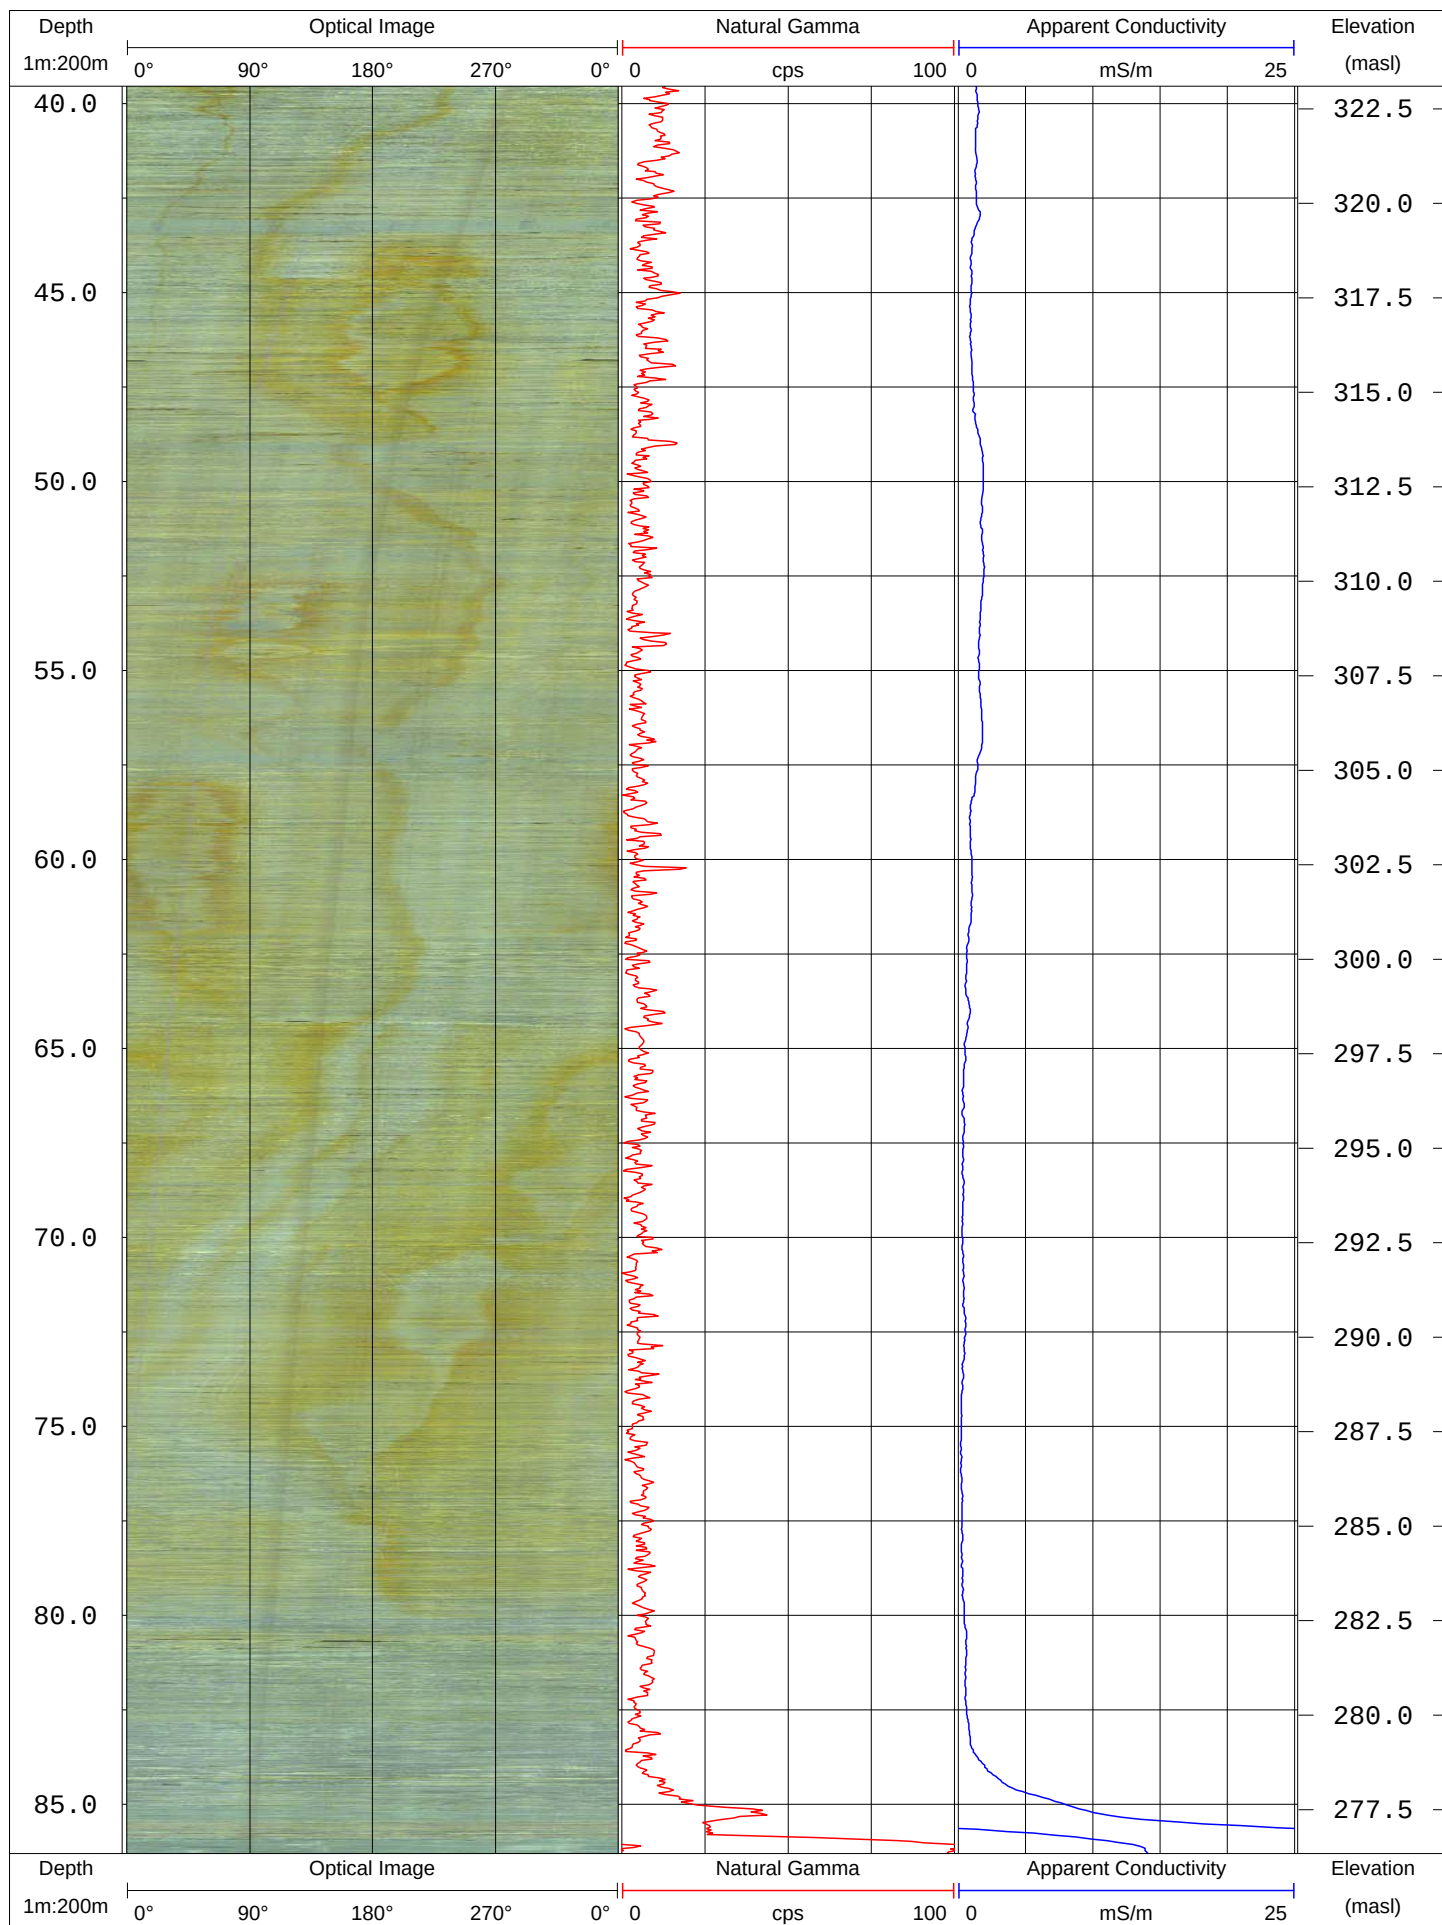

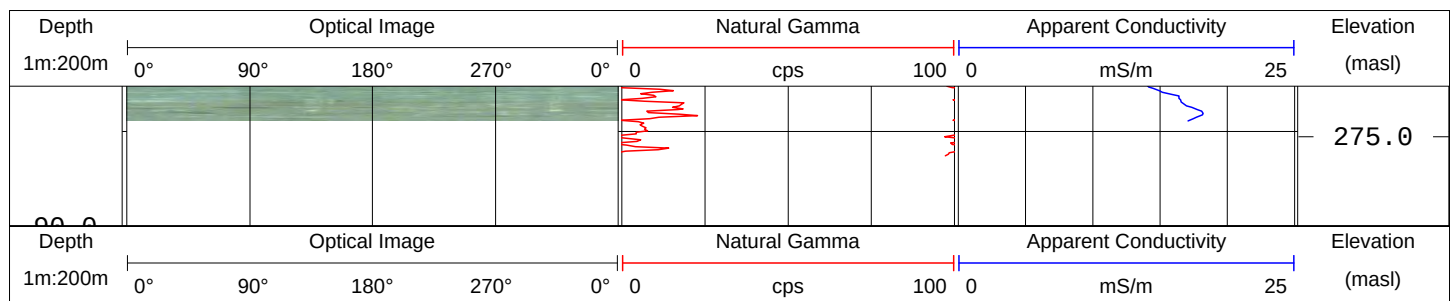



GEOPHYSICAL RECORD OF BOREHOLE MW08-T3-03


PROJECT NO. 08-1112-021
 LOCATION Hurkman Tract
 LOG DATE August 5, 2008
 LOGGED BY BB



LOG REFERENCE Ground Surface
 ELEVATION (masl) 398.93
 WATER LEVEL (mbgs) 24.56
 BORING METHOD Air Rotary (Tri-cone)
 REVIEWED BY JAP

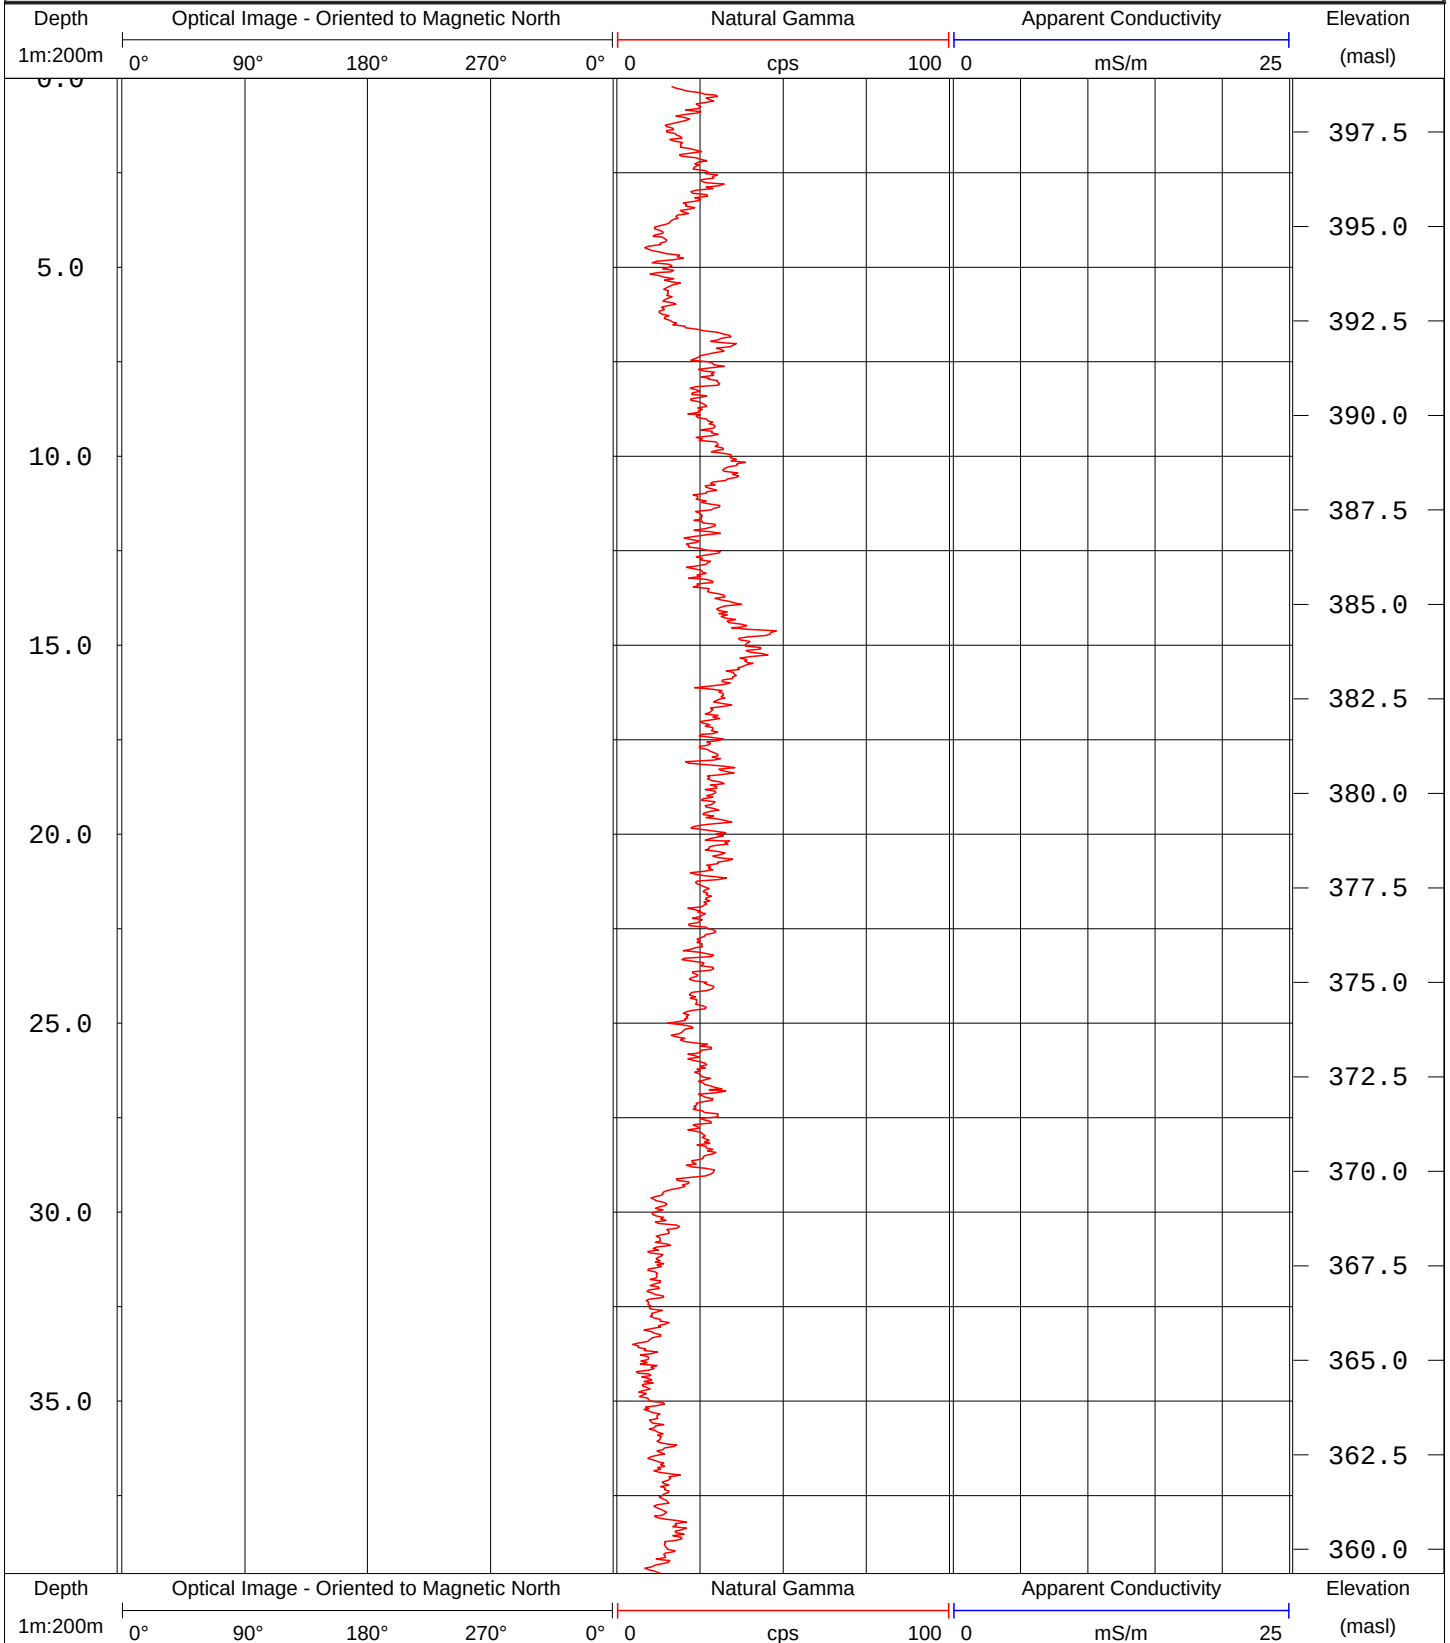

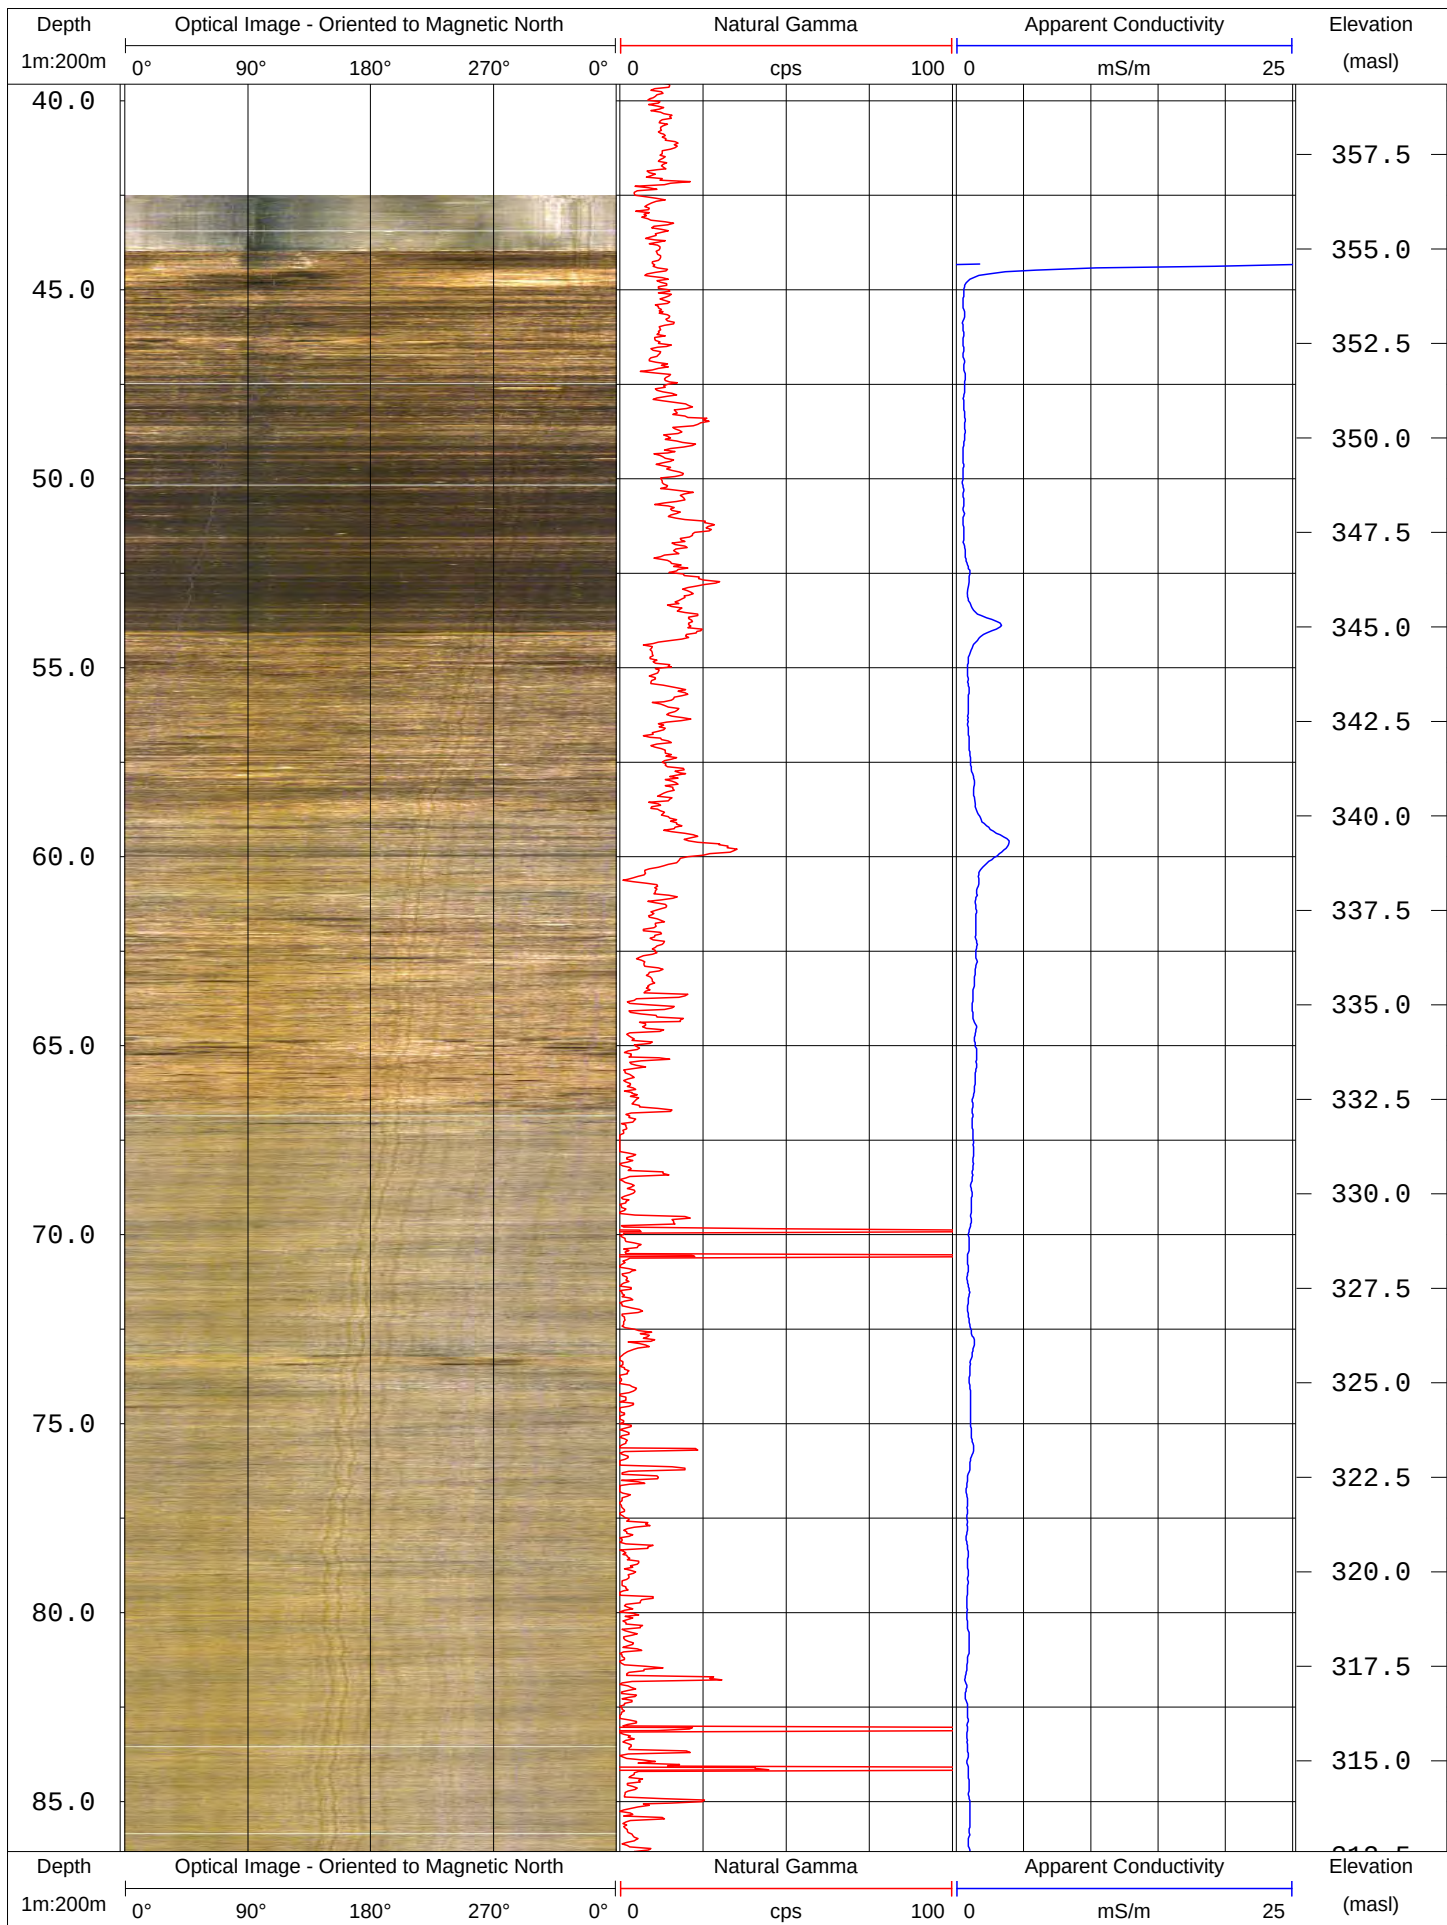

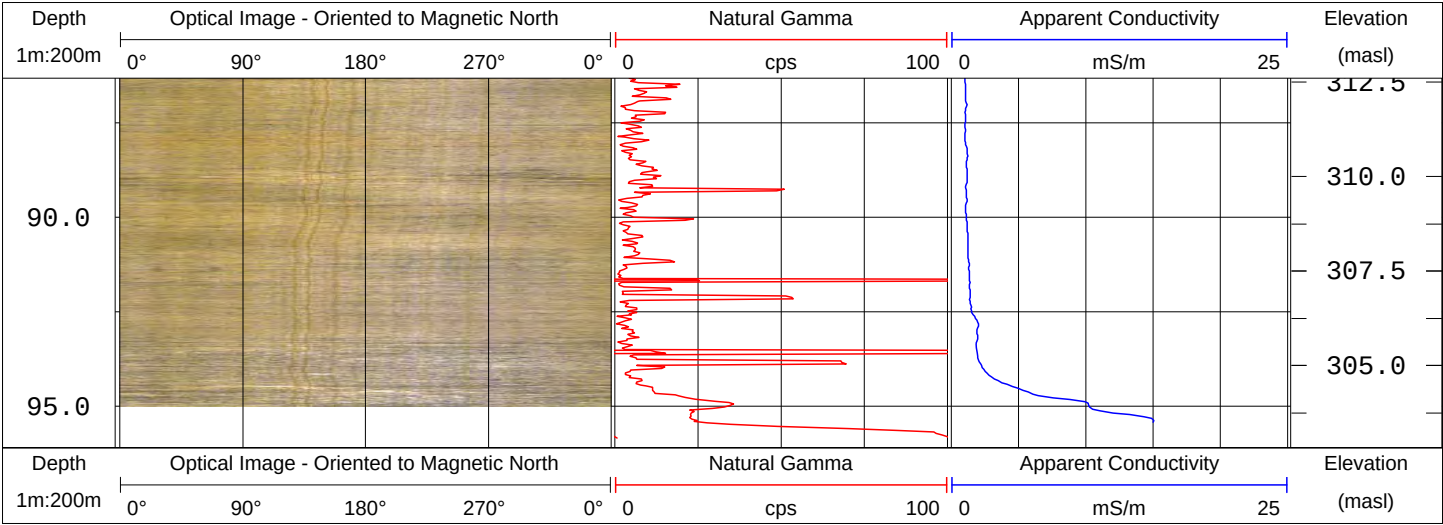



GEOPHYSICAL RECORD OF BOREHOLE MW08-T3-04


PROJECT NO. 08-1112-0021
 LOCATION Highway 6, Fergus, ON
 LOG DATE Aug.12 & Oct. 28, 2008
 LOGGED BY AR, BB




LOG REFERENCE Ground Surface
 ELEVATION (masl) 412.88
 WATER LEVEL (mbgs) 10.17
 BORING METHOD Air Rotary (Tri-cone)
 REVIEWED BY JAP

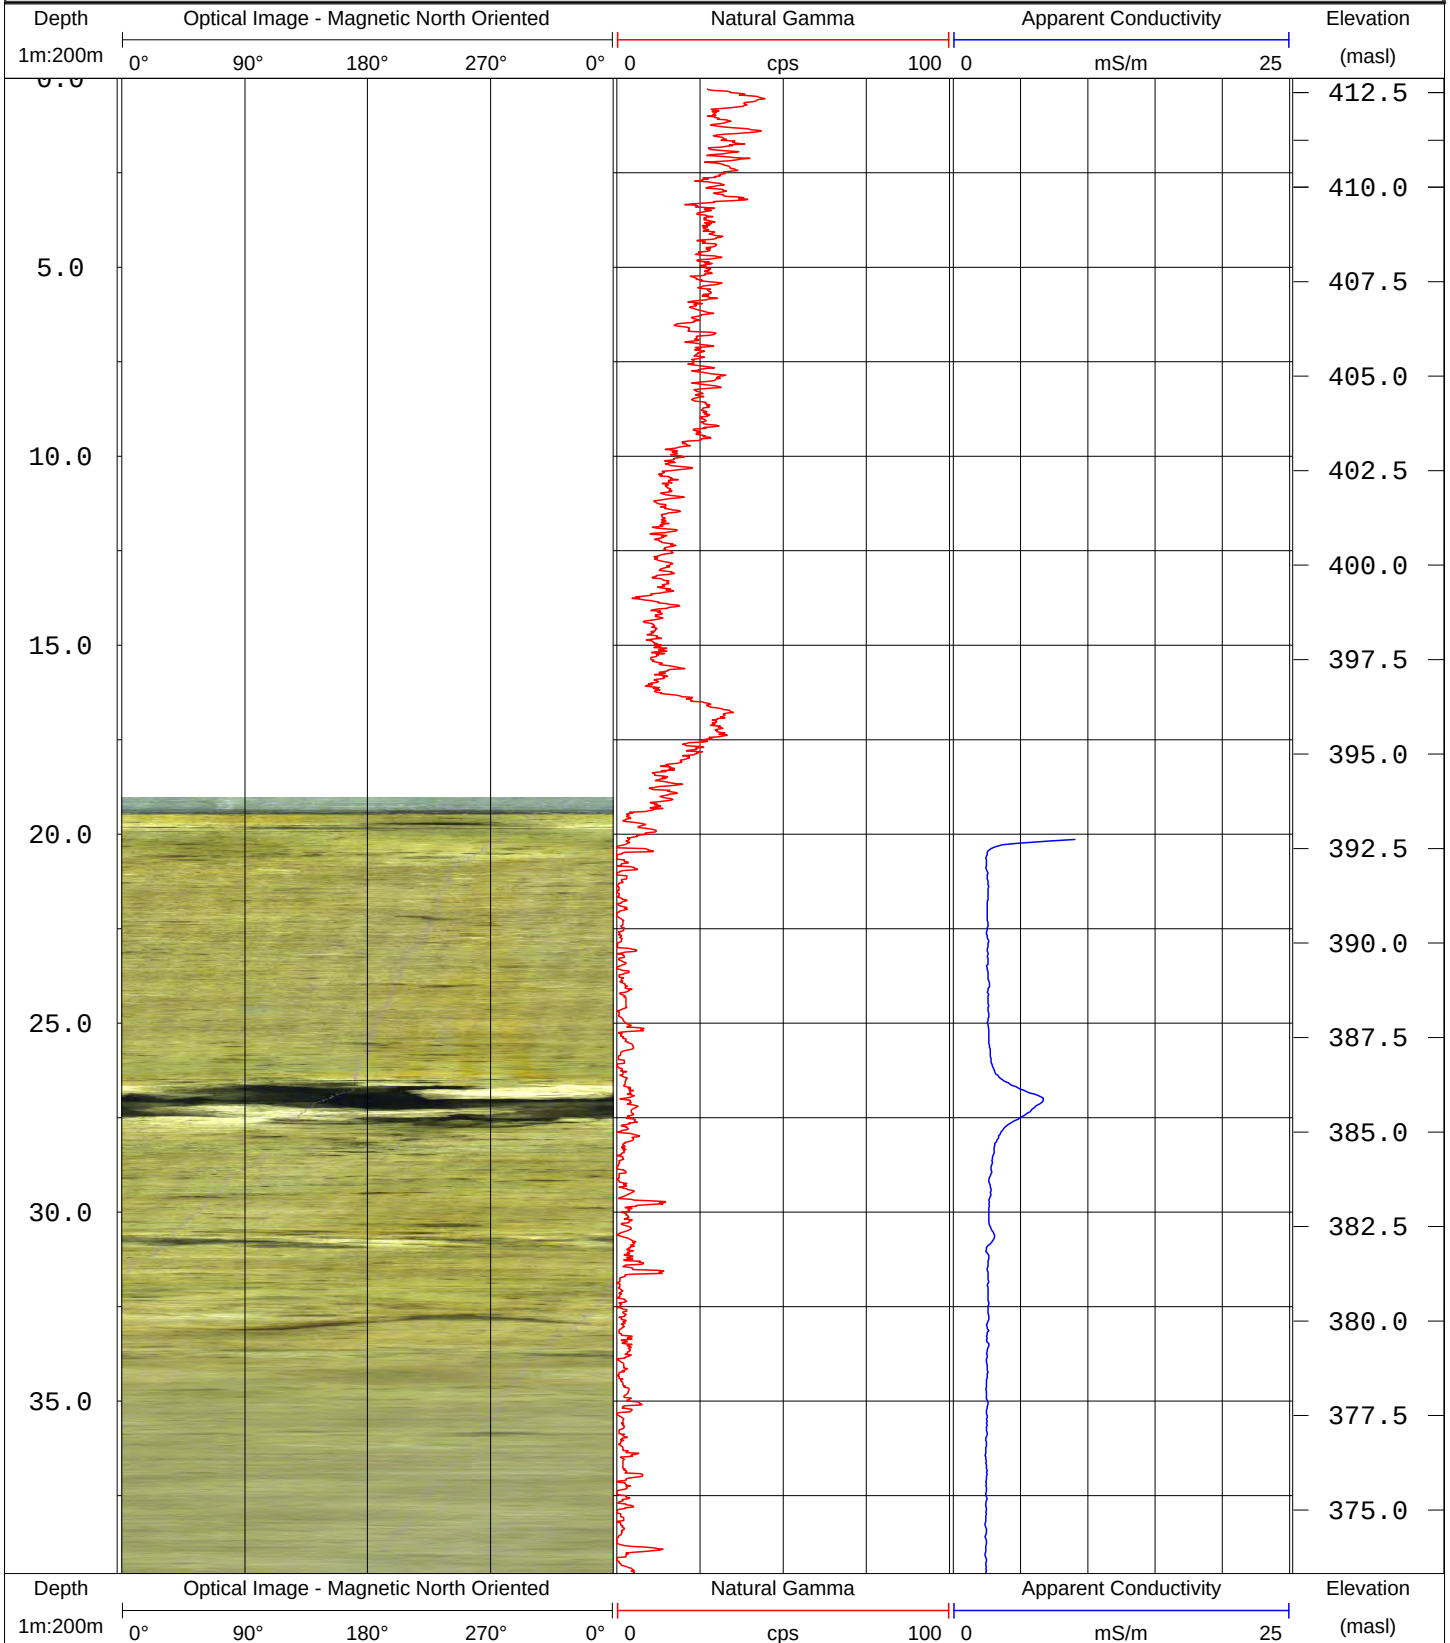

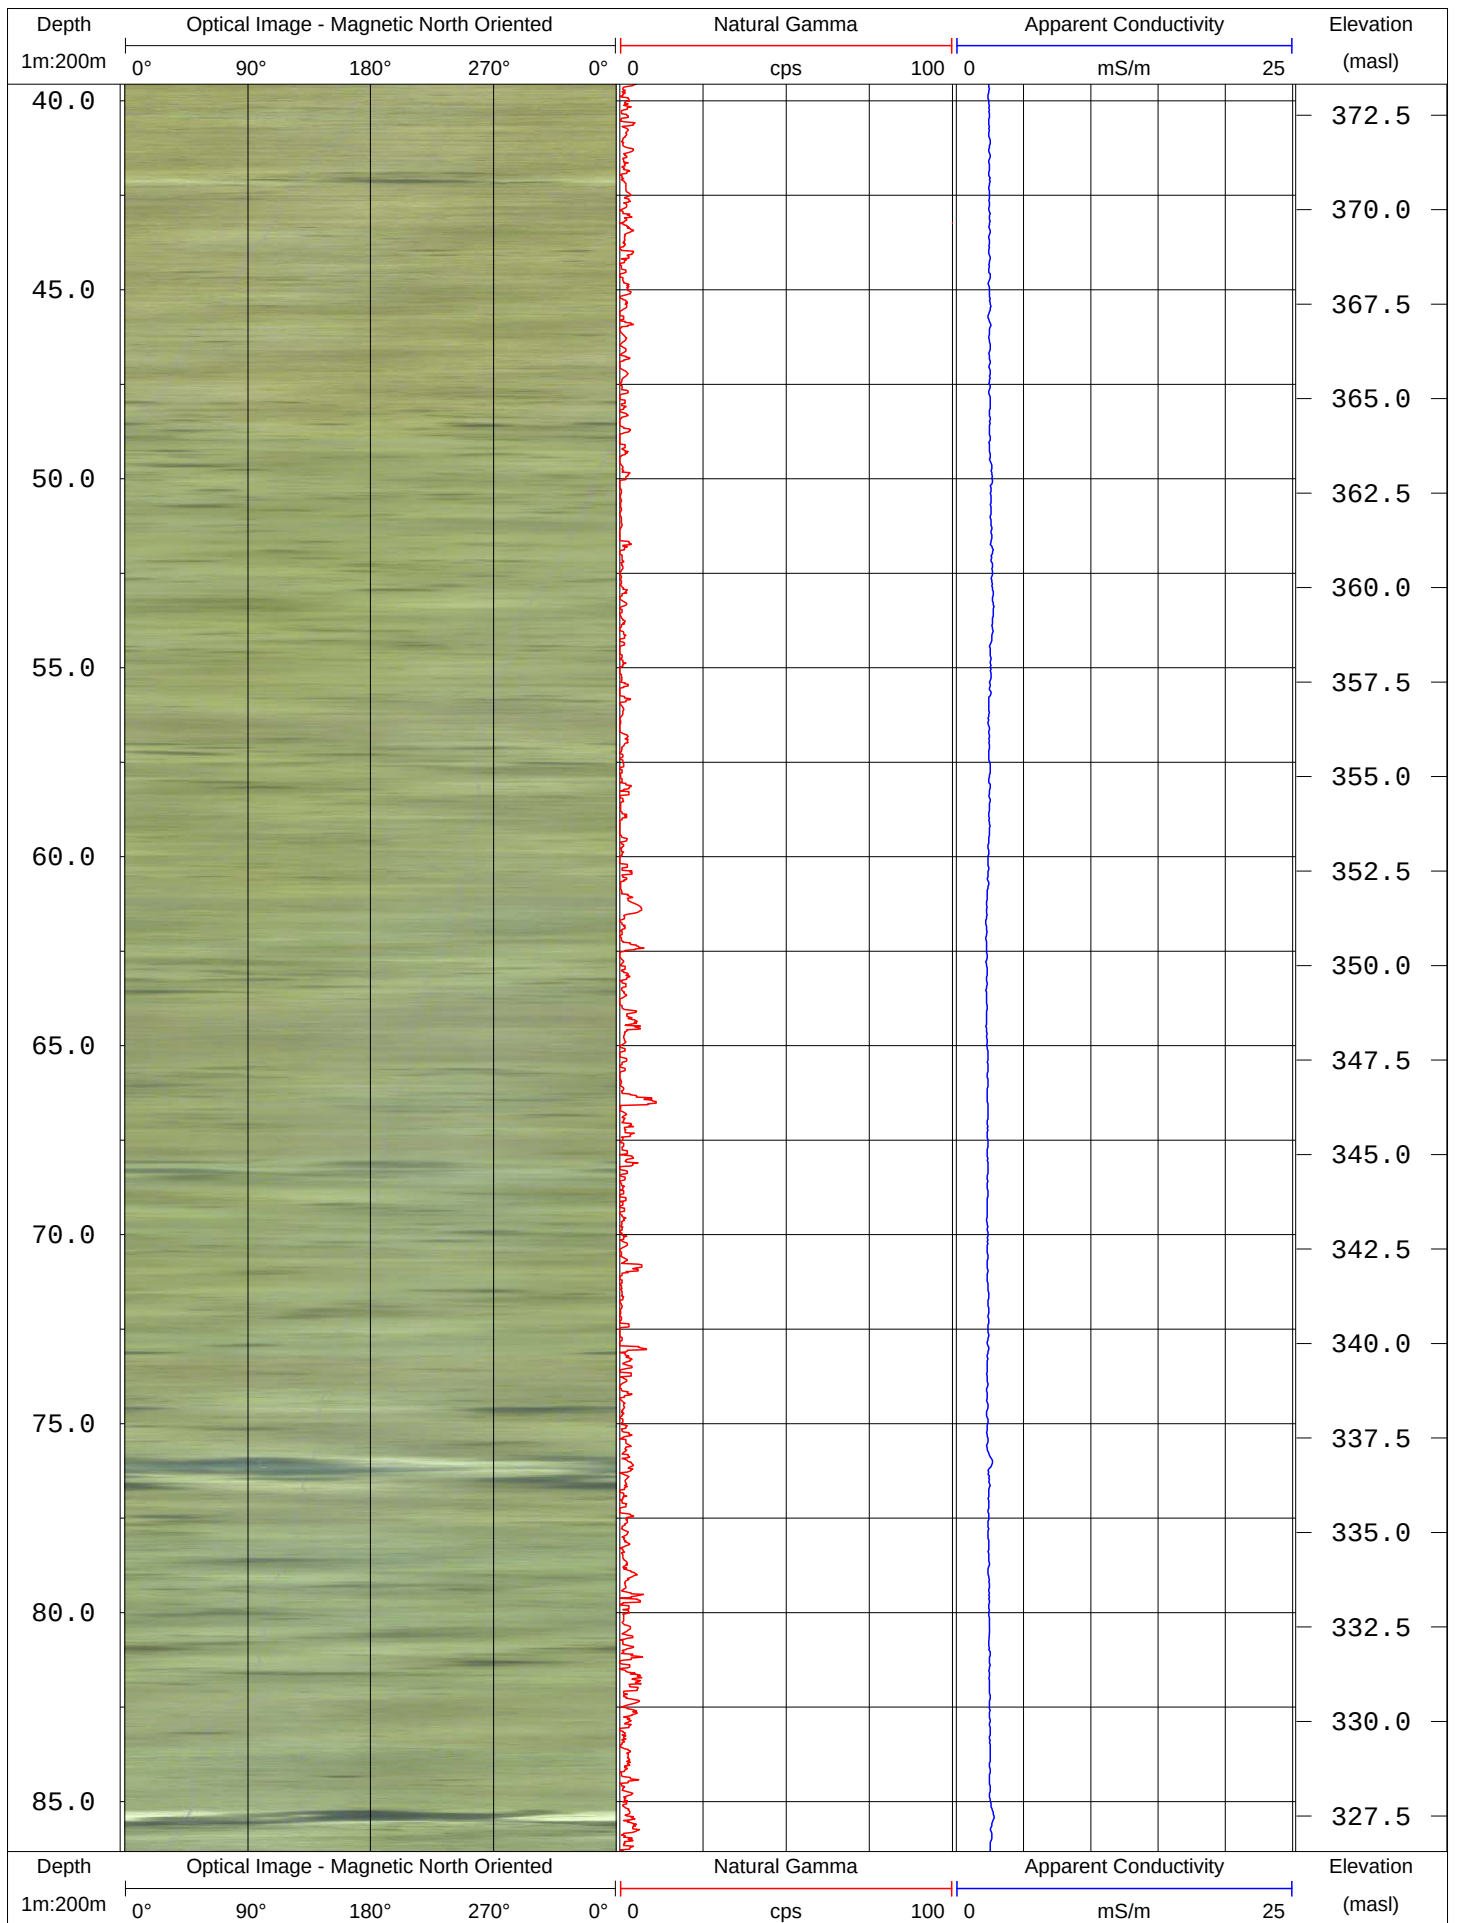

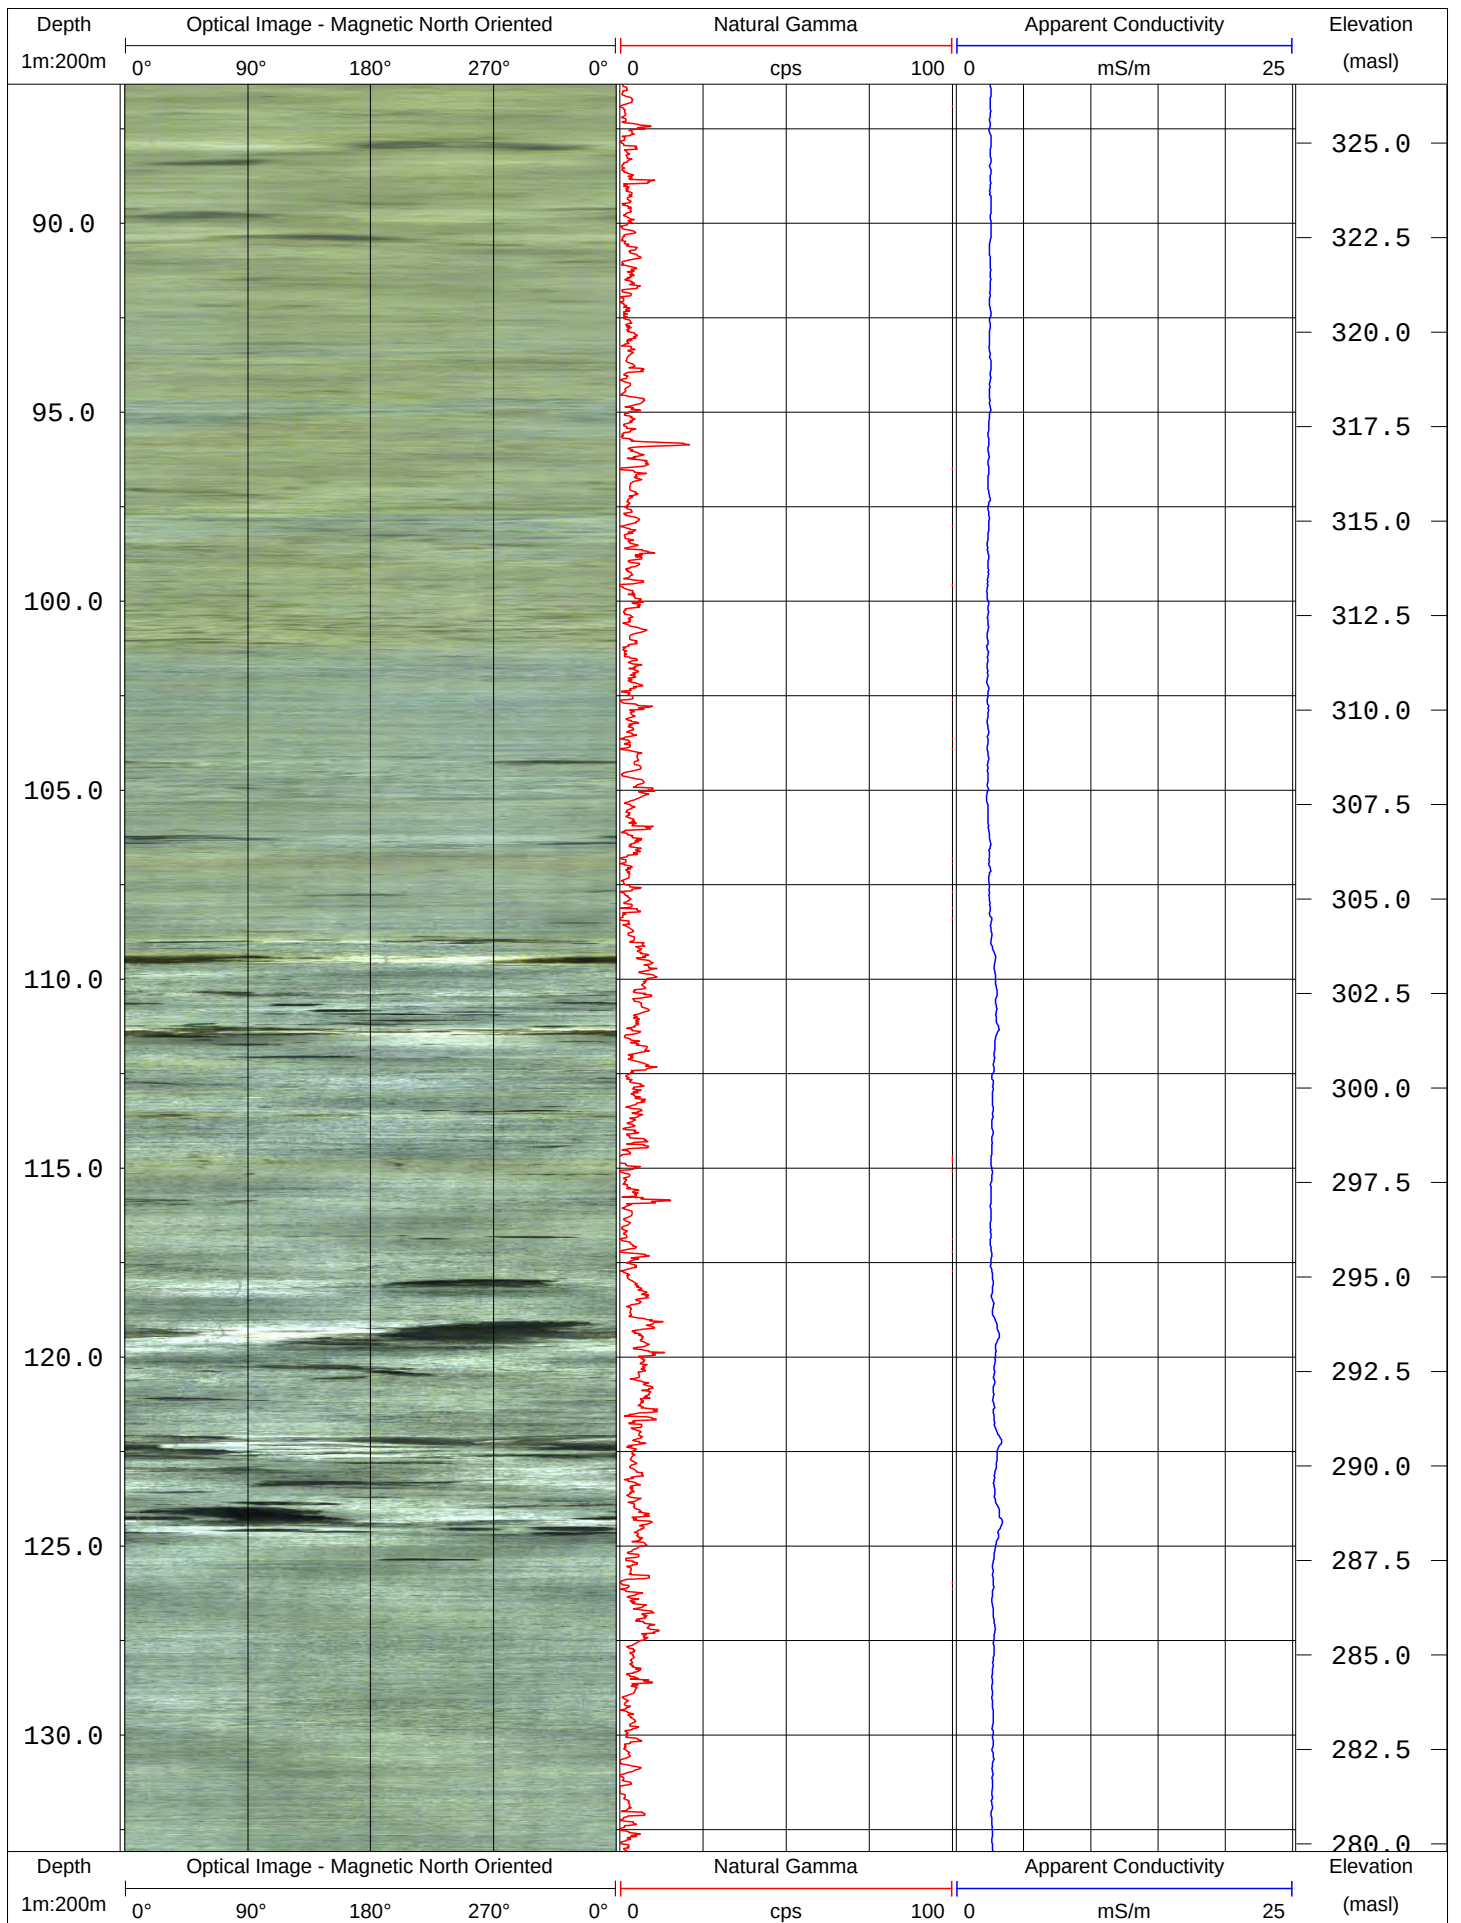

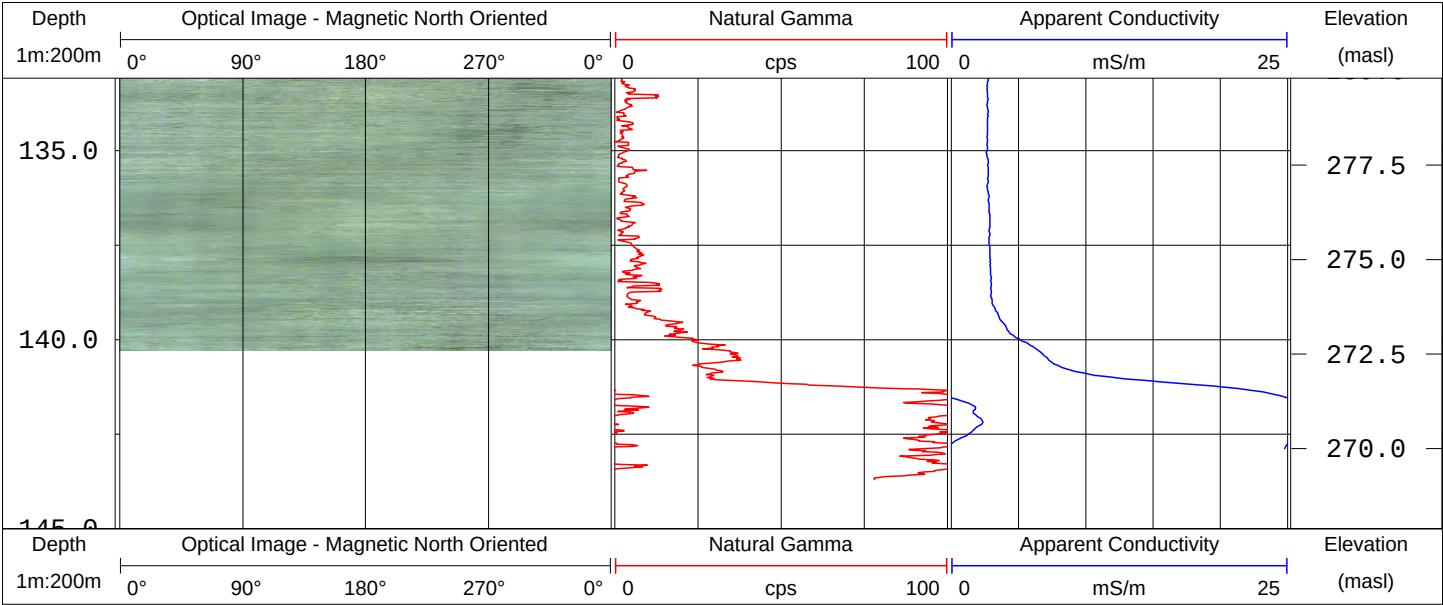



GEOPHYSICAL RECORD OF BOREHOLE MW08-T3-05


PROJECT NO. 08-1112-0021
 LOCATION Johnson Tract
 LOG DATE September 23, 2008
 LOGGED BY BB



LOG REFERENCE Ground Surface
 ELEVATION (masl) 427.59
 WATER LEVEL (mbgs) -0.085
 BORING METHOD PQ Coring
 REVIEWED BY JAP

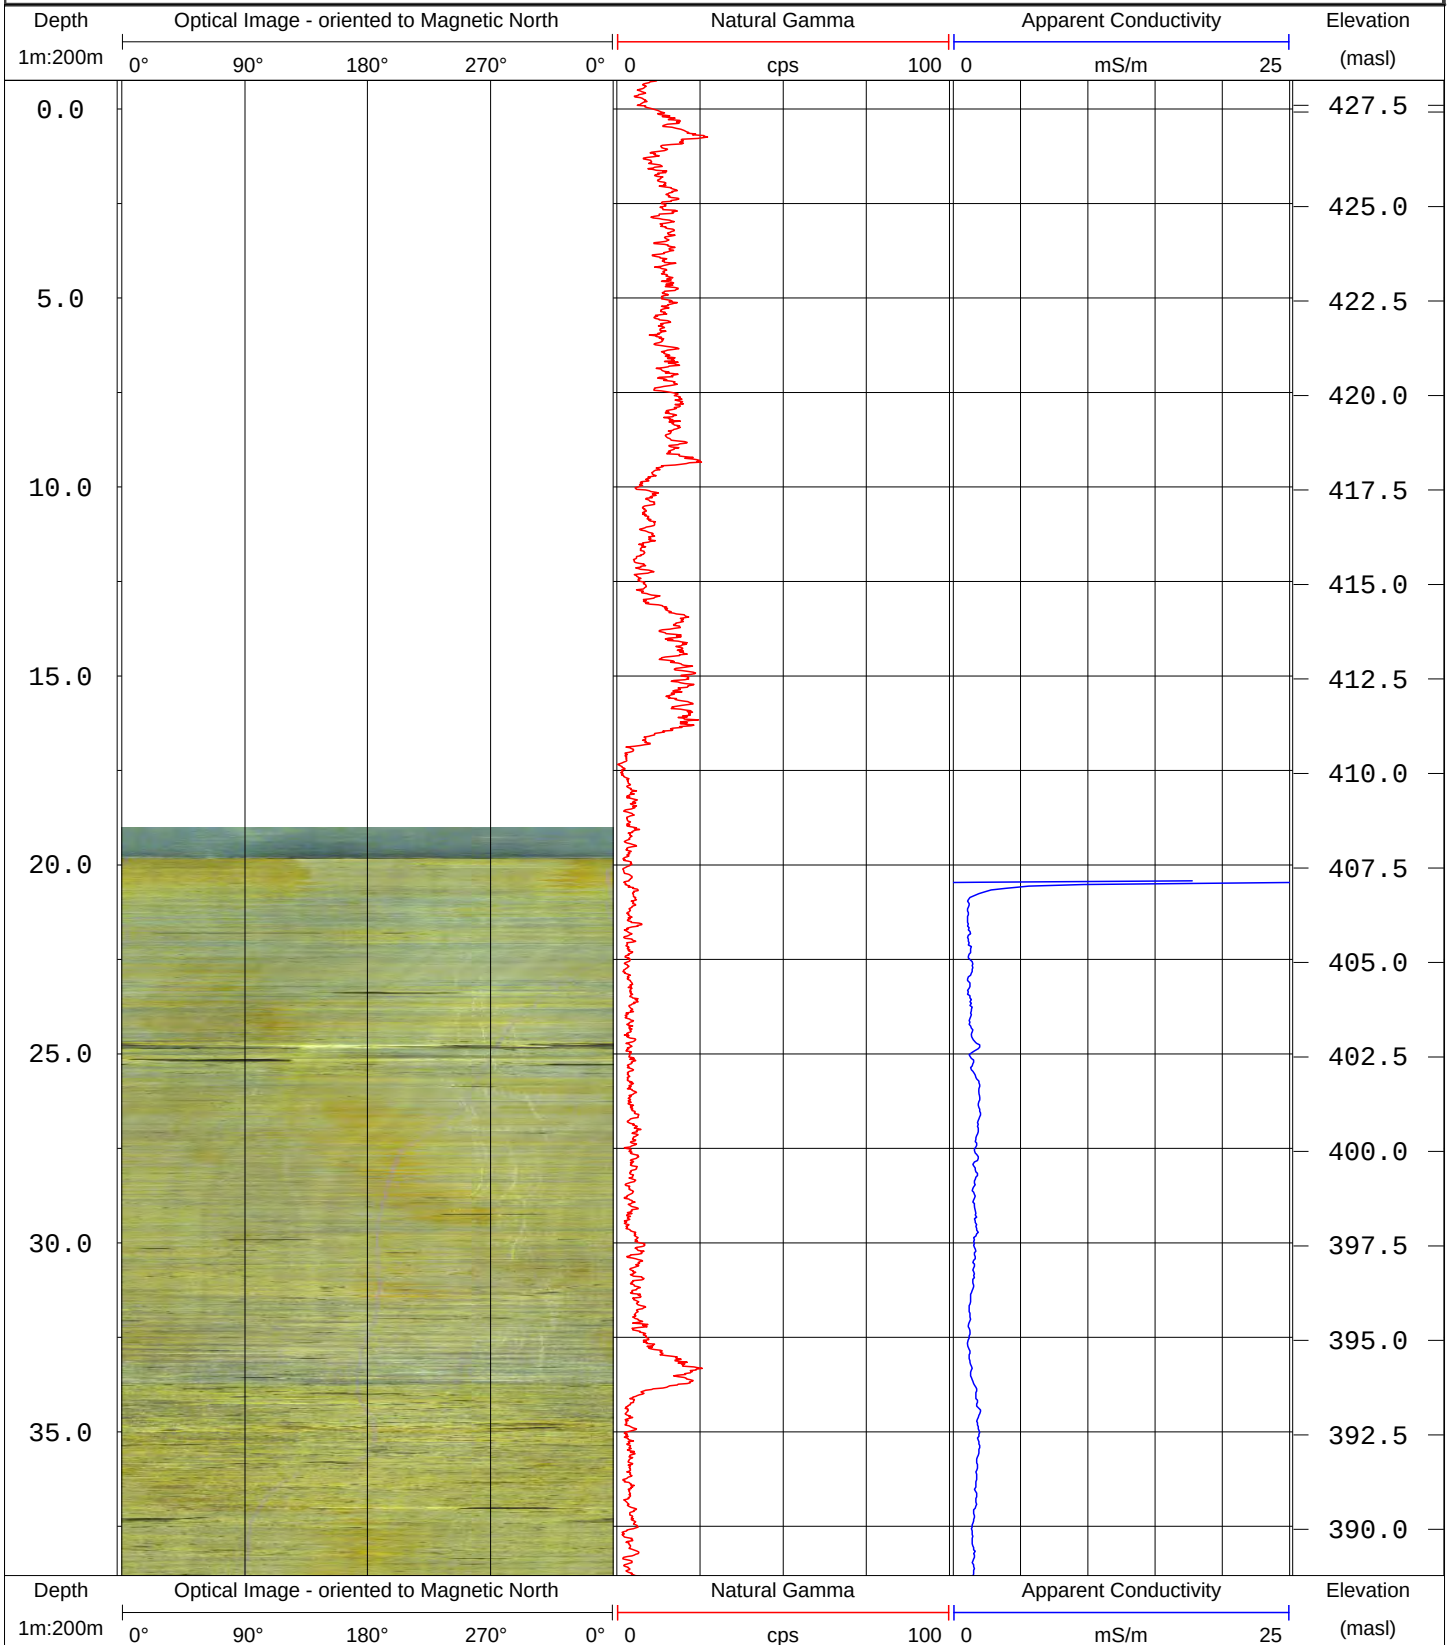

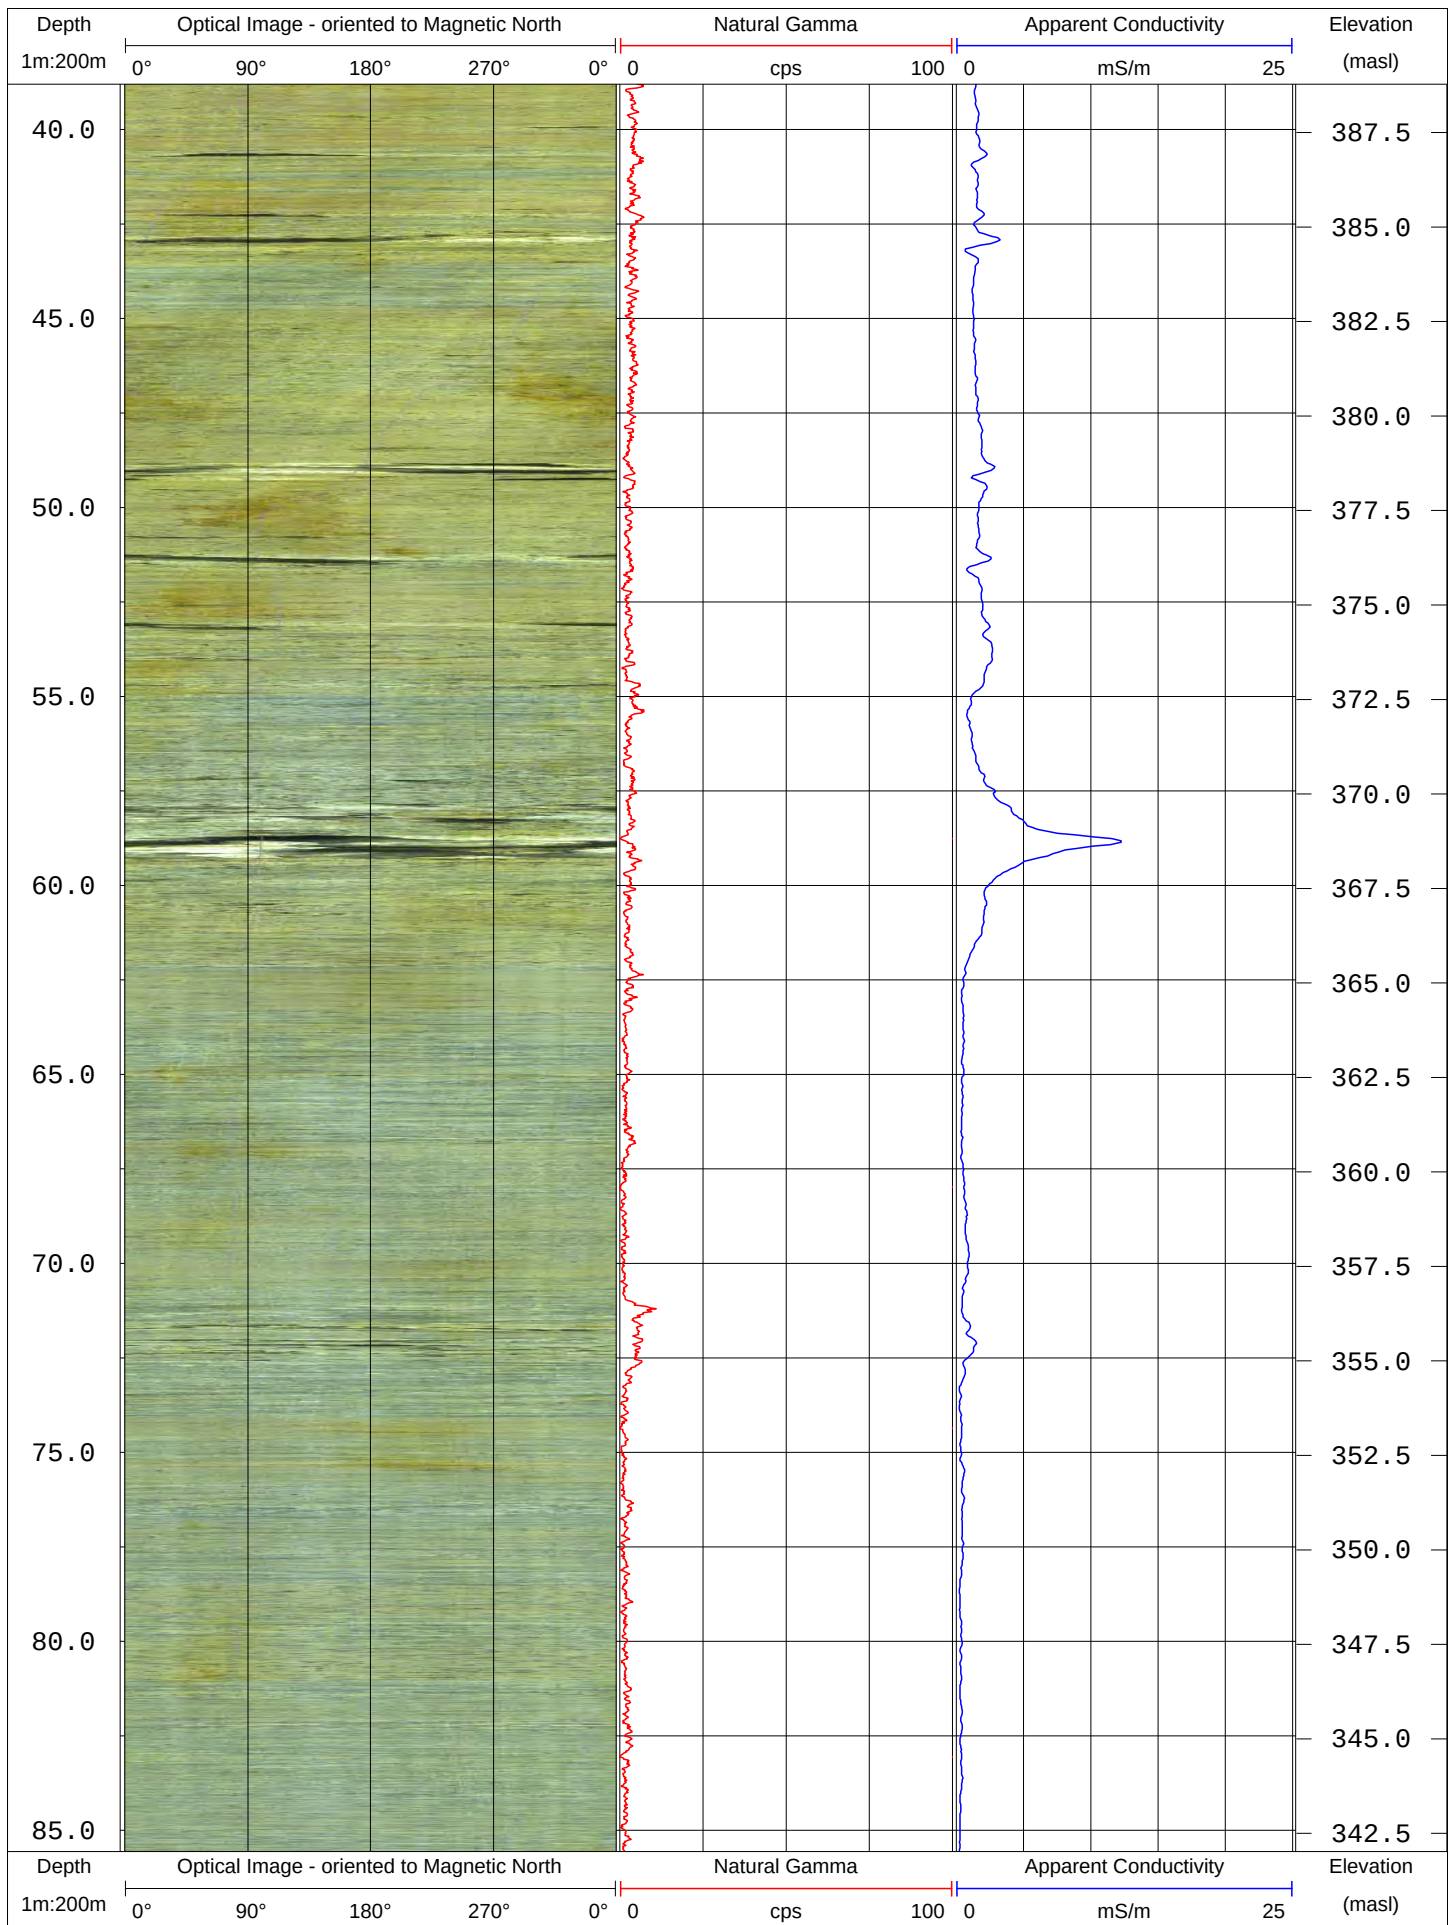

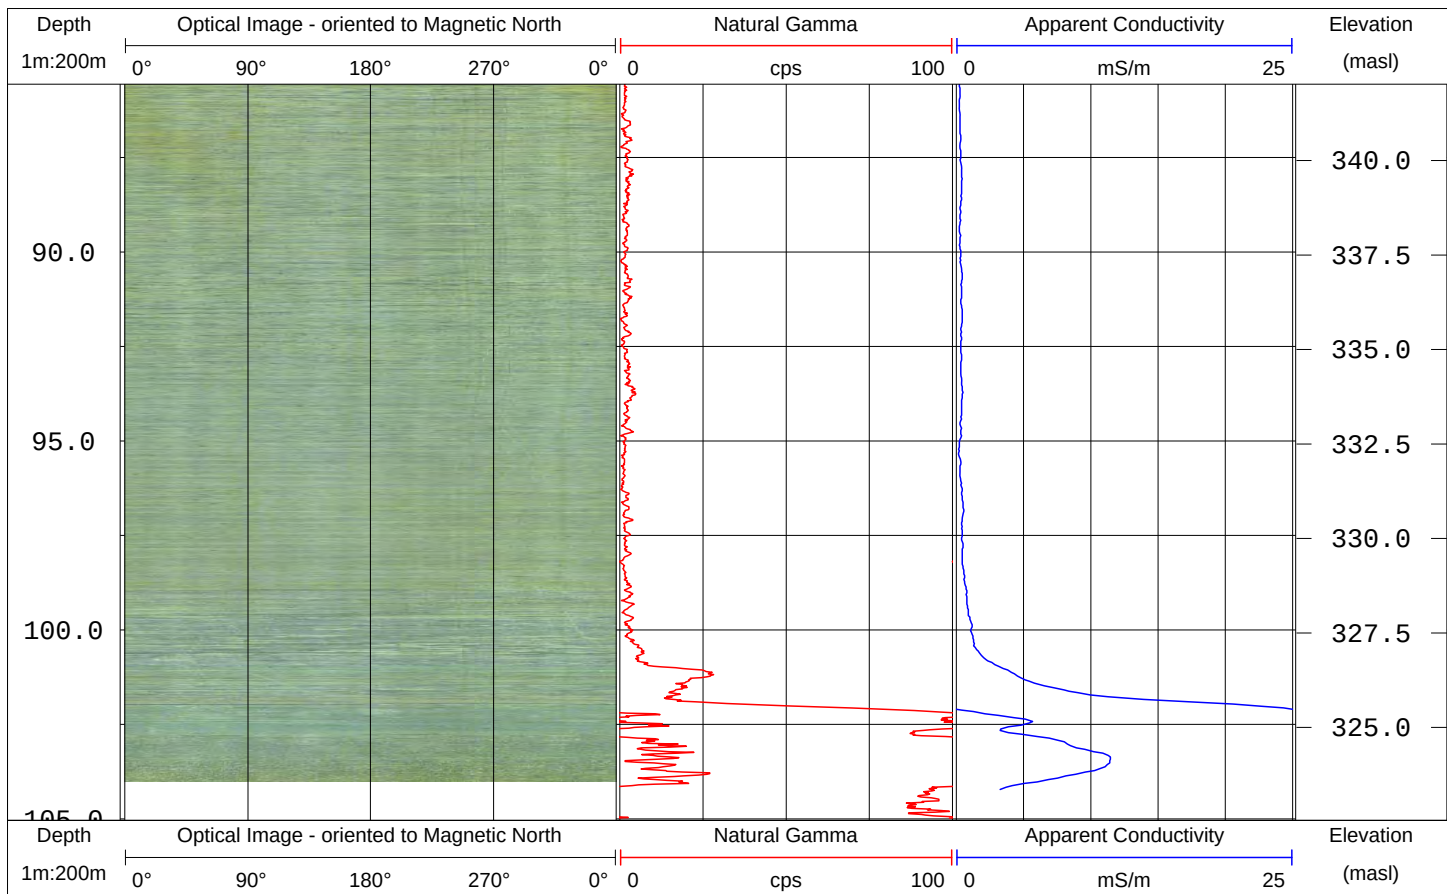



GEOPHYSICAL RECORD OF BOREHOLE MW08-T3-06

PROJECT NO. 08-1112-0021
 LOCATION GUELPH (EVERTON)
 LOG DATE October 28, 2008
 LOGGED BY BB



LOG REFERENCE Ground Surface
 ELEVATION (masl) 365.83
 WATER LEVEL (mbgs) 1.25
 BORING METHOD PQ Rotary
 REVIEWED BY JAP

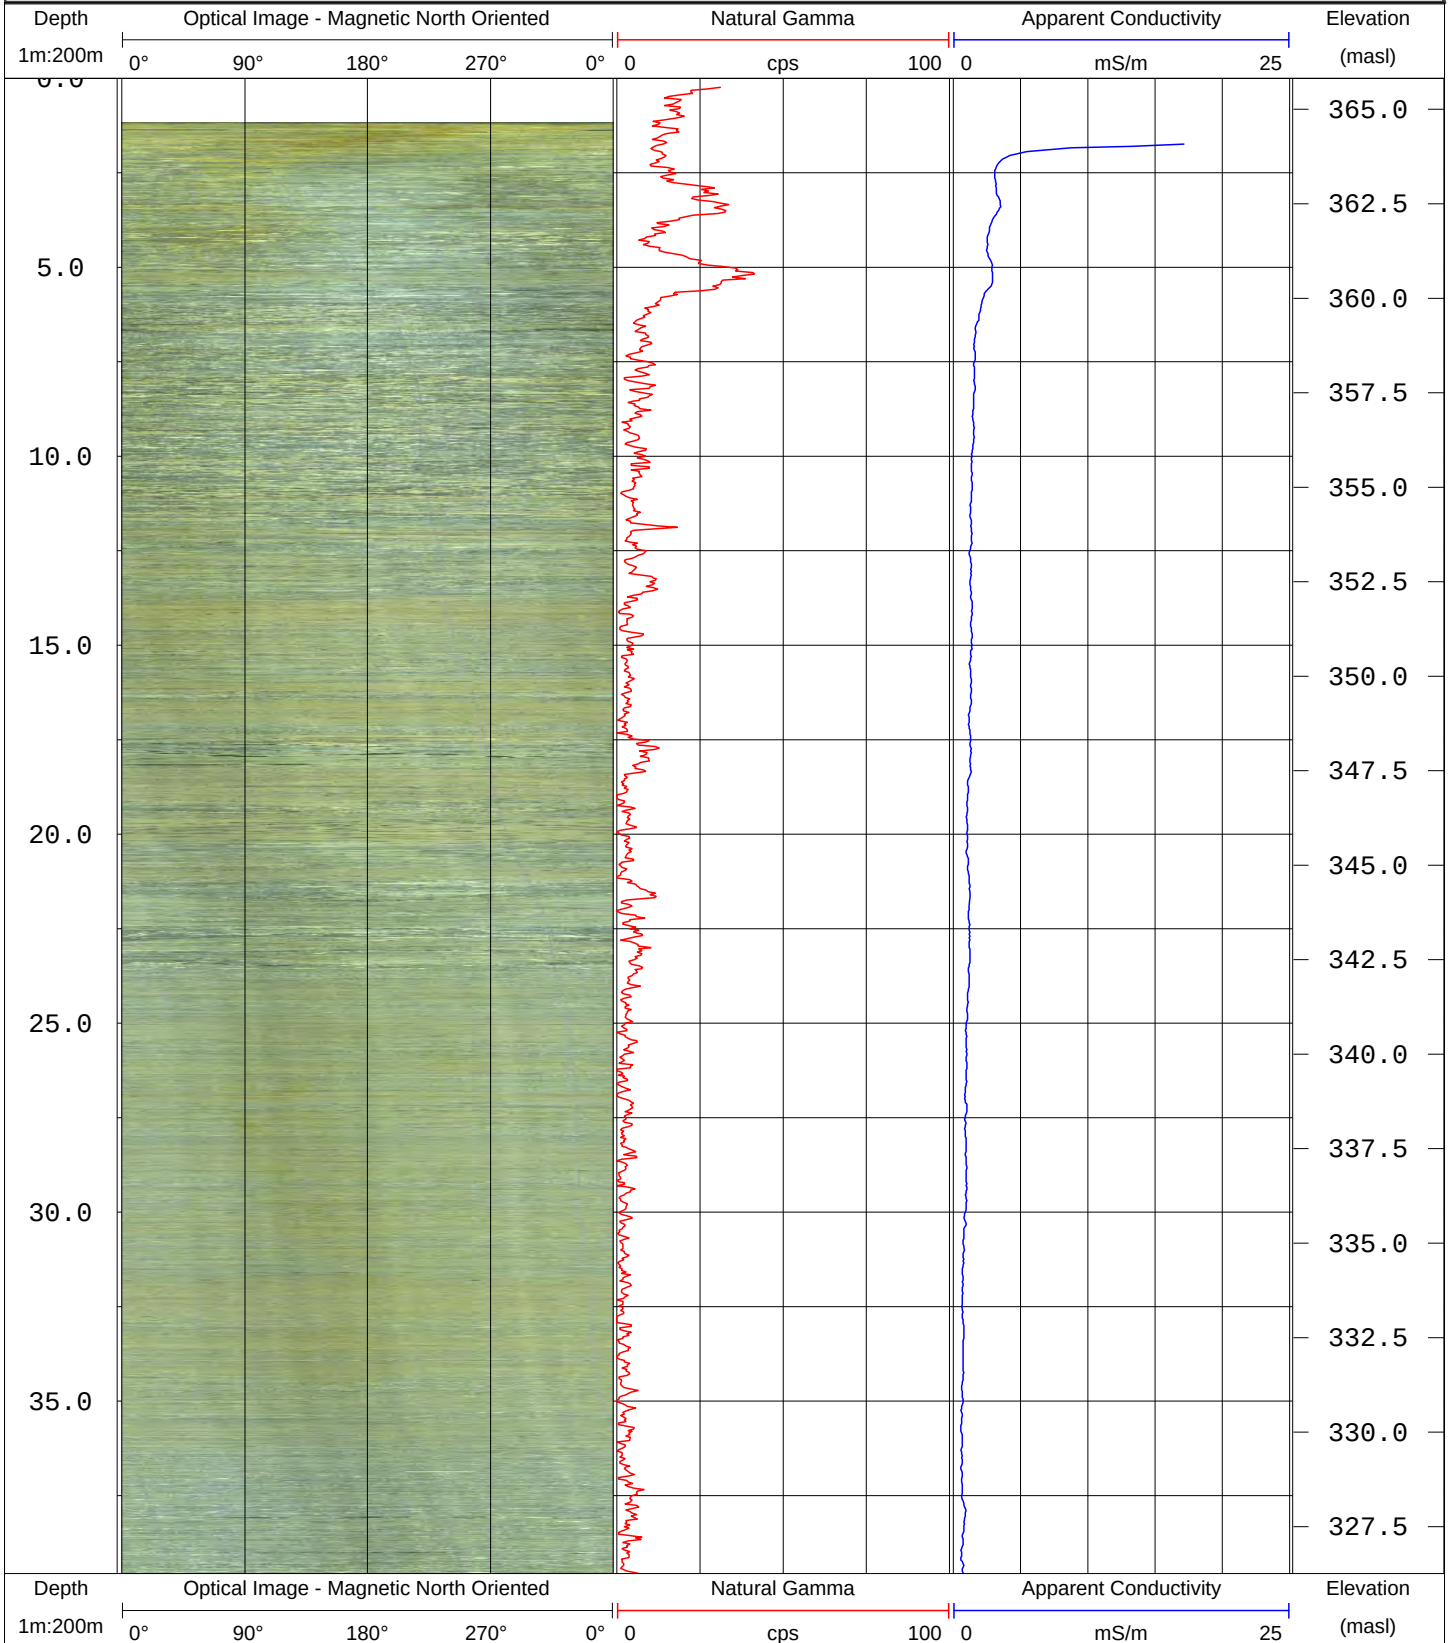

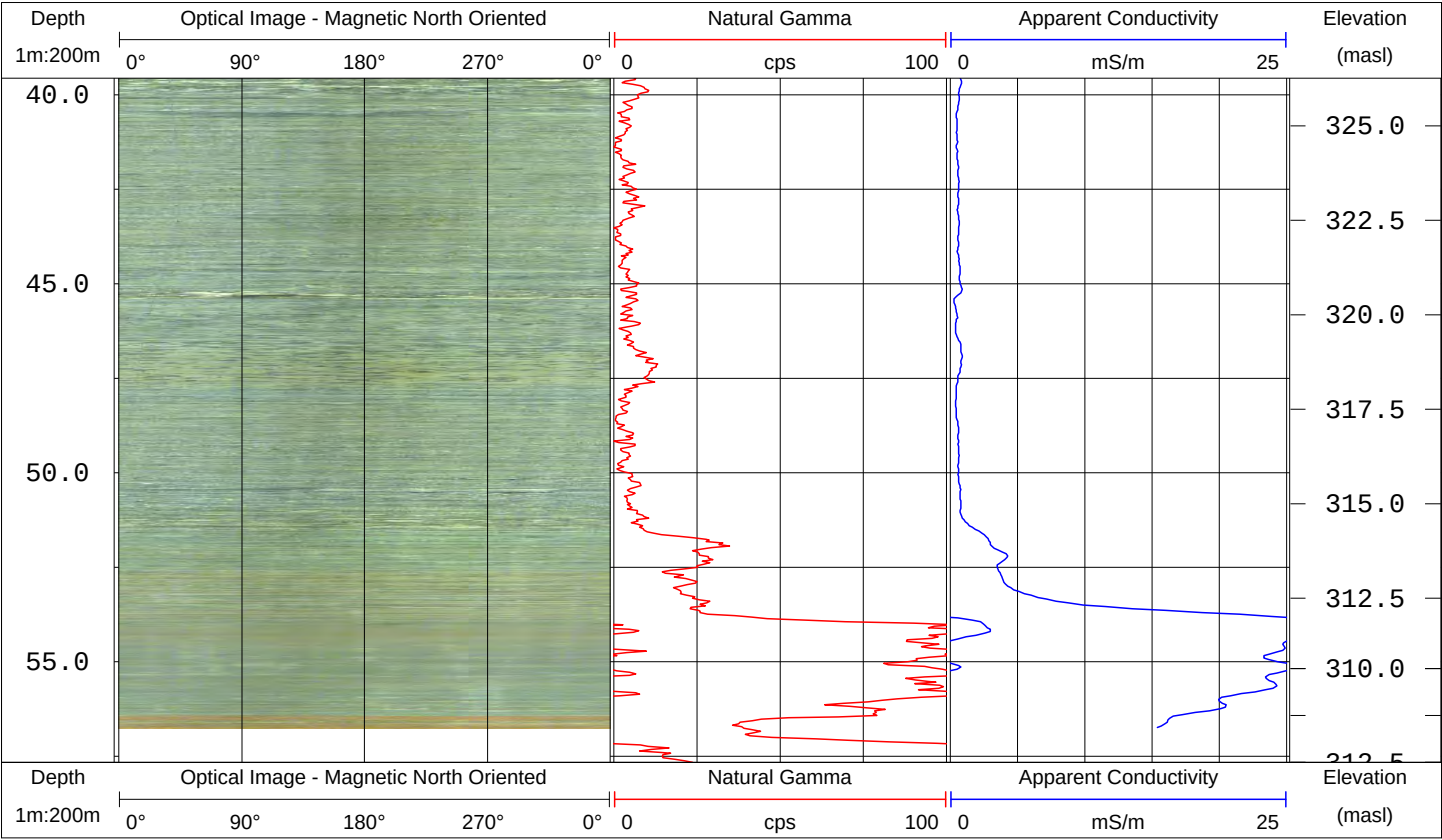



GEOPHYSICAL RECORD OF BOREHOLE MW08-T3-07

PROJECT NO. 08-1112-0021
LOCATION Wellington Rd 29, Eramosa, ON
LOG DATE October 21, 2008
LOGGED BY AR, BB



LOG REFERENCE Ground Surface
ELEVATION (masl) 354.29
WATER LEVEL (mbgs) 11.19
BORING METHOD Air Rotary (Tri-cone)
REVIEWED BY JAP

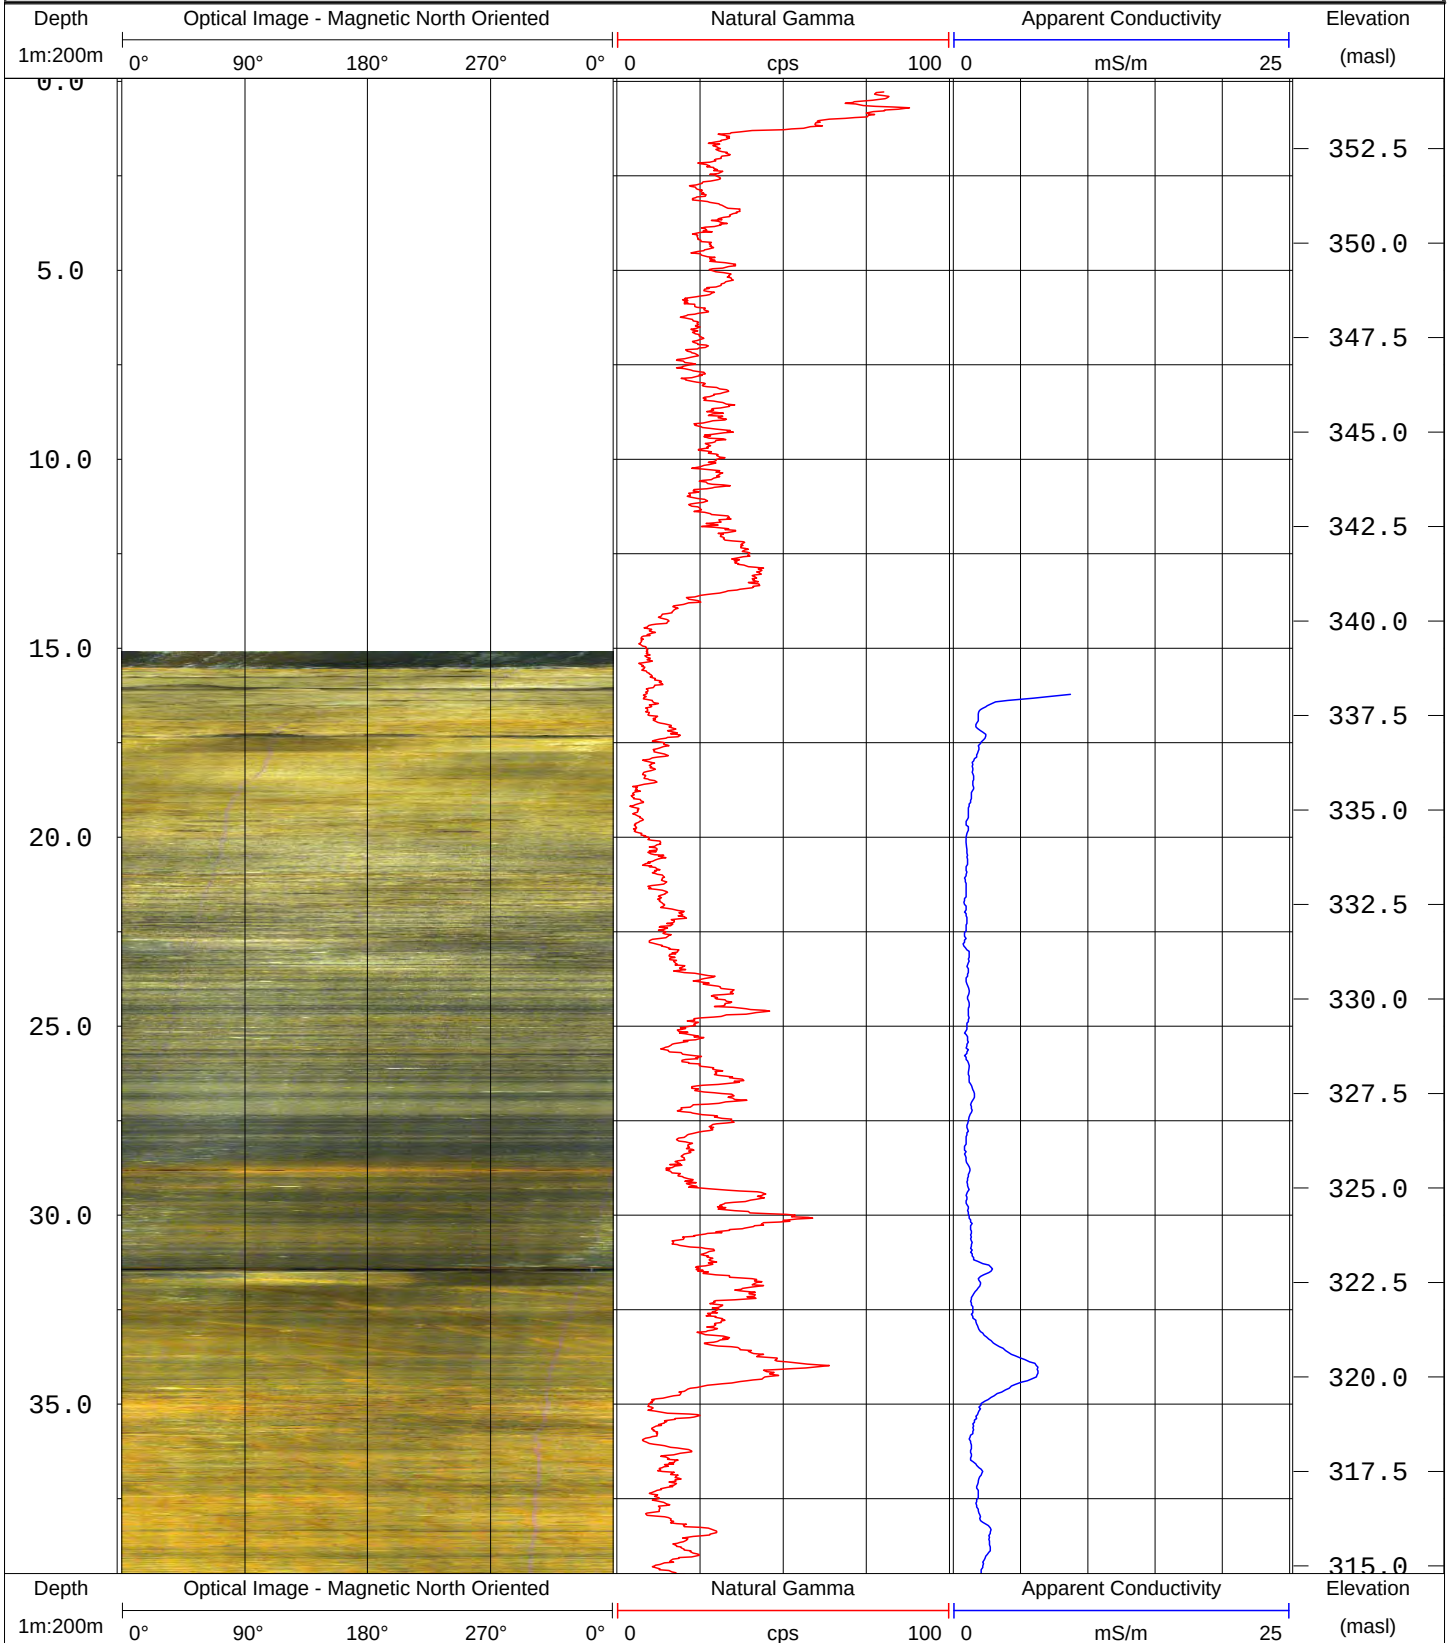

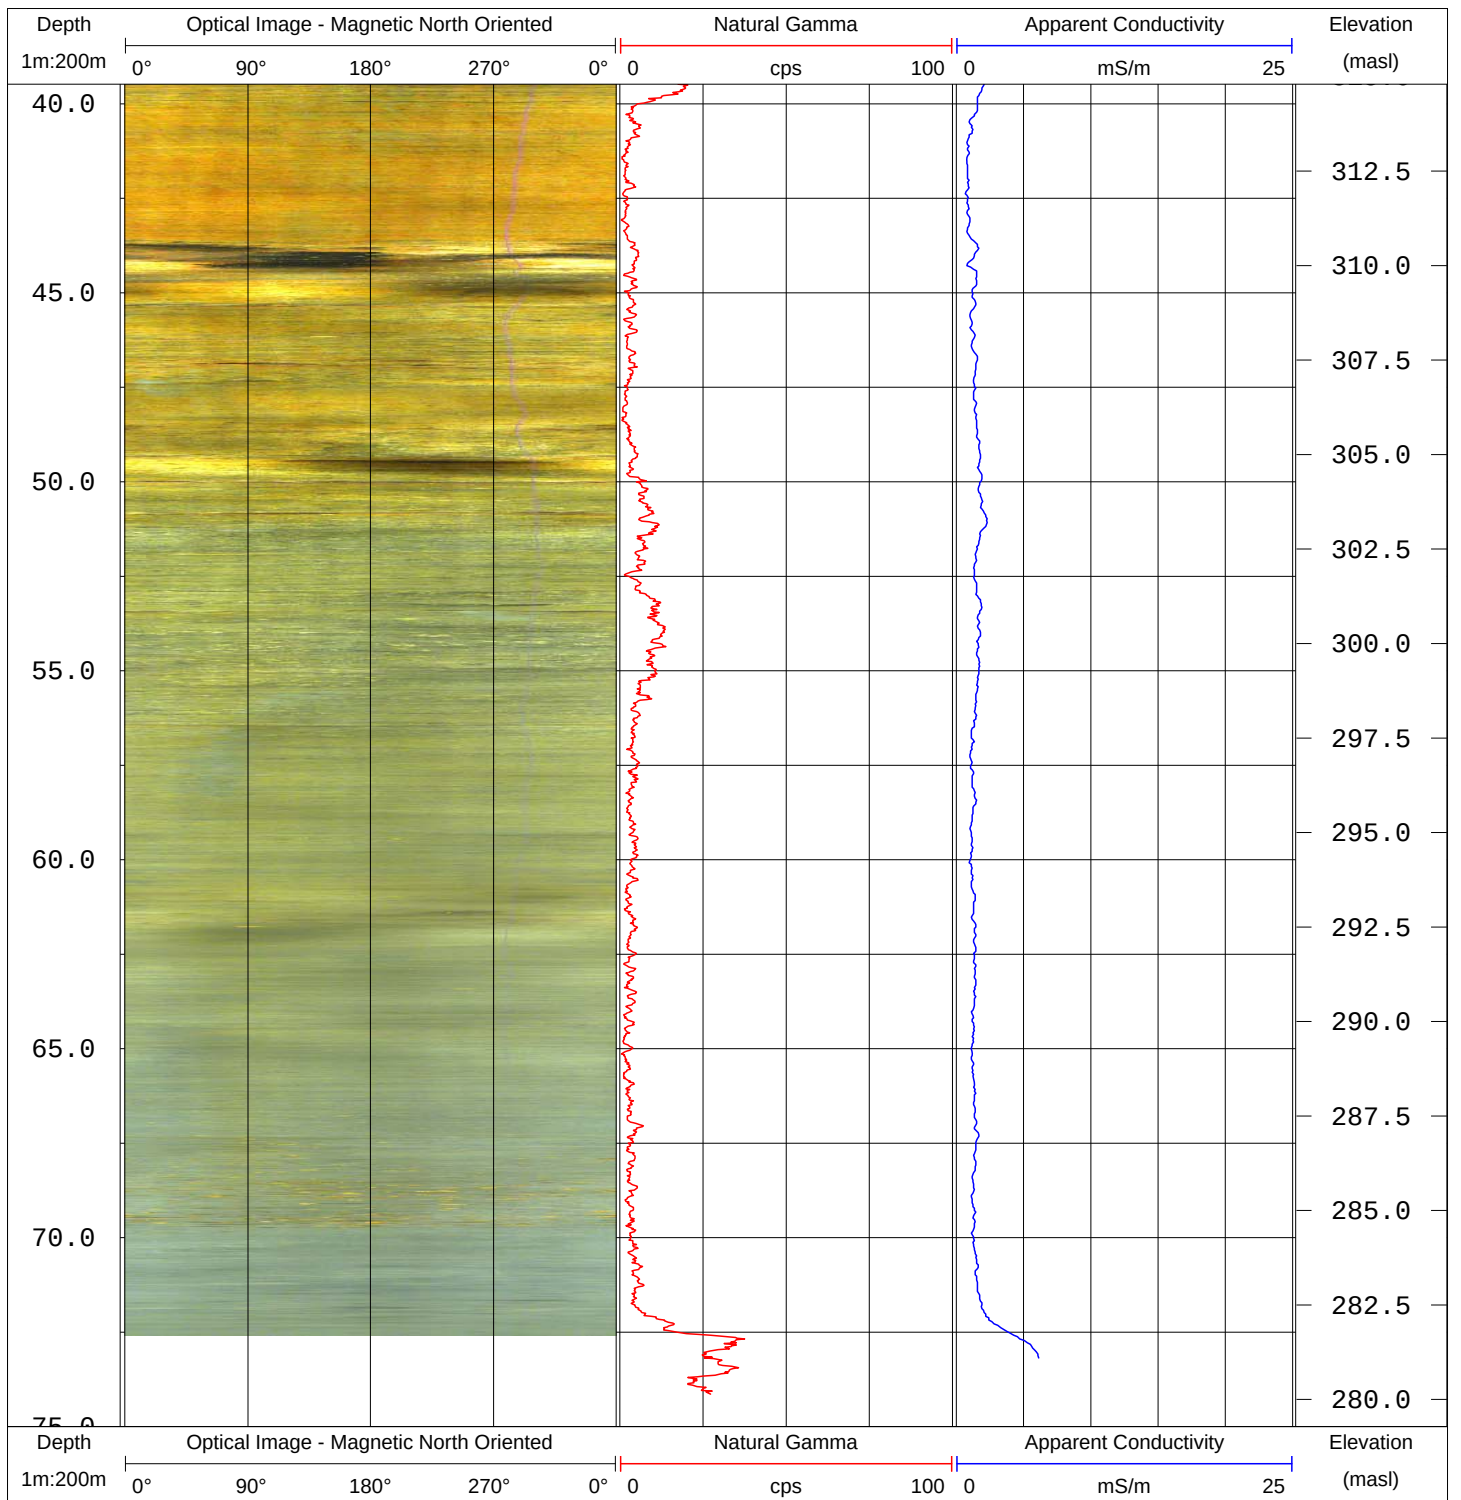



GEOPHYSICAL RECORD OF BOREHOLE MW08-T3-08

PROJECT NO. 08-1112-0021
 LOCATION Kaine Hill Drive
 LOG DATE August 8, 2008
 LOGGED BY BB



LOG REFERENCE
 ELEVATION (masl) 345.33
 WATER LEVEL (mbgs) 11.44
 BORING METHOD Air Rotary (Tri-cone)
 REVIEWED BY JAP

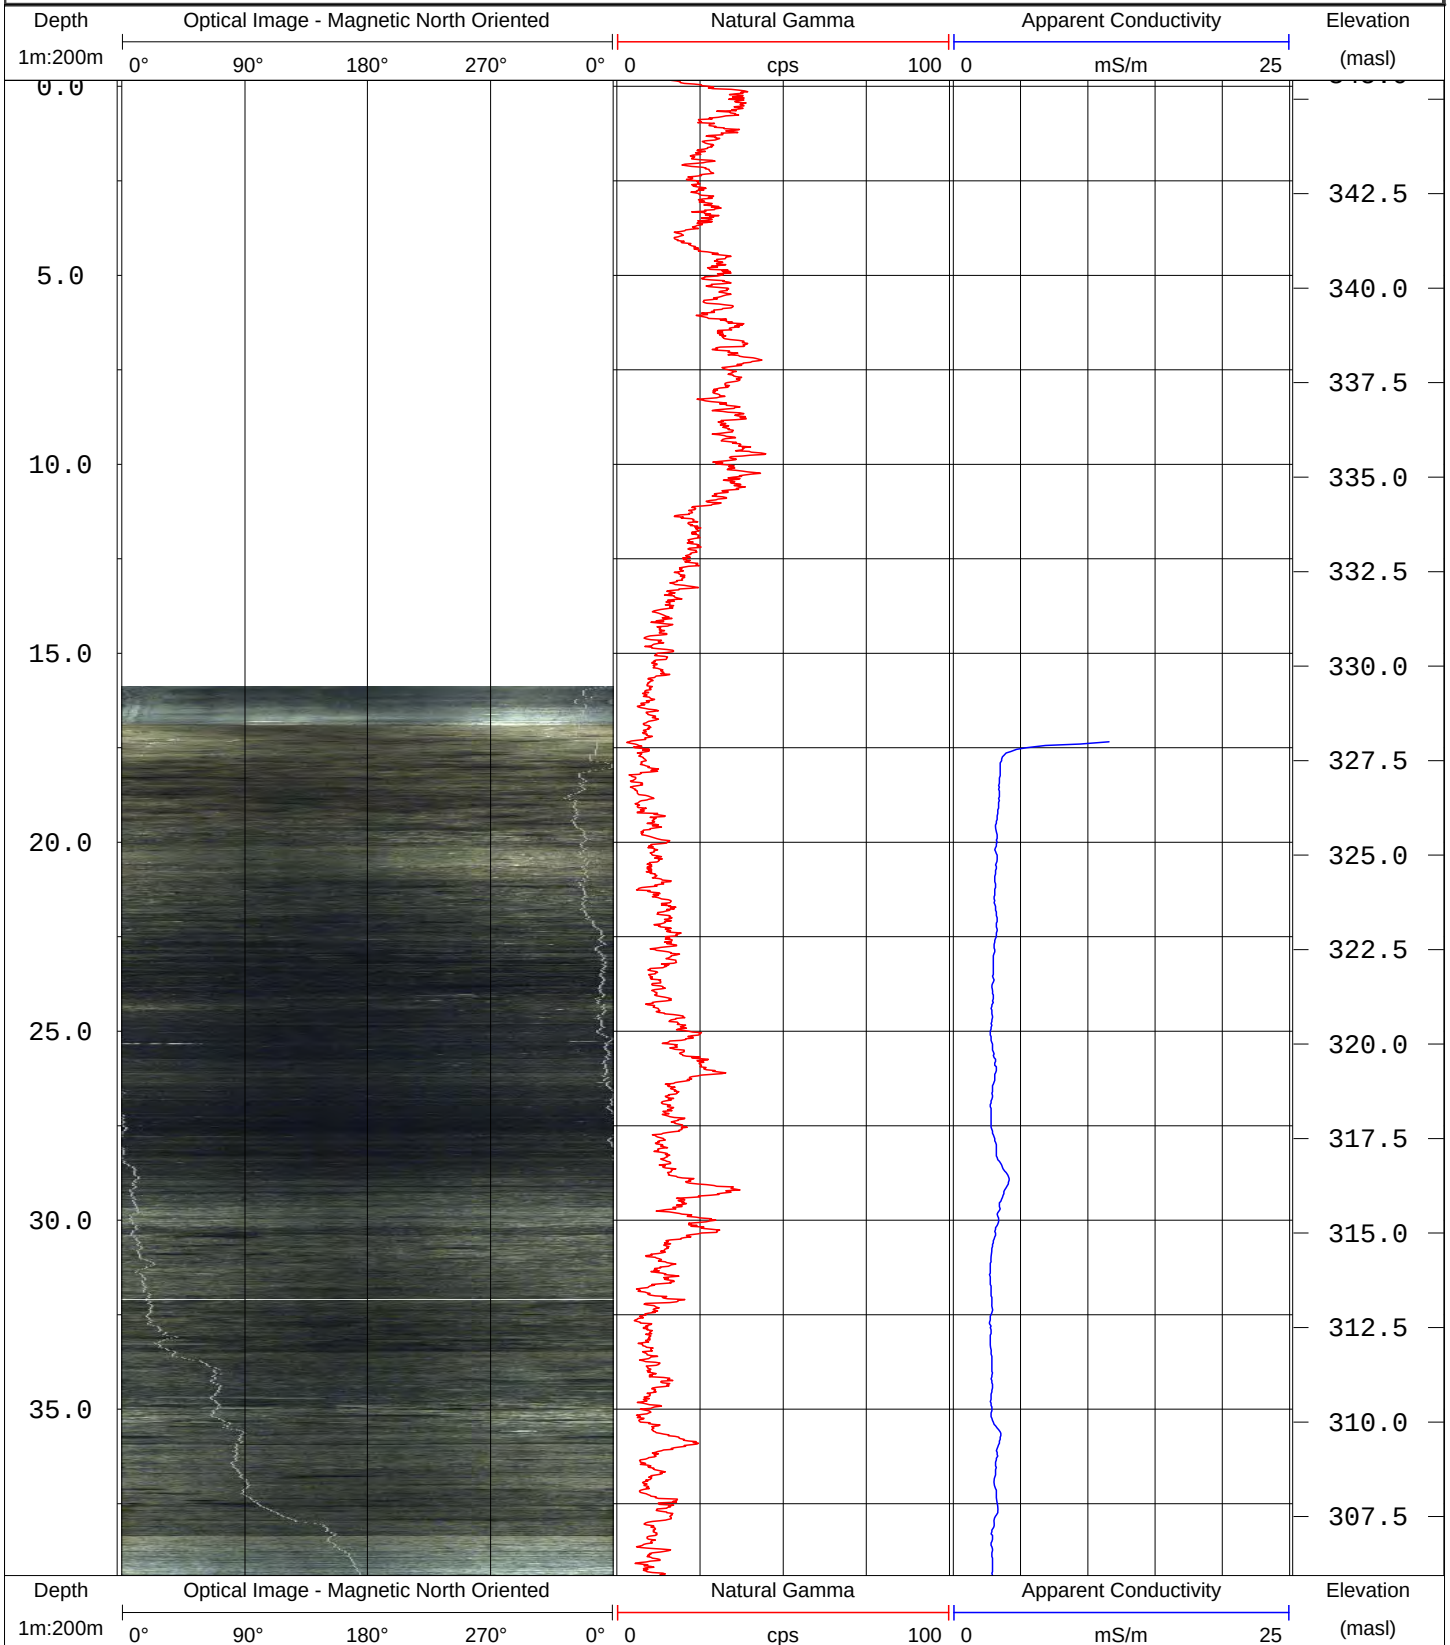

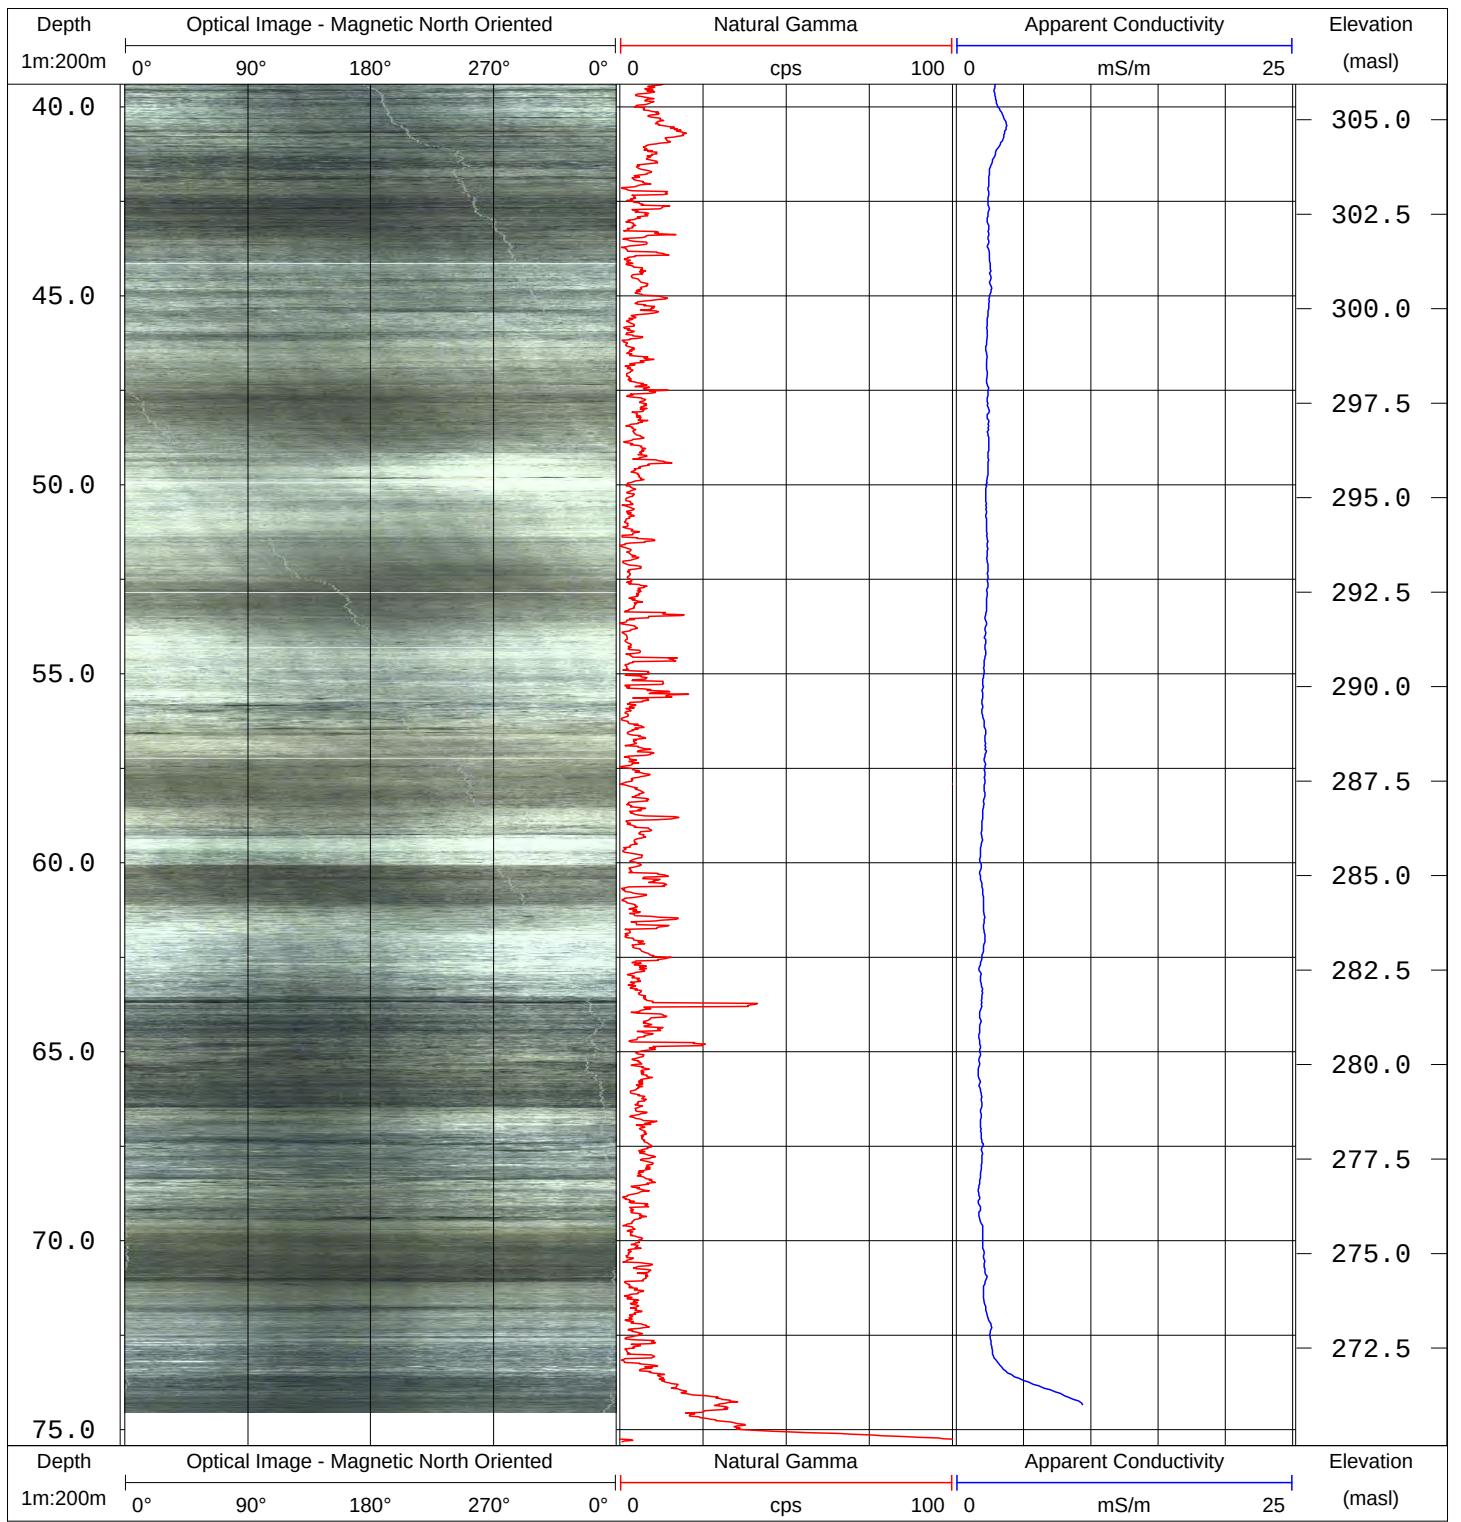



GEOPHYSICAL RECORD OF BOREHOLE MW08-T3-09


PROJECT NO. 08-1112-0021
 LOCATION Crawford Tract (Conc. 11)
 LOG DATE September 5, 2008
 LOGGED BY BB



LOG REFERENCE Ground Surface
 ELEVATION (masl) 346.47
 WATER LEVEL (mbgs) 18.19
 BORING METHOD Air Rotary (Tri-cone)
 REVIEWED BY JAP

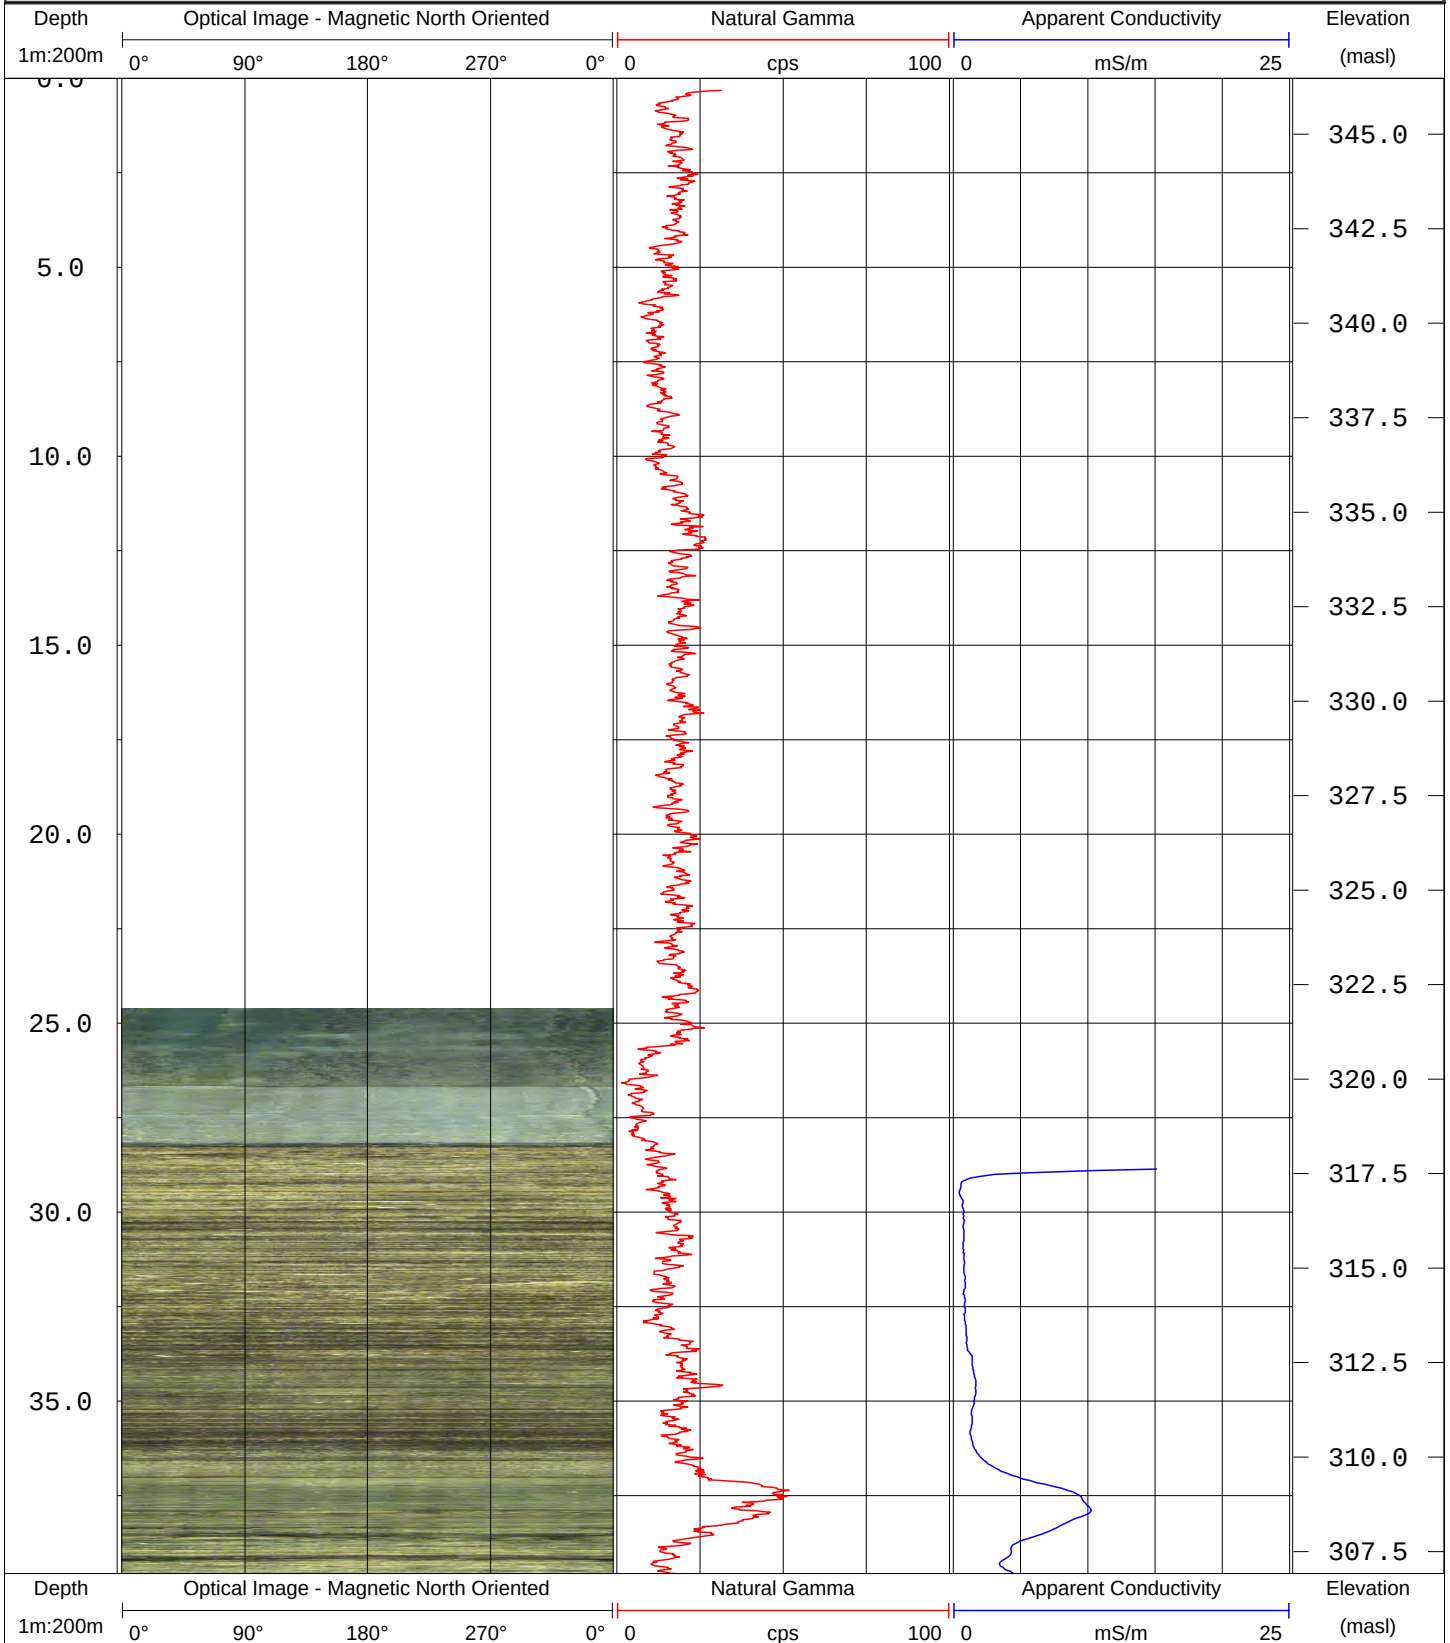

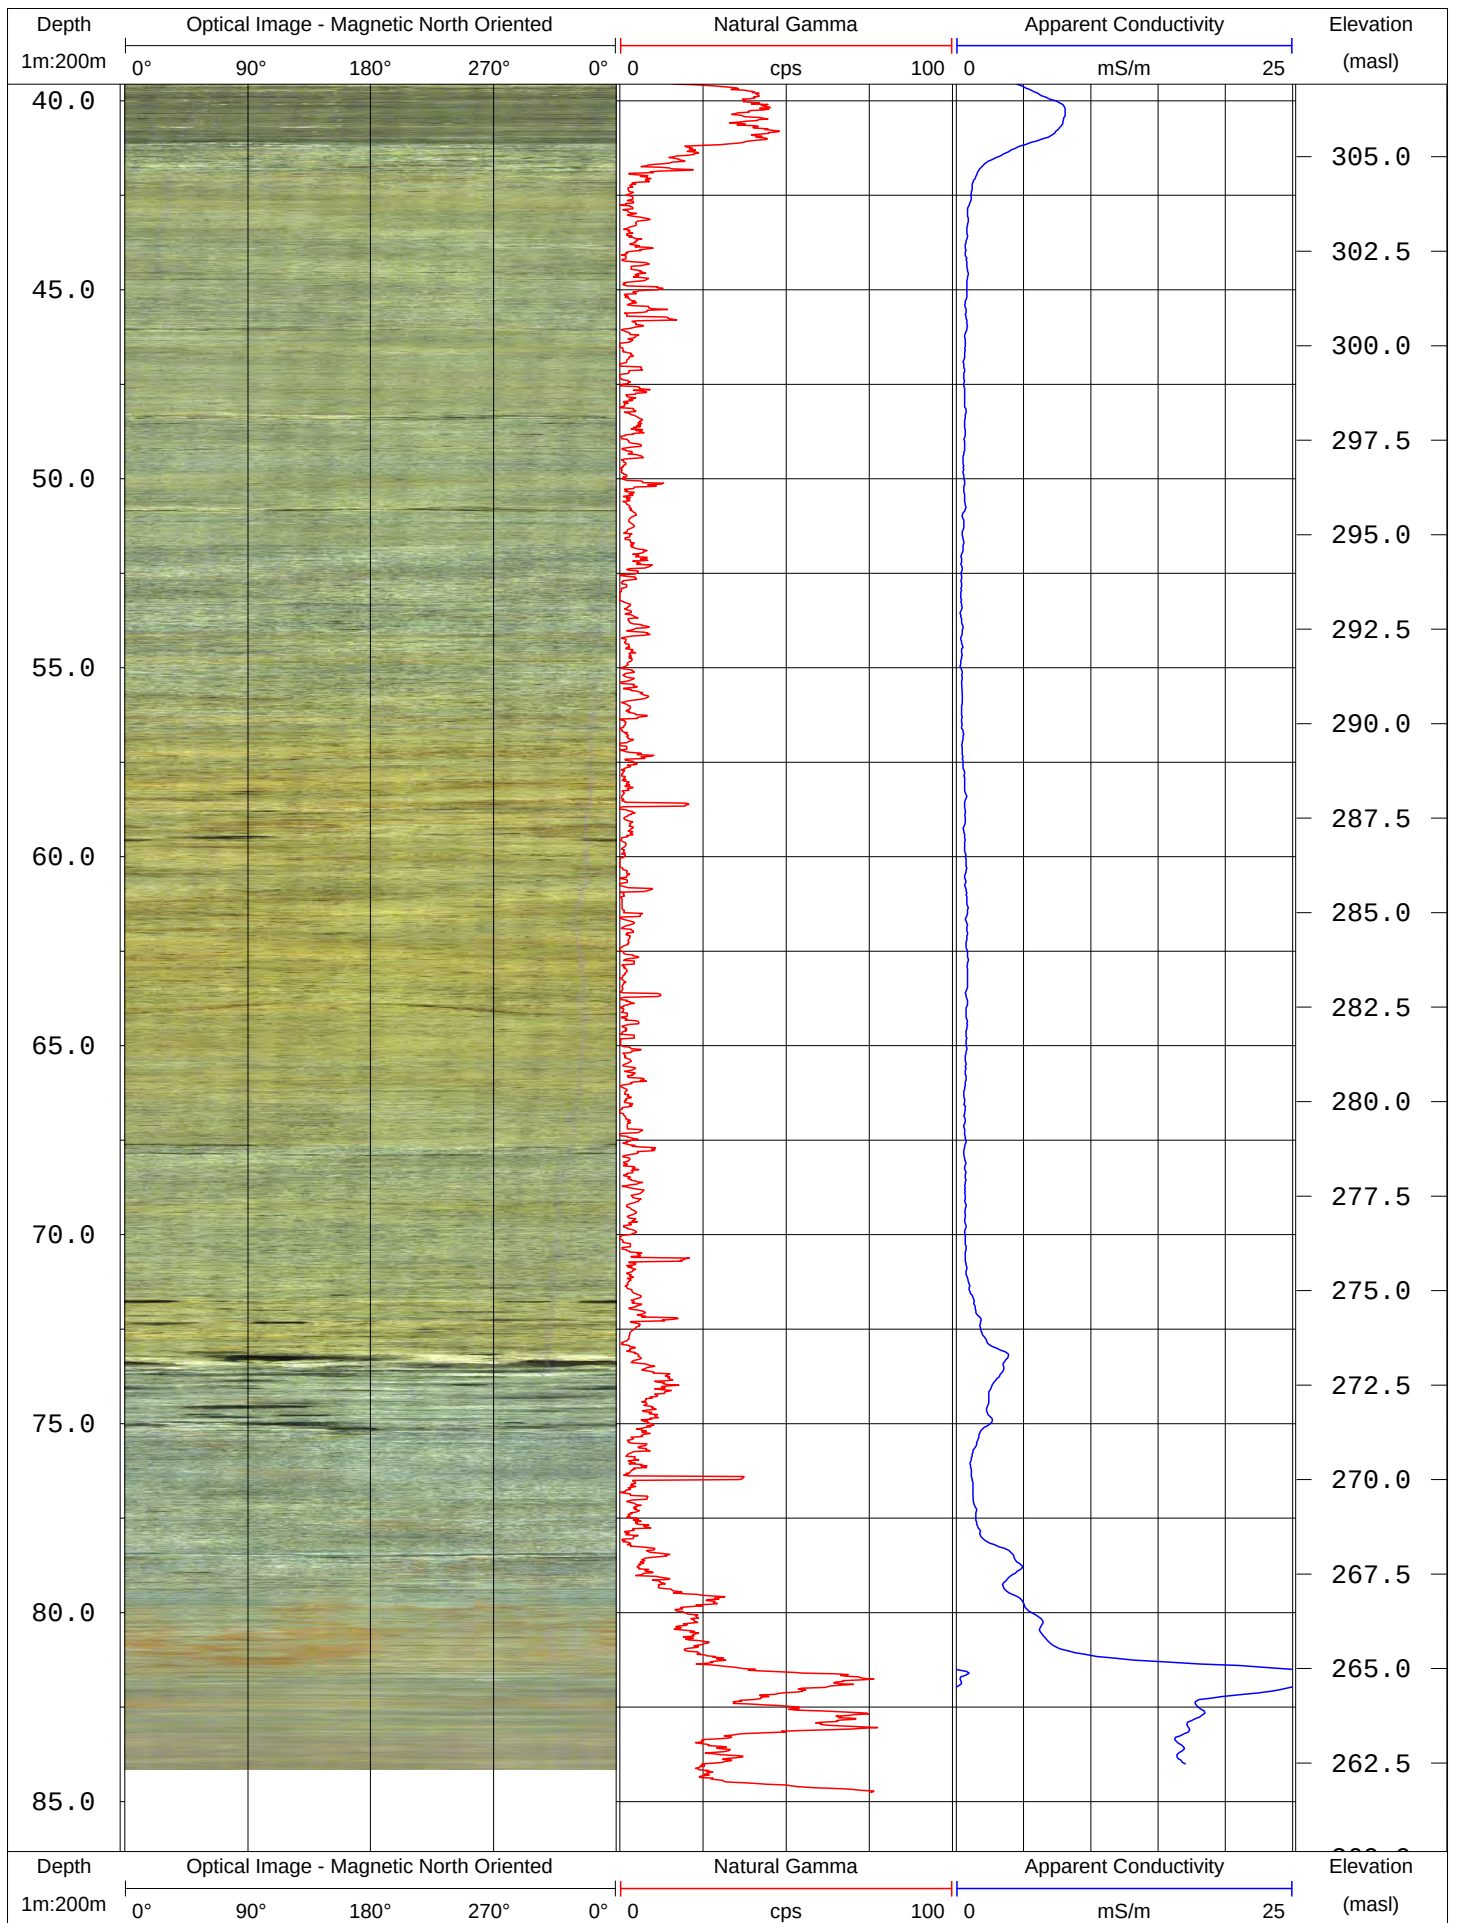

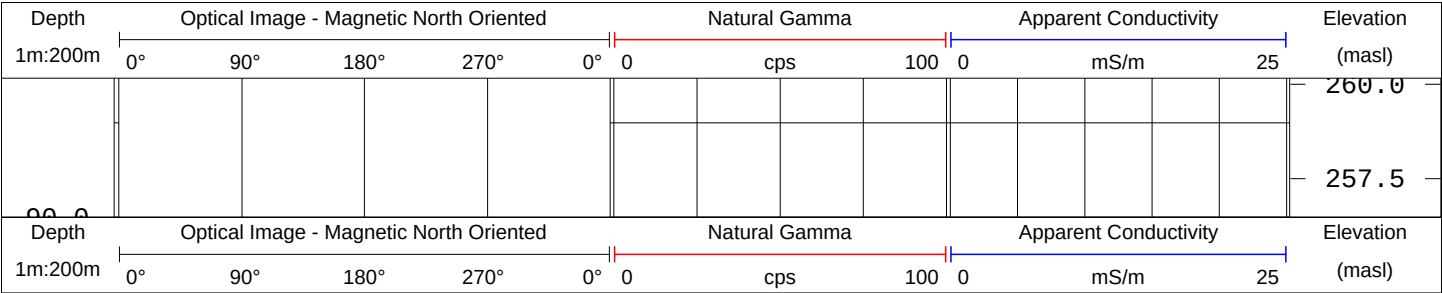



GEOPHYSICAL RECORD OF BOREHOLE MW08-T3-10


PROJECT NO. 08-1112-0021
 LOCATION Vance Tract
 LOG DATE August 11, 2008
 LOGGED BY BB



LOG REFERENCE Ground Surface
 ELEVATION (masl) 330.31
 WATER LEVEL (mbgs) 12.95
 BORING METHOD Air Rotary (Tri-cone)
 REVIEWED BY JAP

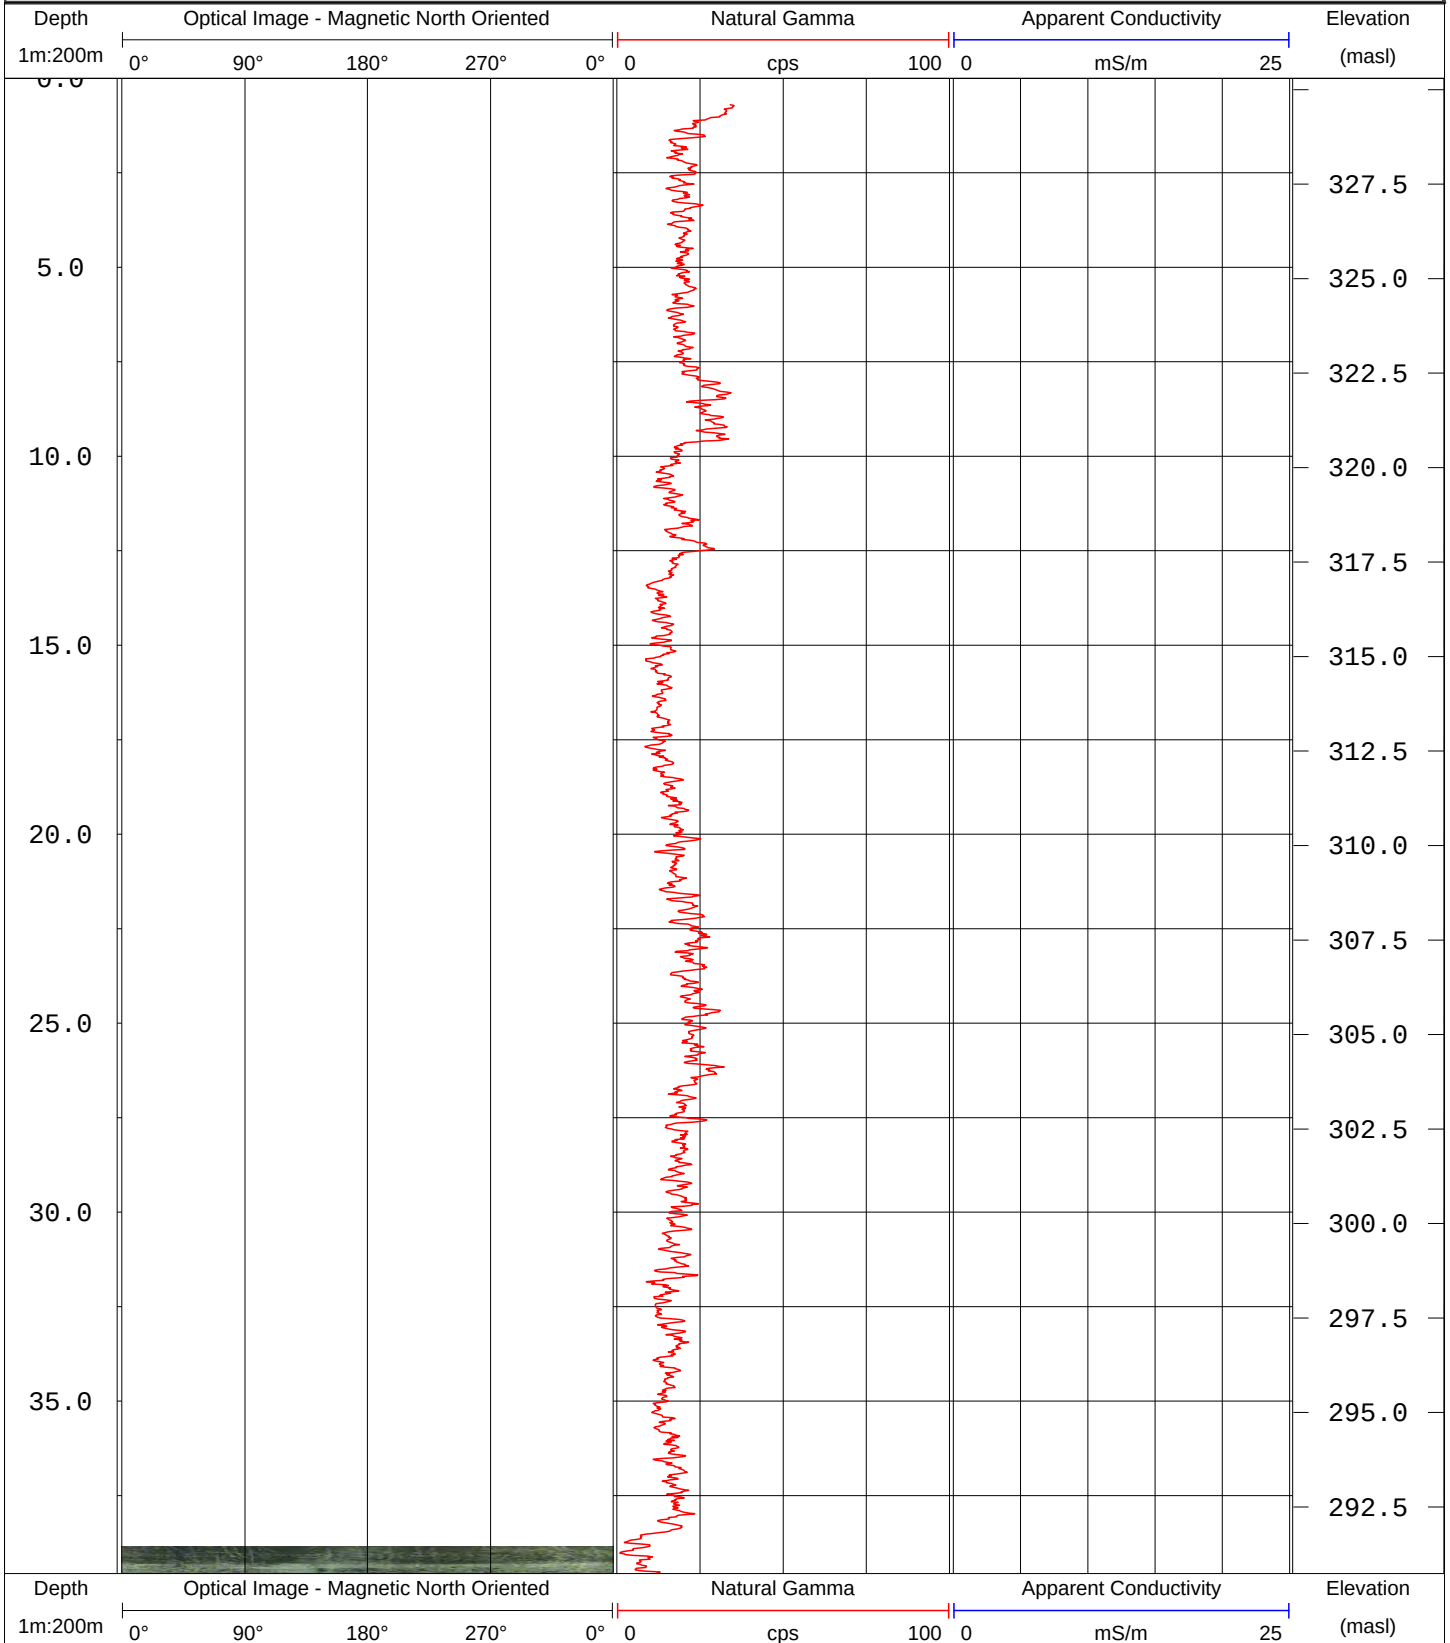

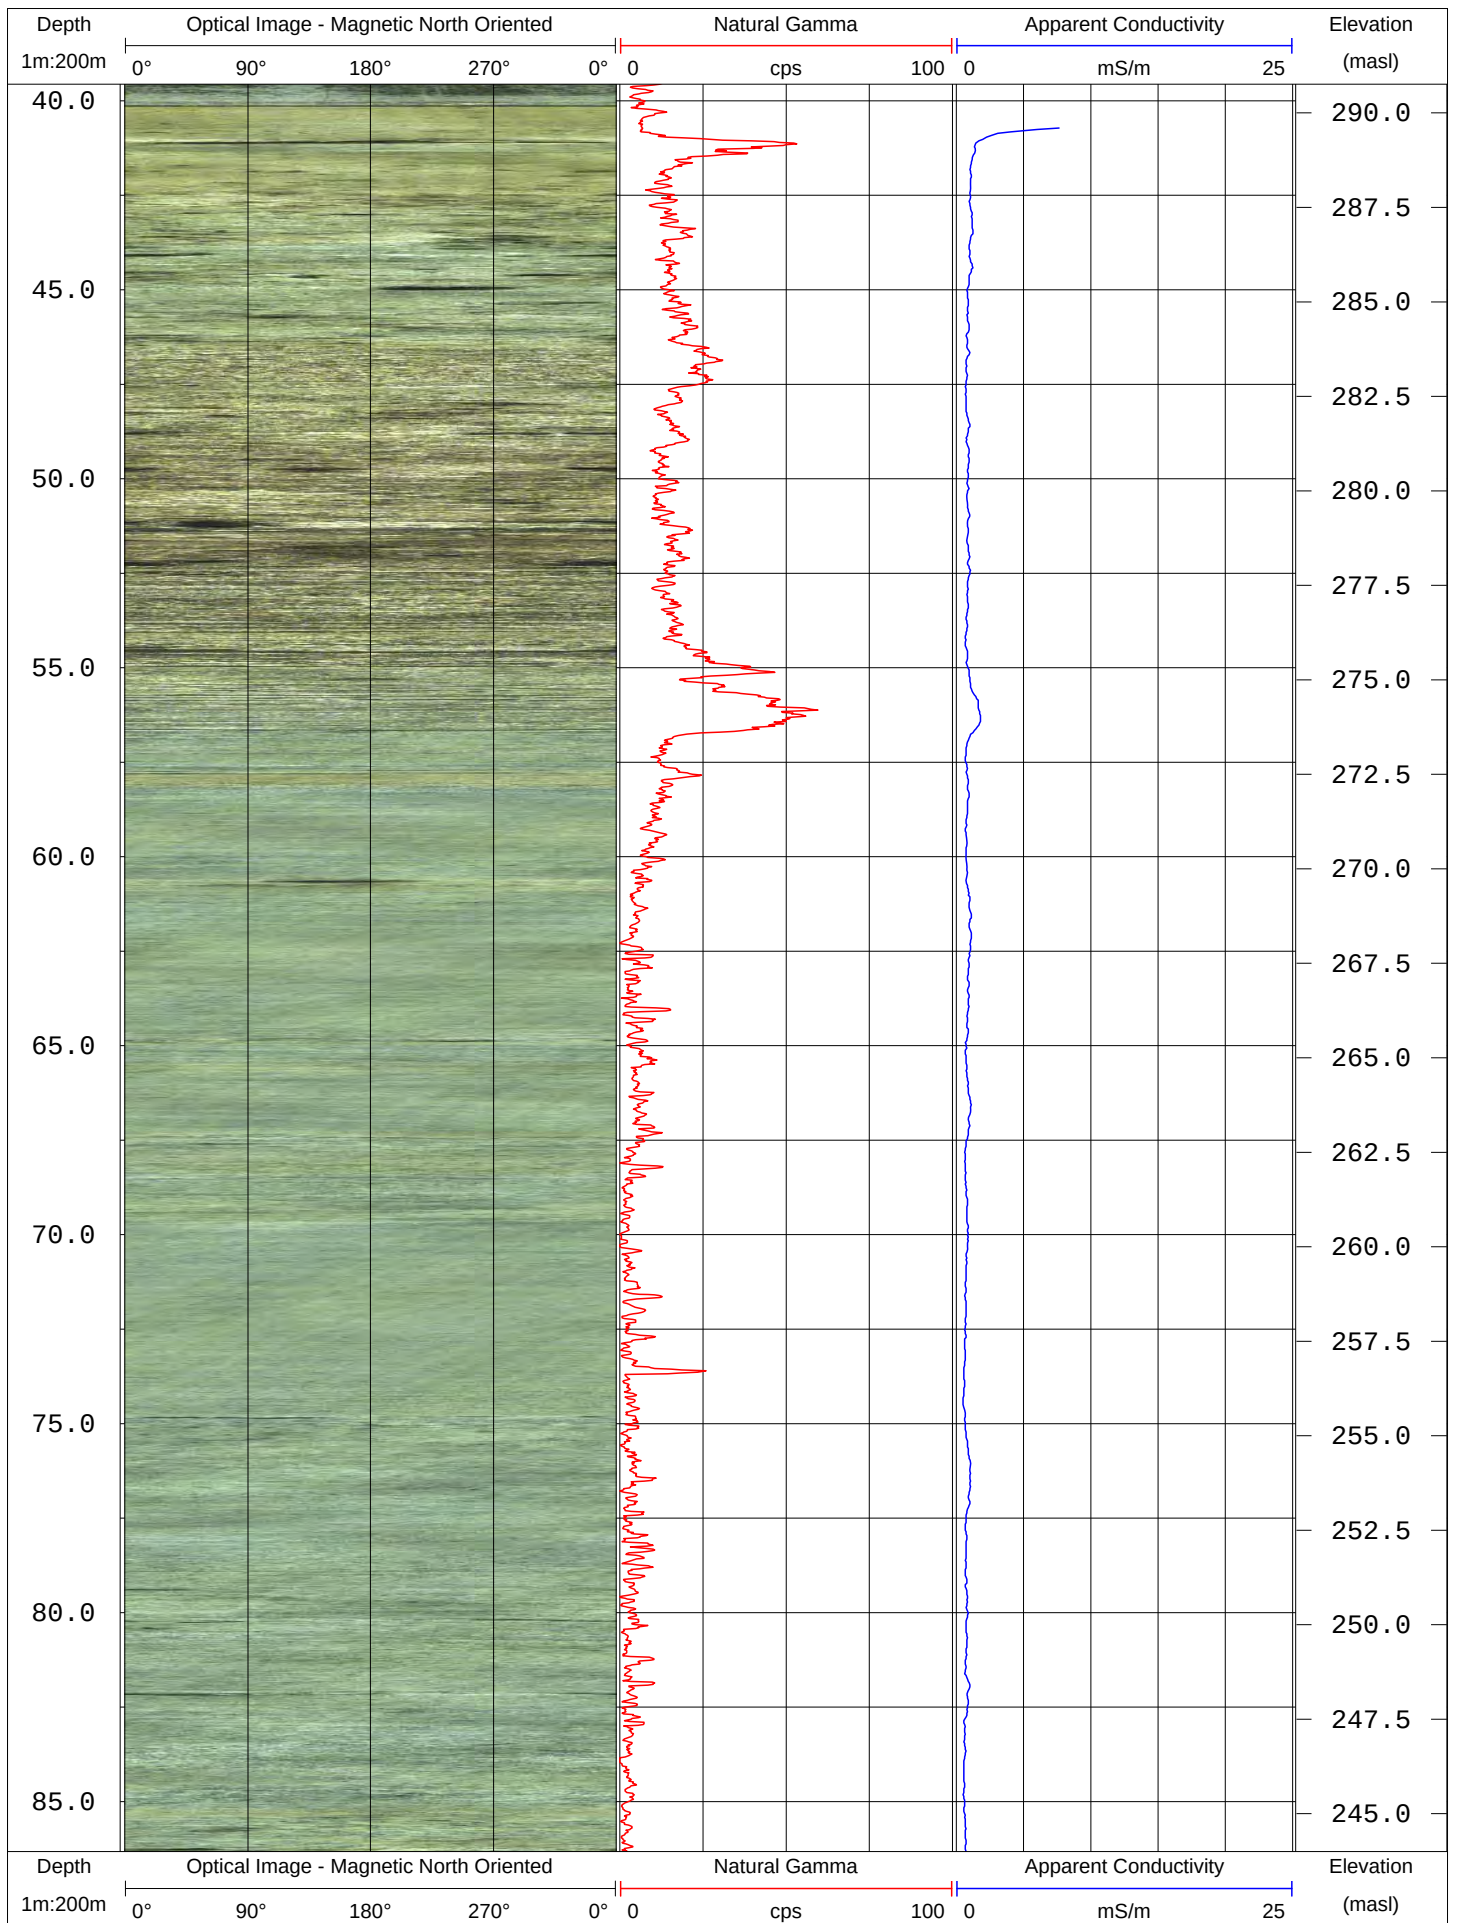

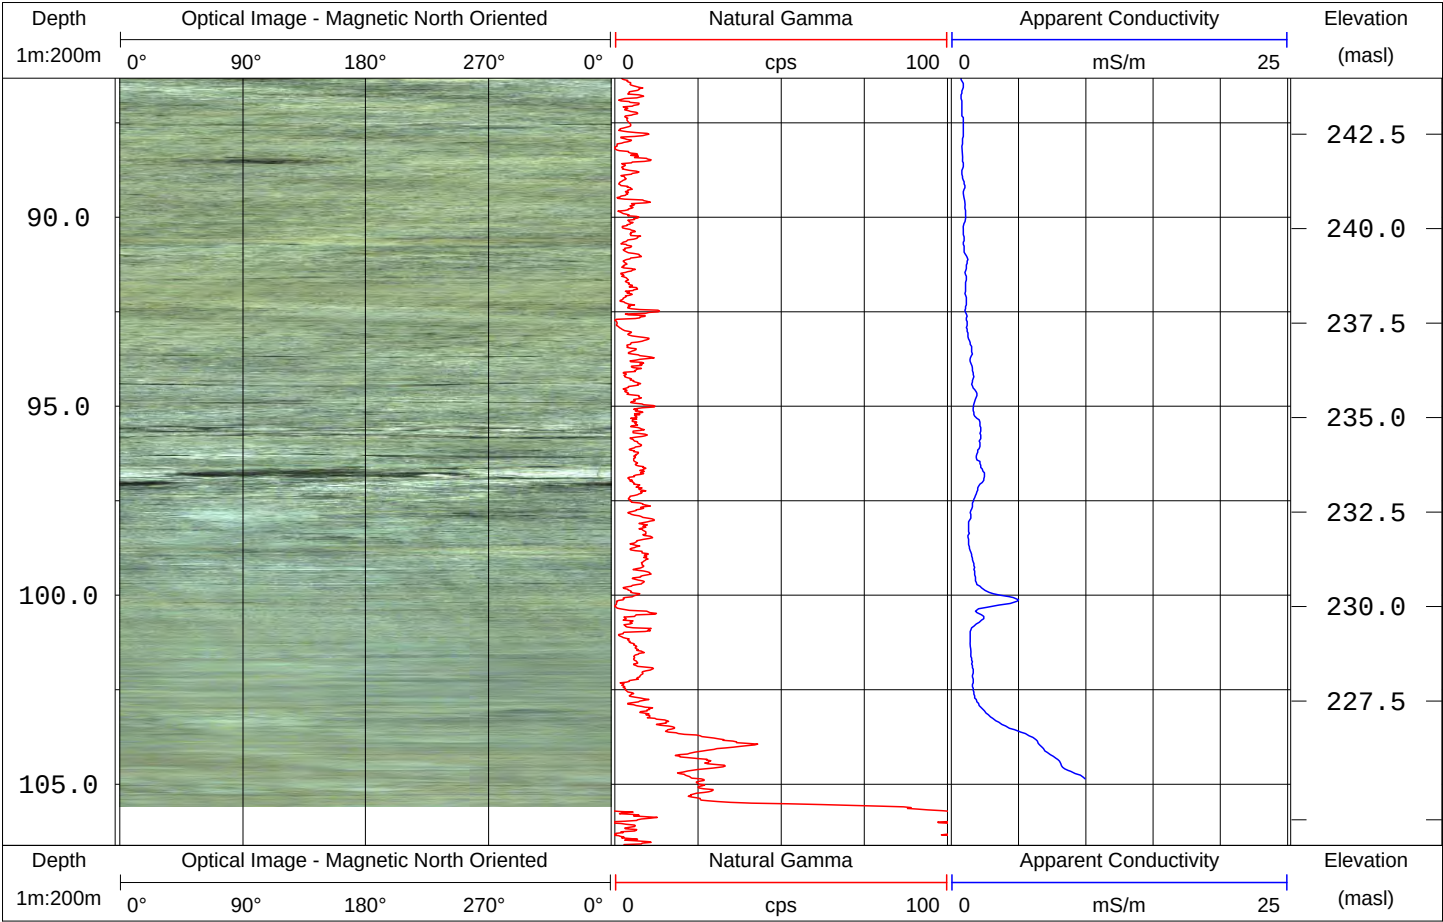



GEOPHYSICAL RECORD OF BOREHOLE MW09-T3-01


PROJECT NO. 08-1112-0021
 LOCATION Little Tract Trail
 LOG DATE May 15, 2009
 LOGGED BY BB



LOG REFERENCE Ground Surface
 ELEVATION (masl) 315.84
 WATER LEVEL (mbgs) 11.16
 BORING METHOD HQ Coring
 REVIEWED BY JAP

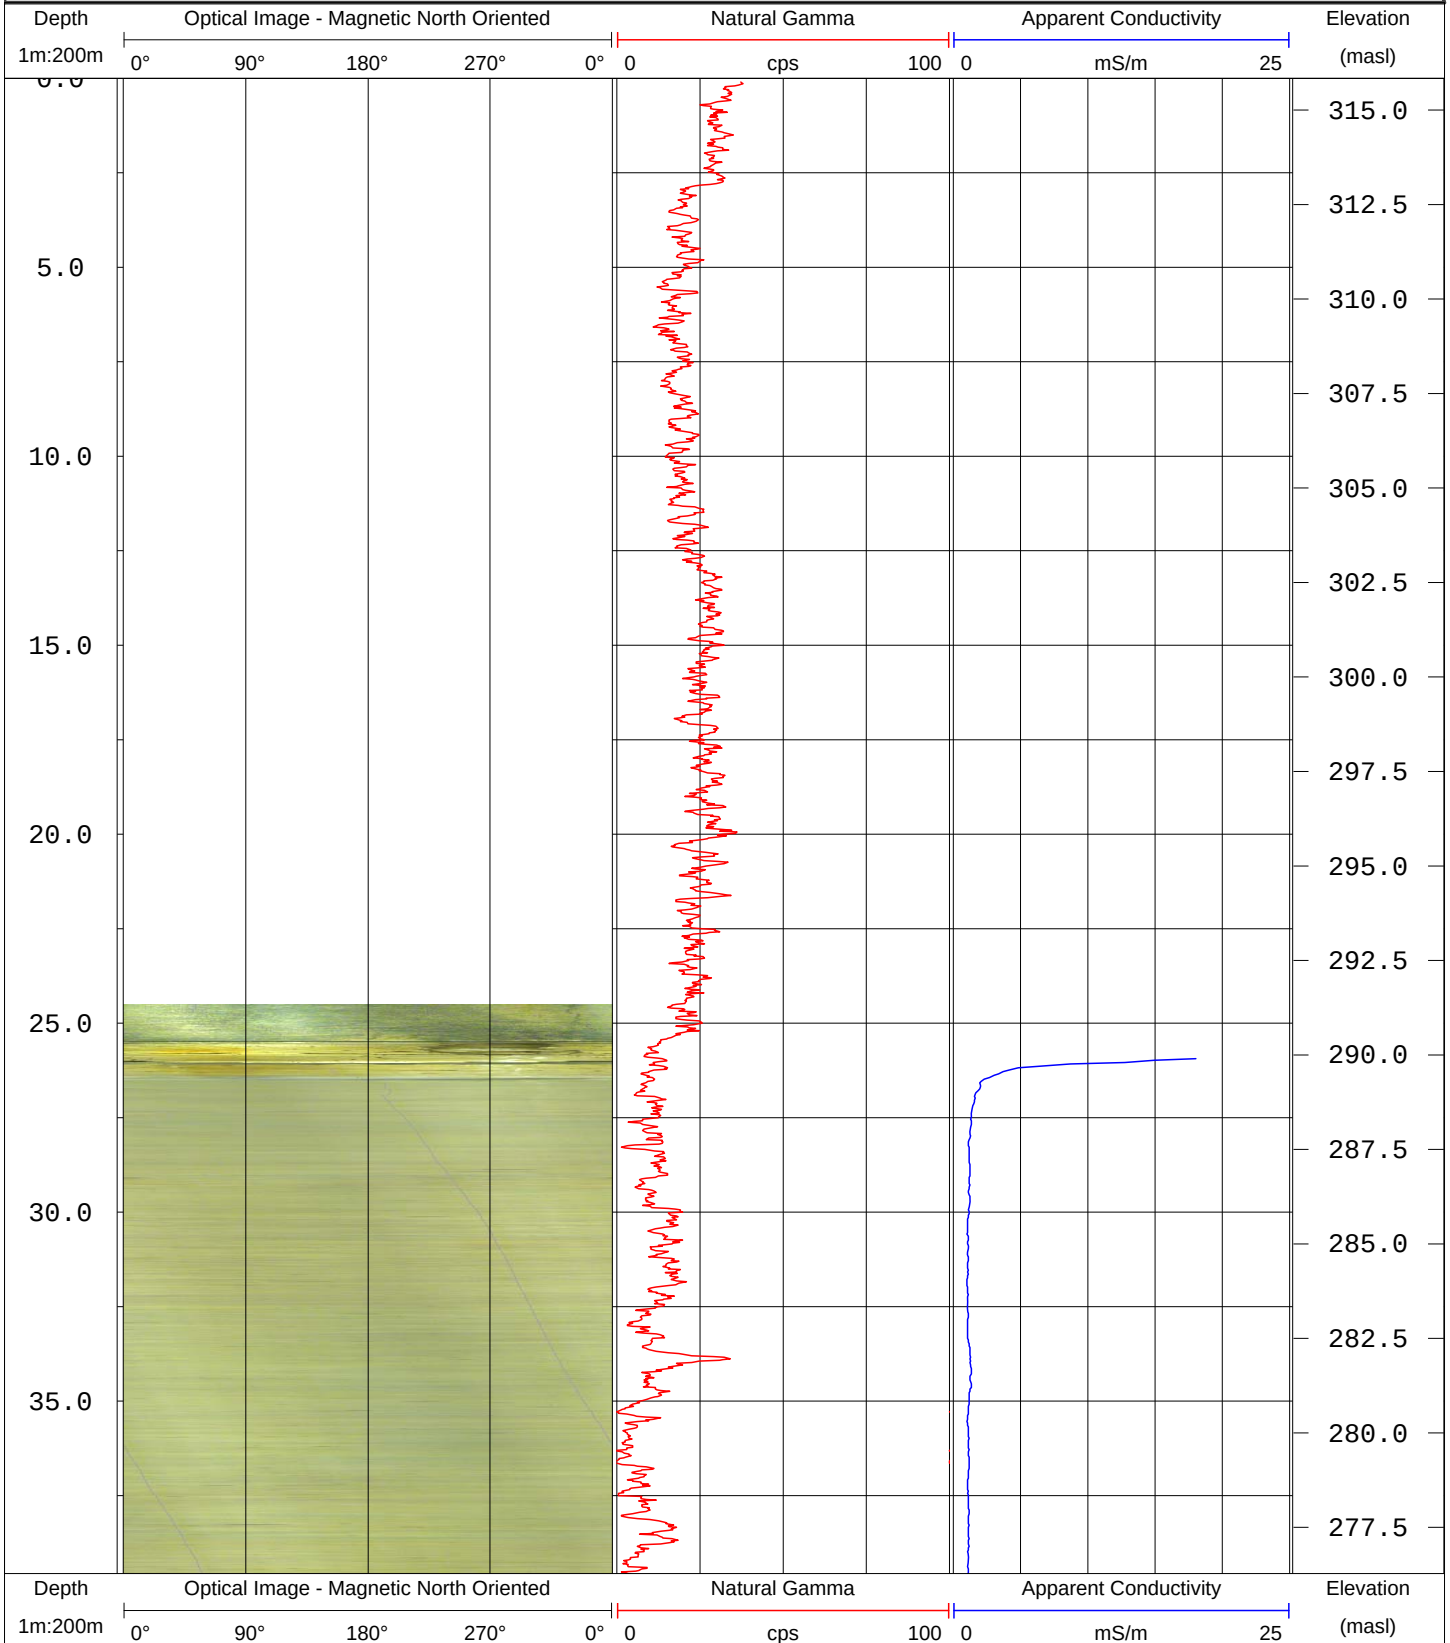

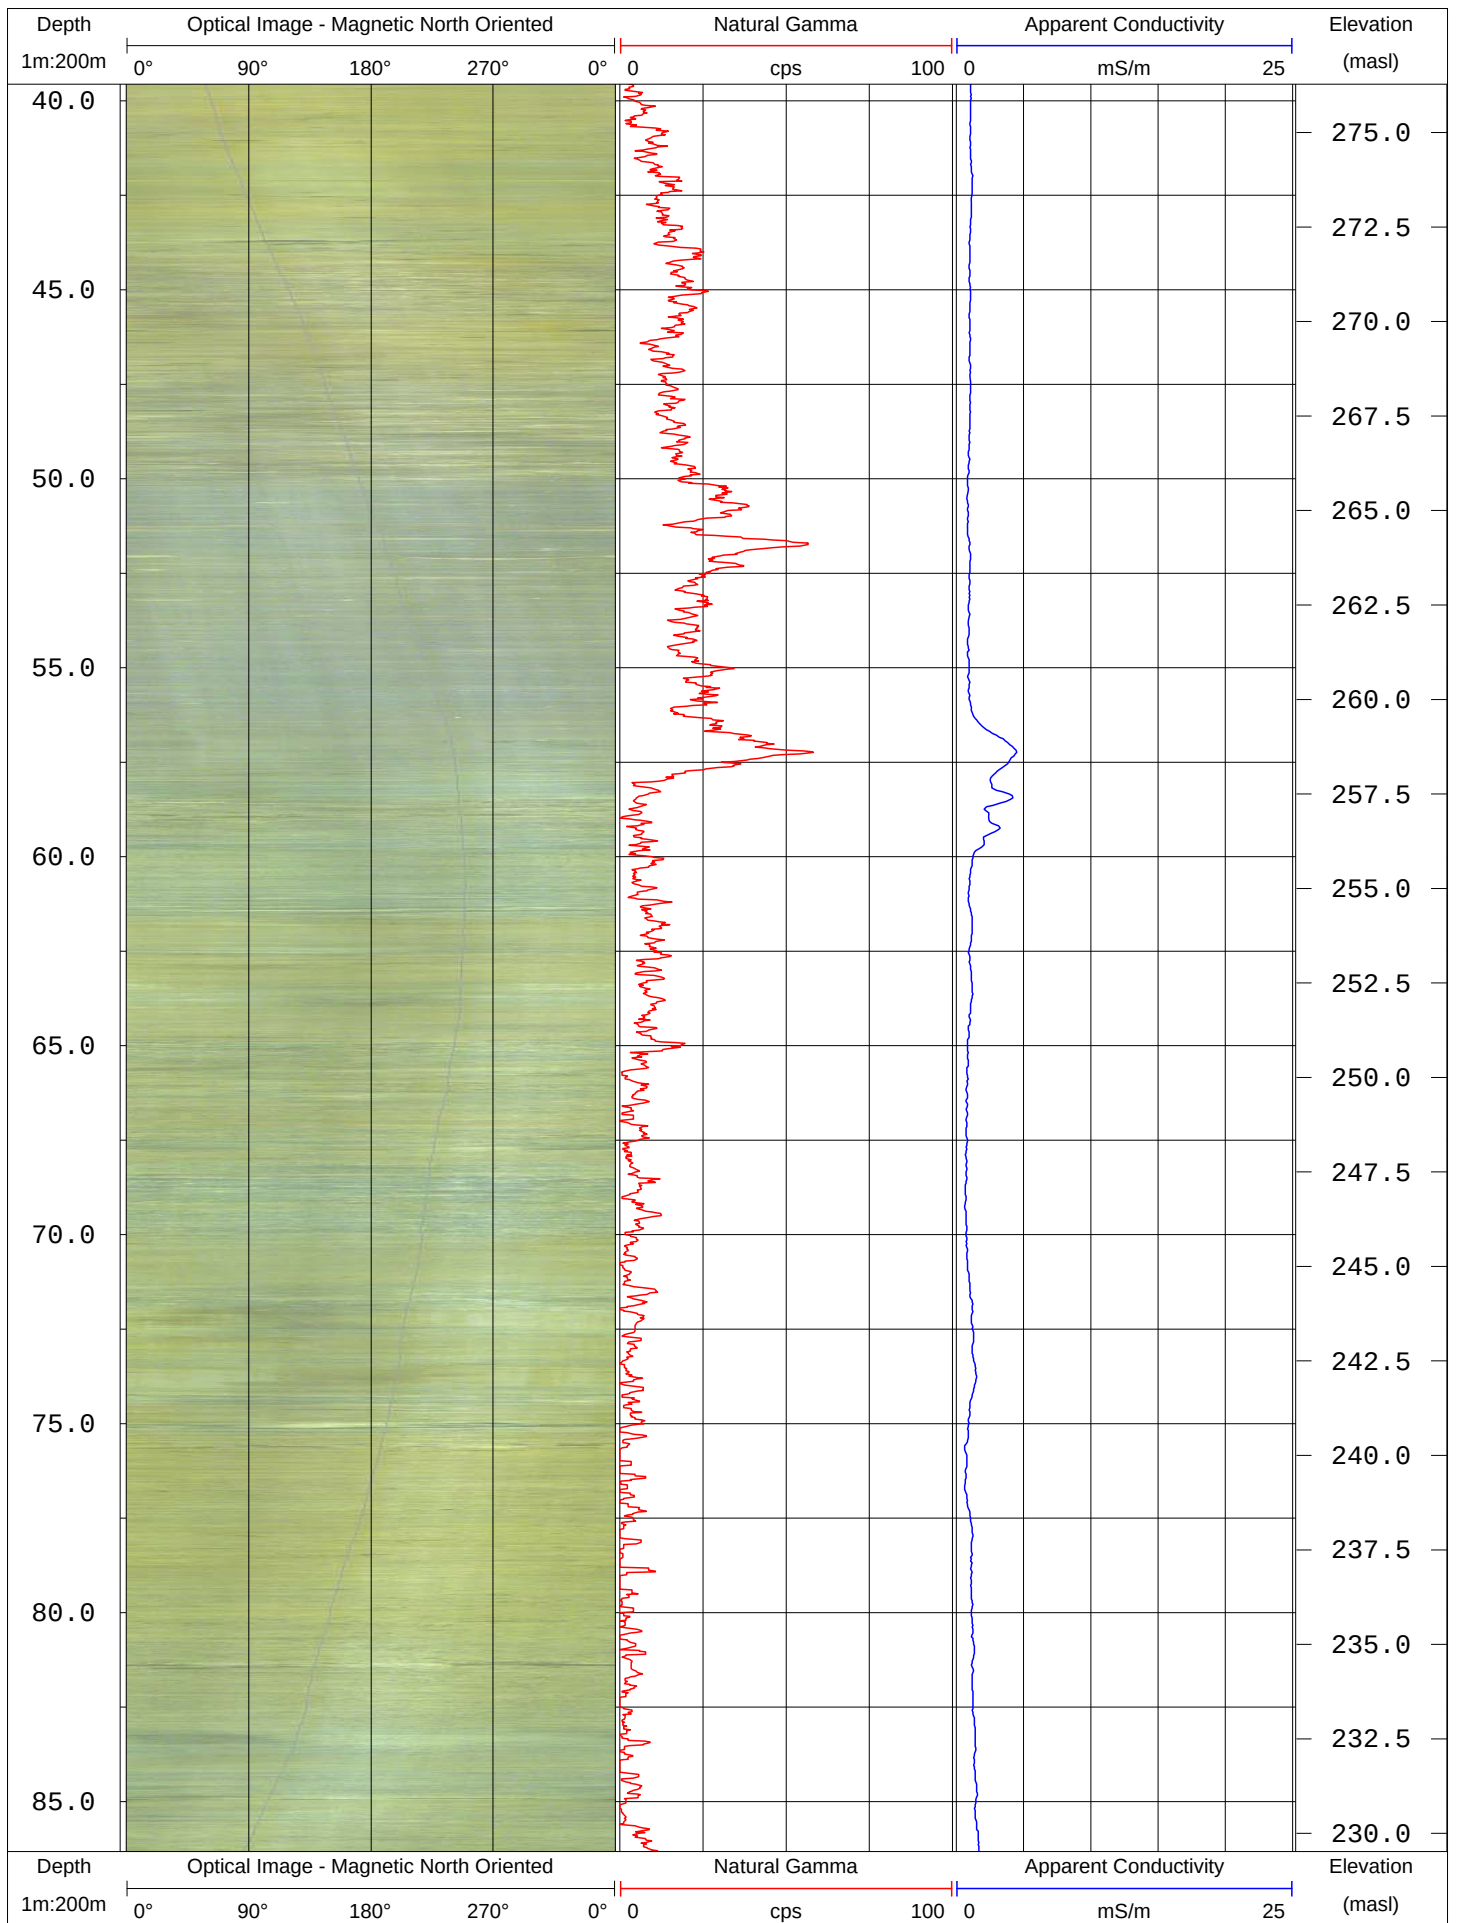

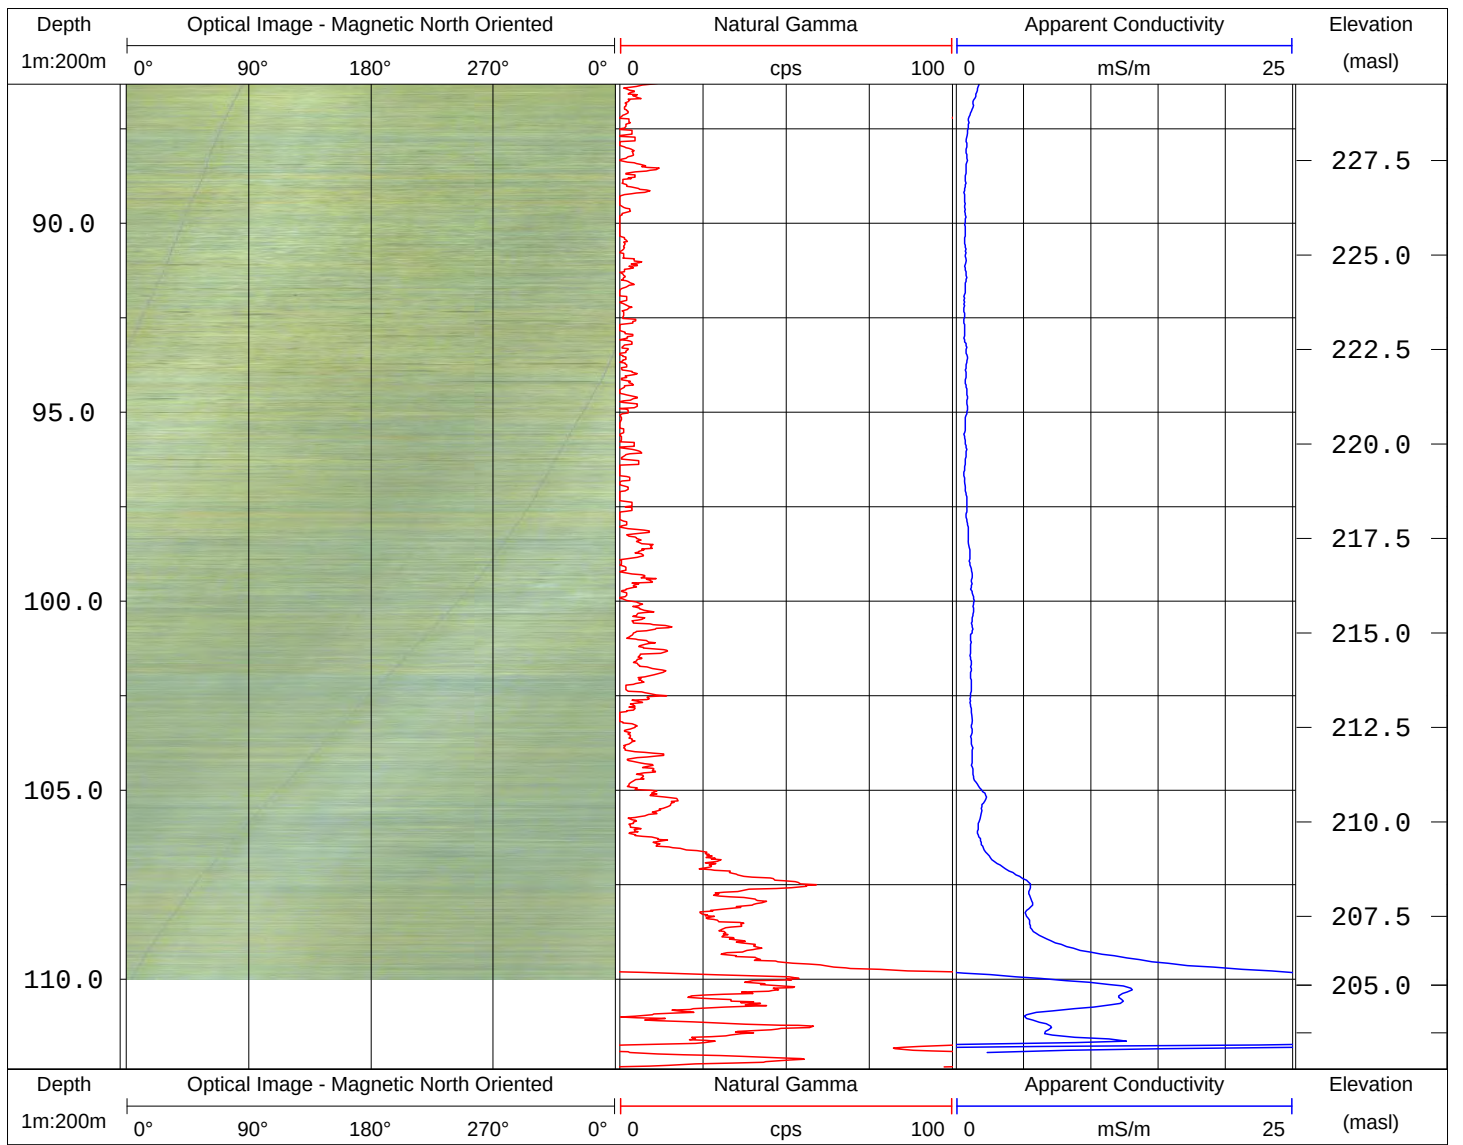

UNIVERSITY OF GUELPH TEMPERATURE PROFILING

Three Tier Three Boreholes (MW08-T3-02, MW08-T3-04 and MW08-T3-05) were subjected to temperature profiling inside of a FLUTE liner. Temperature profiling detects the ambient groundwater flow conditions whereas most hydraulic tests such as packer testing and FLUTE profiling evaluate the system under stressed conditions.

MW08-T3-02

Temperature profiling found five main groundwater flow zones based on the rates of cooling after heating. Horizontal temperature gradients can also be an indicator of groundwater flow horizon changes. The following depths show ambient flow from the temperature logging: 15-16, 26-28, 33-35, 39, 44-47, 55-57, 59, and 62 mbgs. There is little ambient flow below the depth of 65 mbgs.

MW08-T3-04

The following depths show ambient flow from the temperature logging: 27, 27-32, 42, 48, 49, 50, 51, 109, 110, 111, and 118 mbgs. In the Niagara Falls Member of the Goat Island Formation (from 60-80 mbgs) there is very little flow activity.

MW08-T3-05

MW08-T3-05 appears to have a fewer number of flow features present. The following depths show ambient flow from the temperature logging: 28, 30, 41, 43 mbgs. From 41 to 64 mbgs there are a number of scattered peaks of flow activity which is followed by a low flow zone from 63 to 71 mbgs. At 97 mbgs there appears to be change in flow direction.


Source:


The above summary of temperature logging was provided by the University of Guelph.





CITY OF GUELPH TIER THREE ASSESSMENT CHARACTERIZATION FINAL REPORT


C5: Packer Test Data

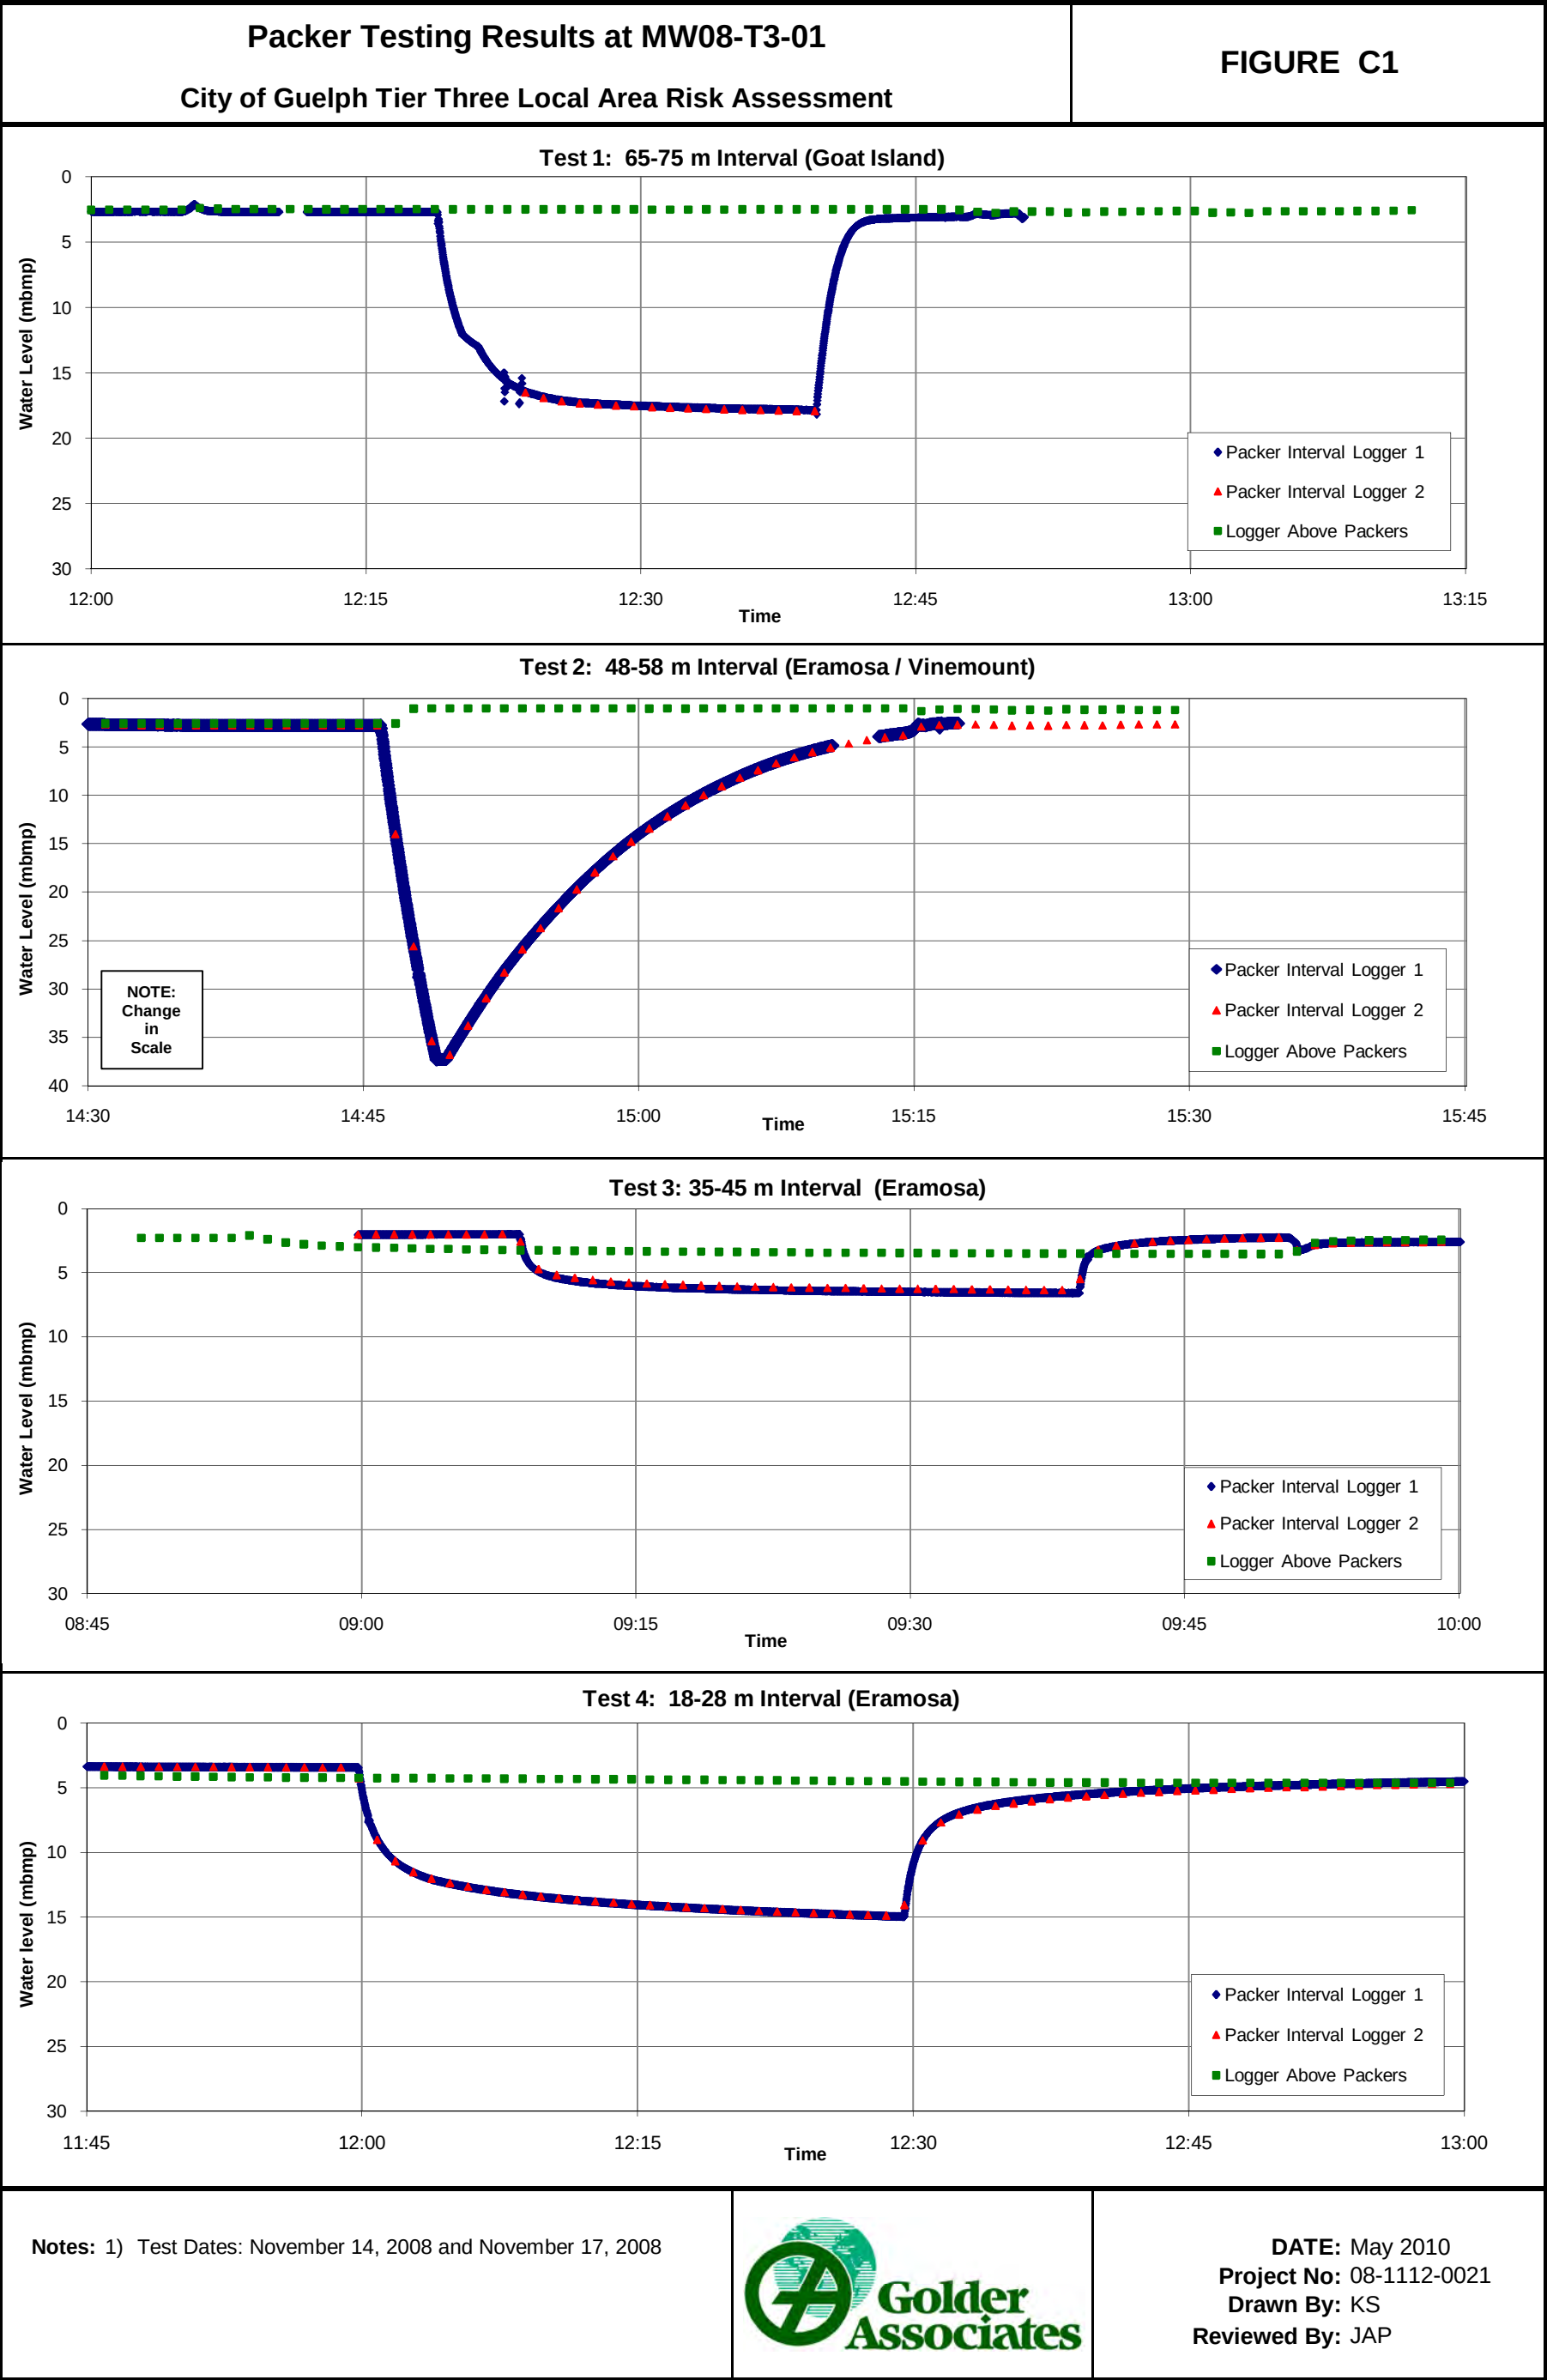


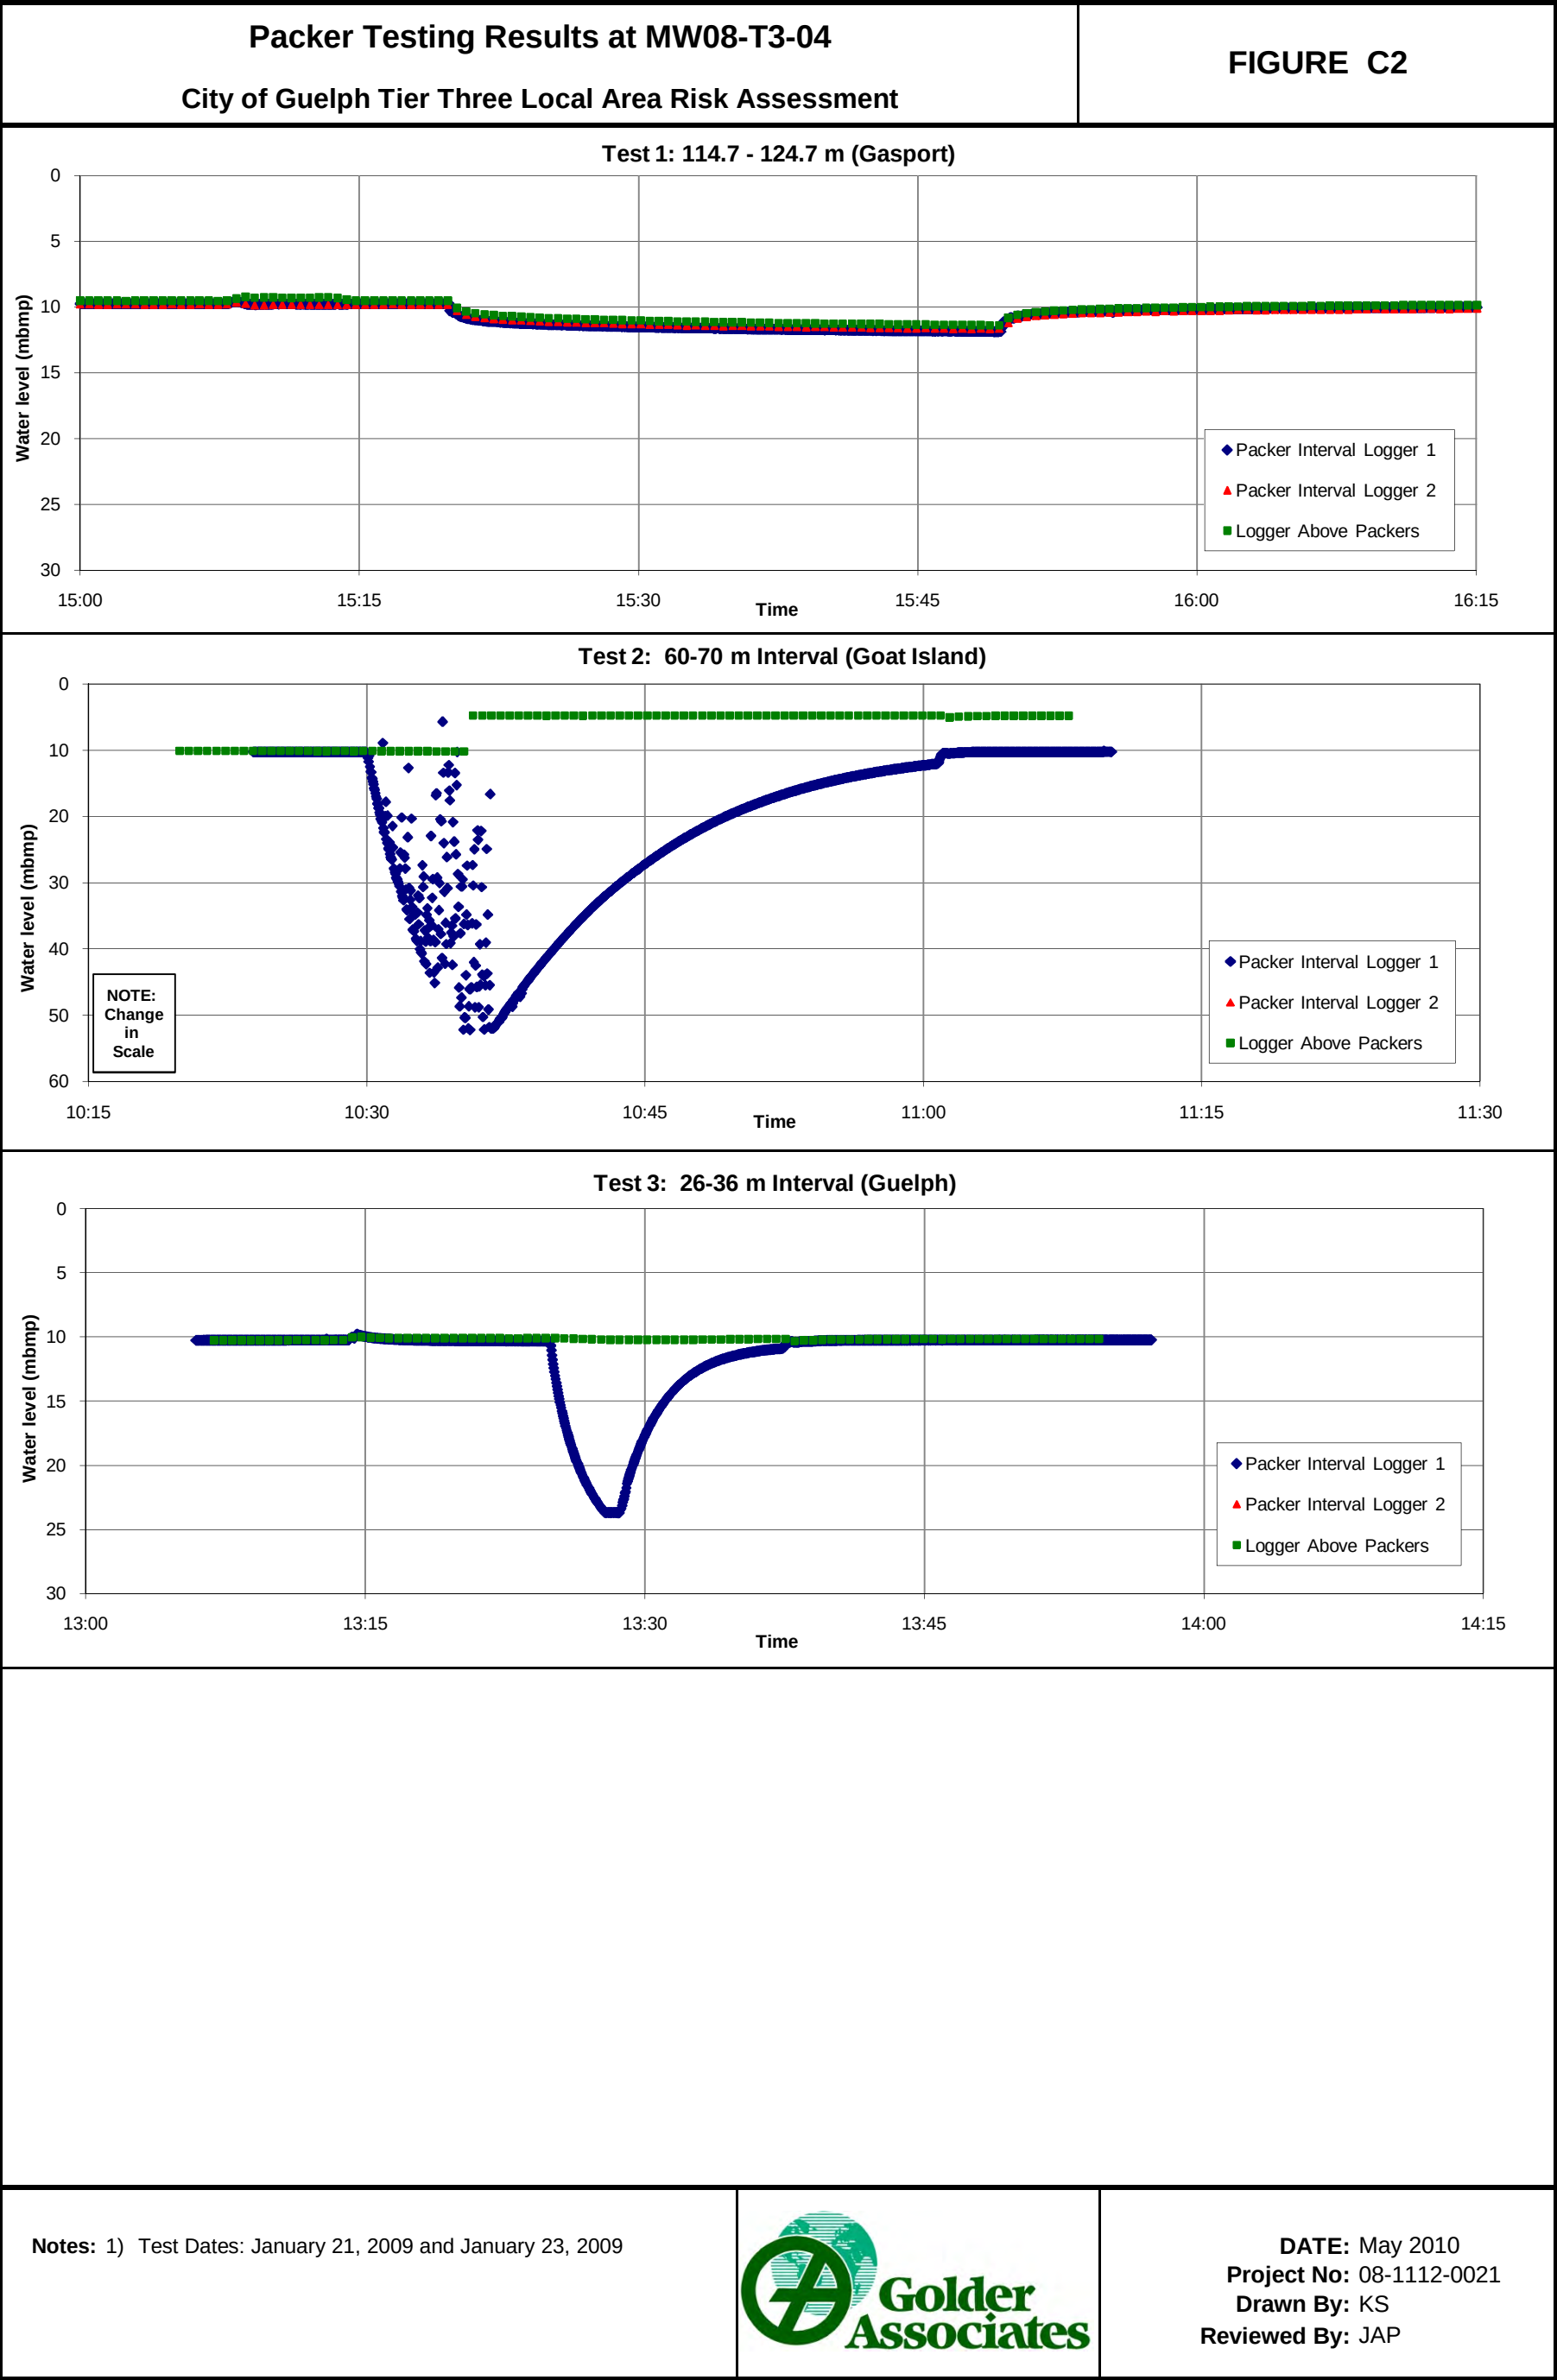


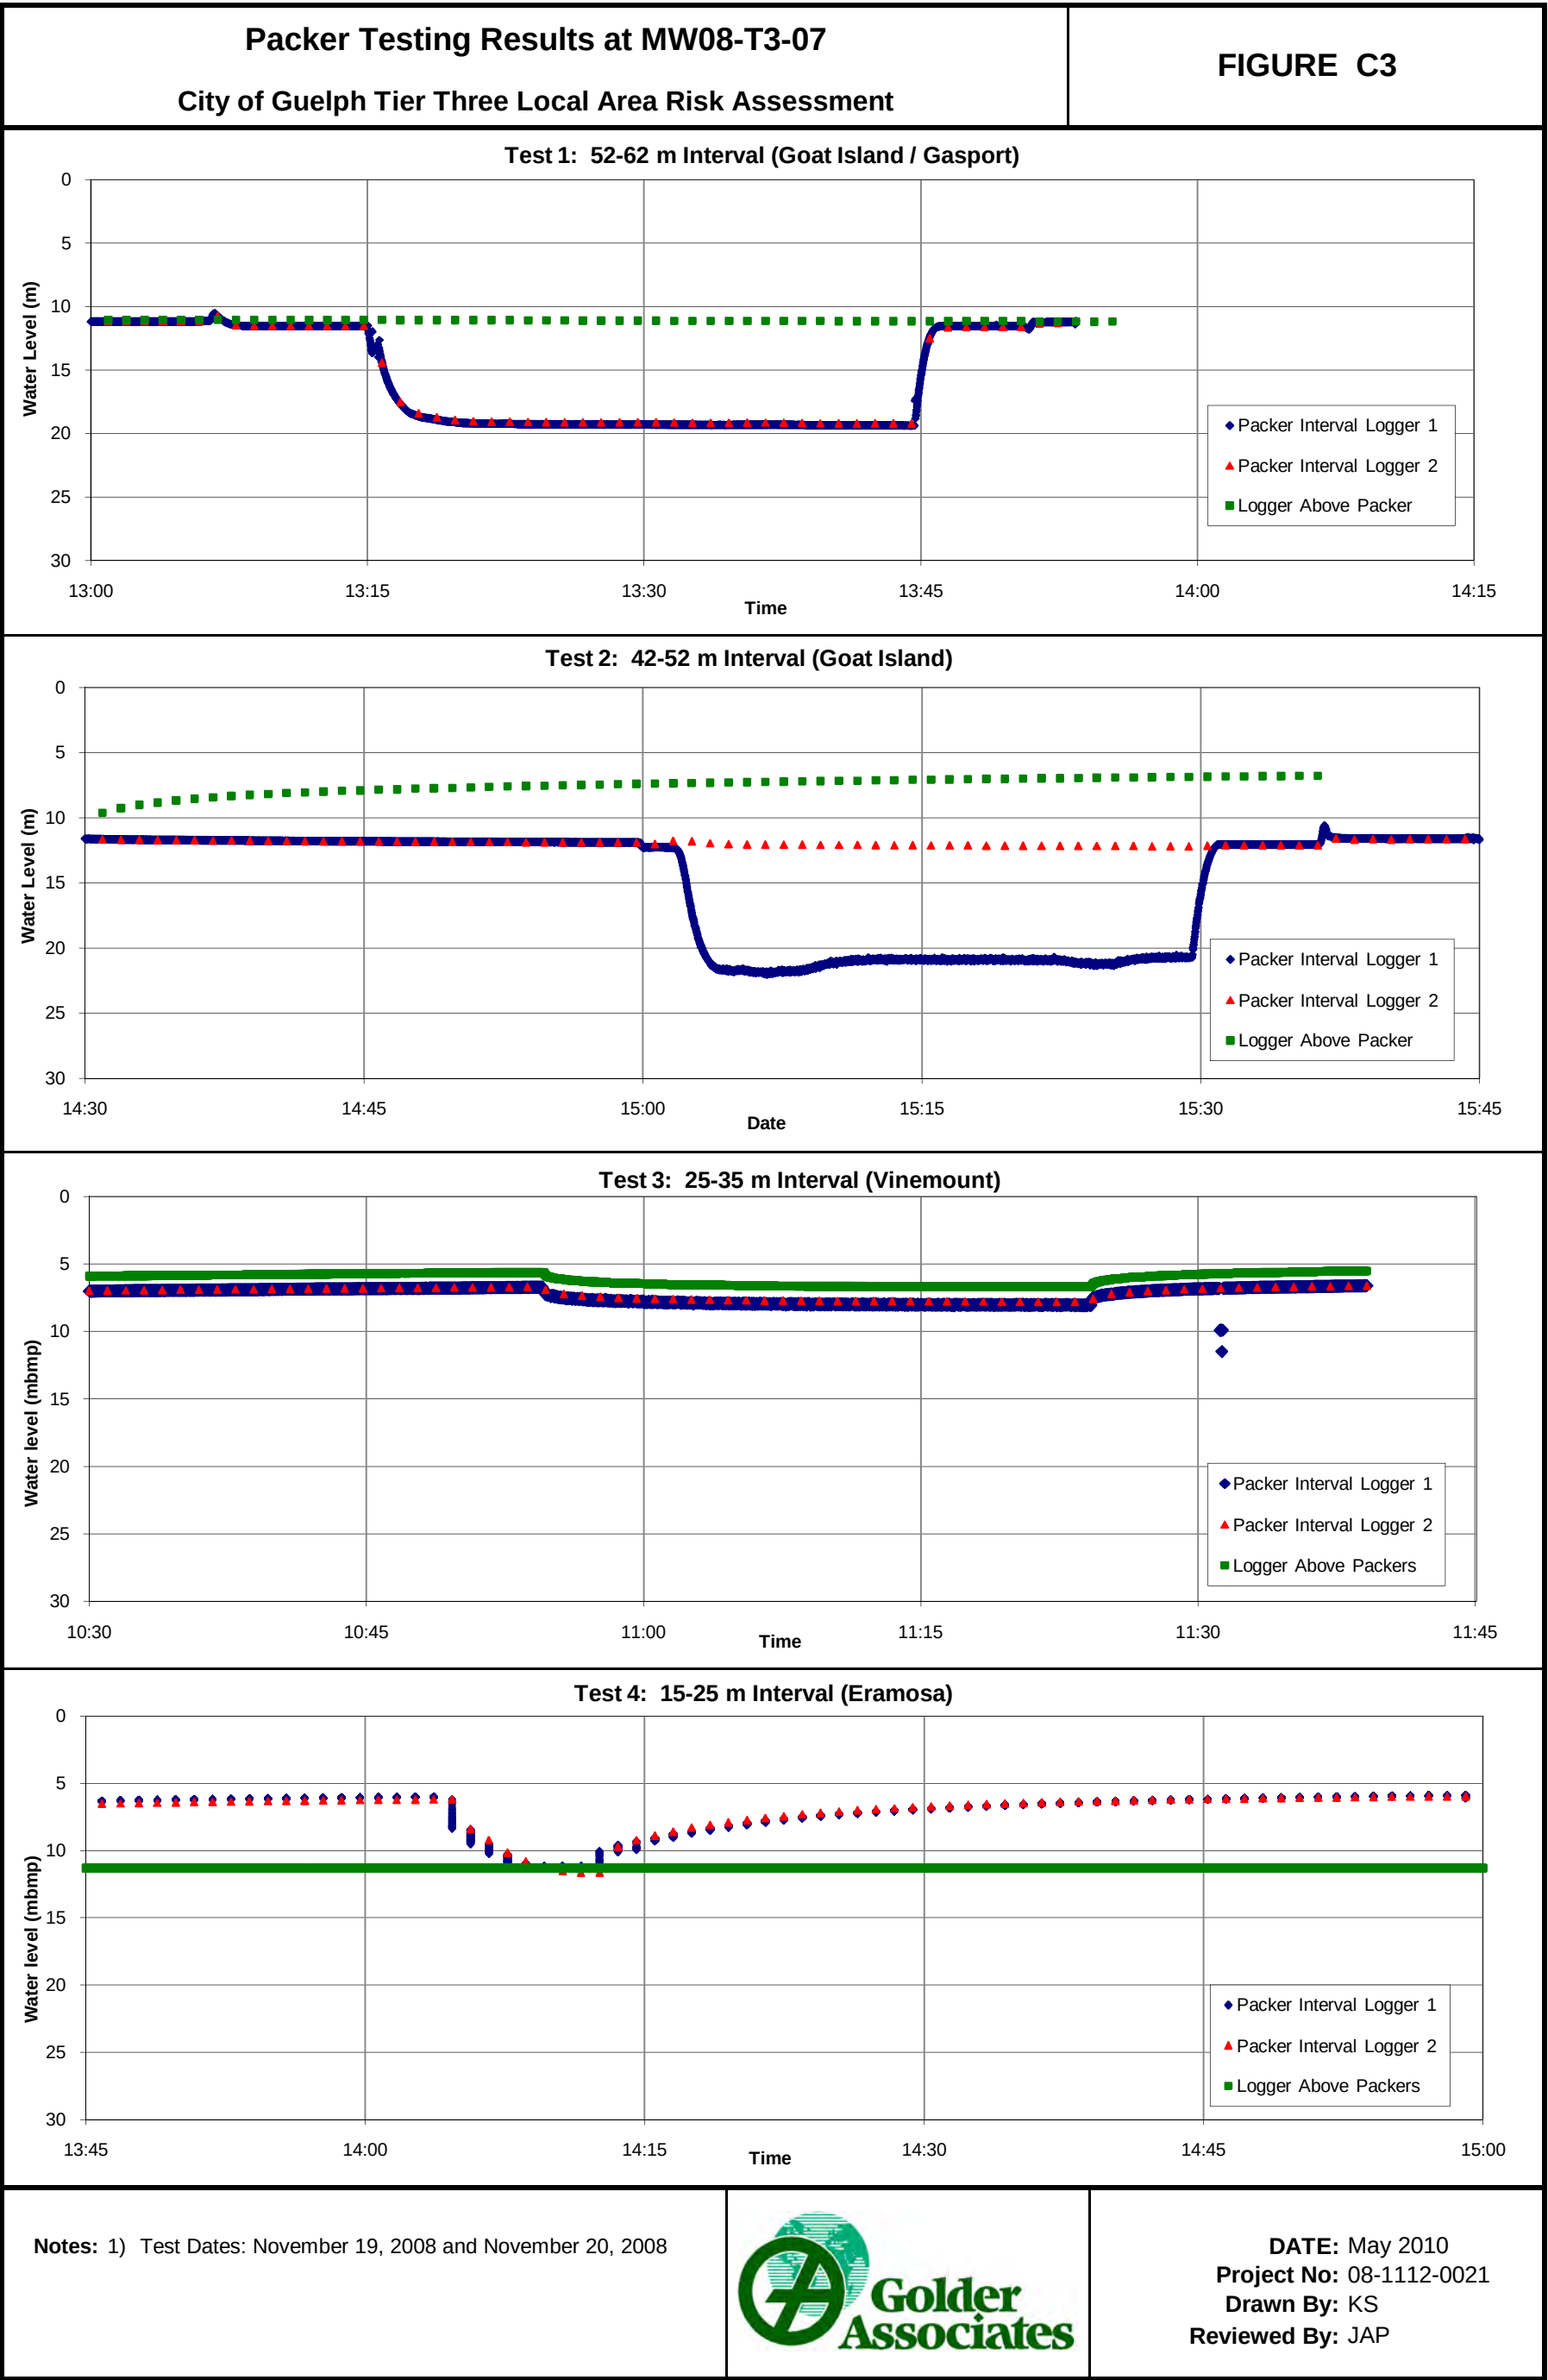


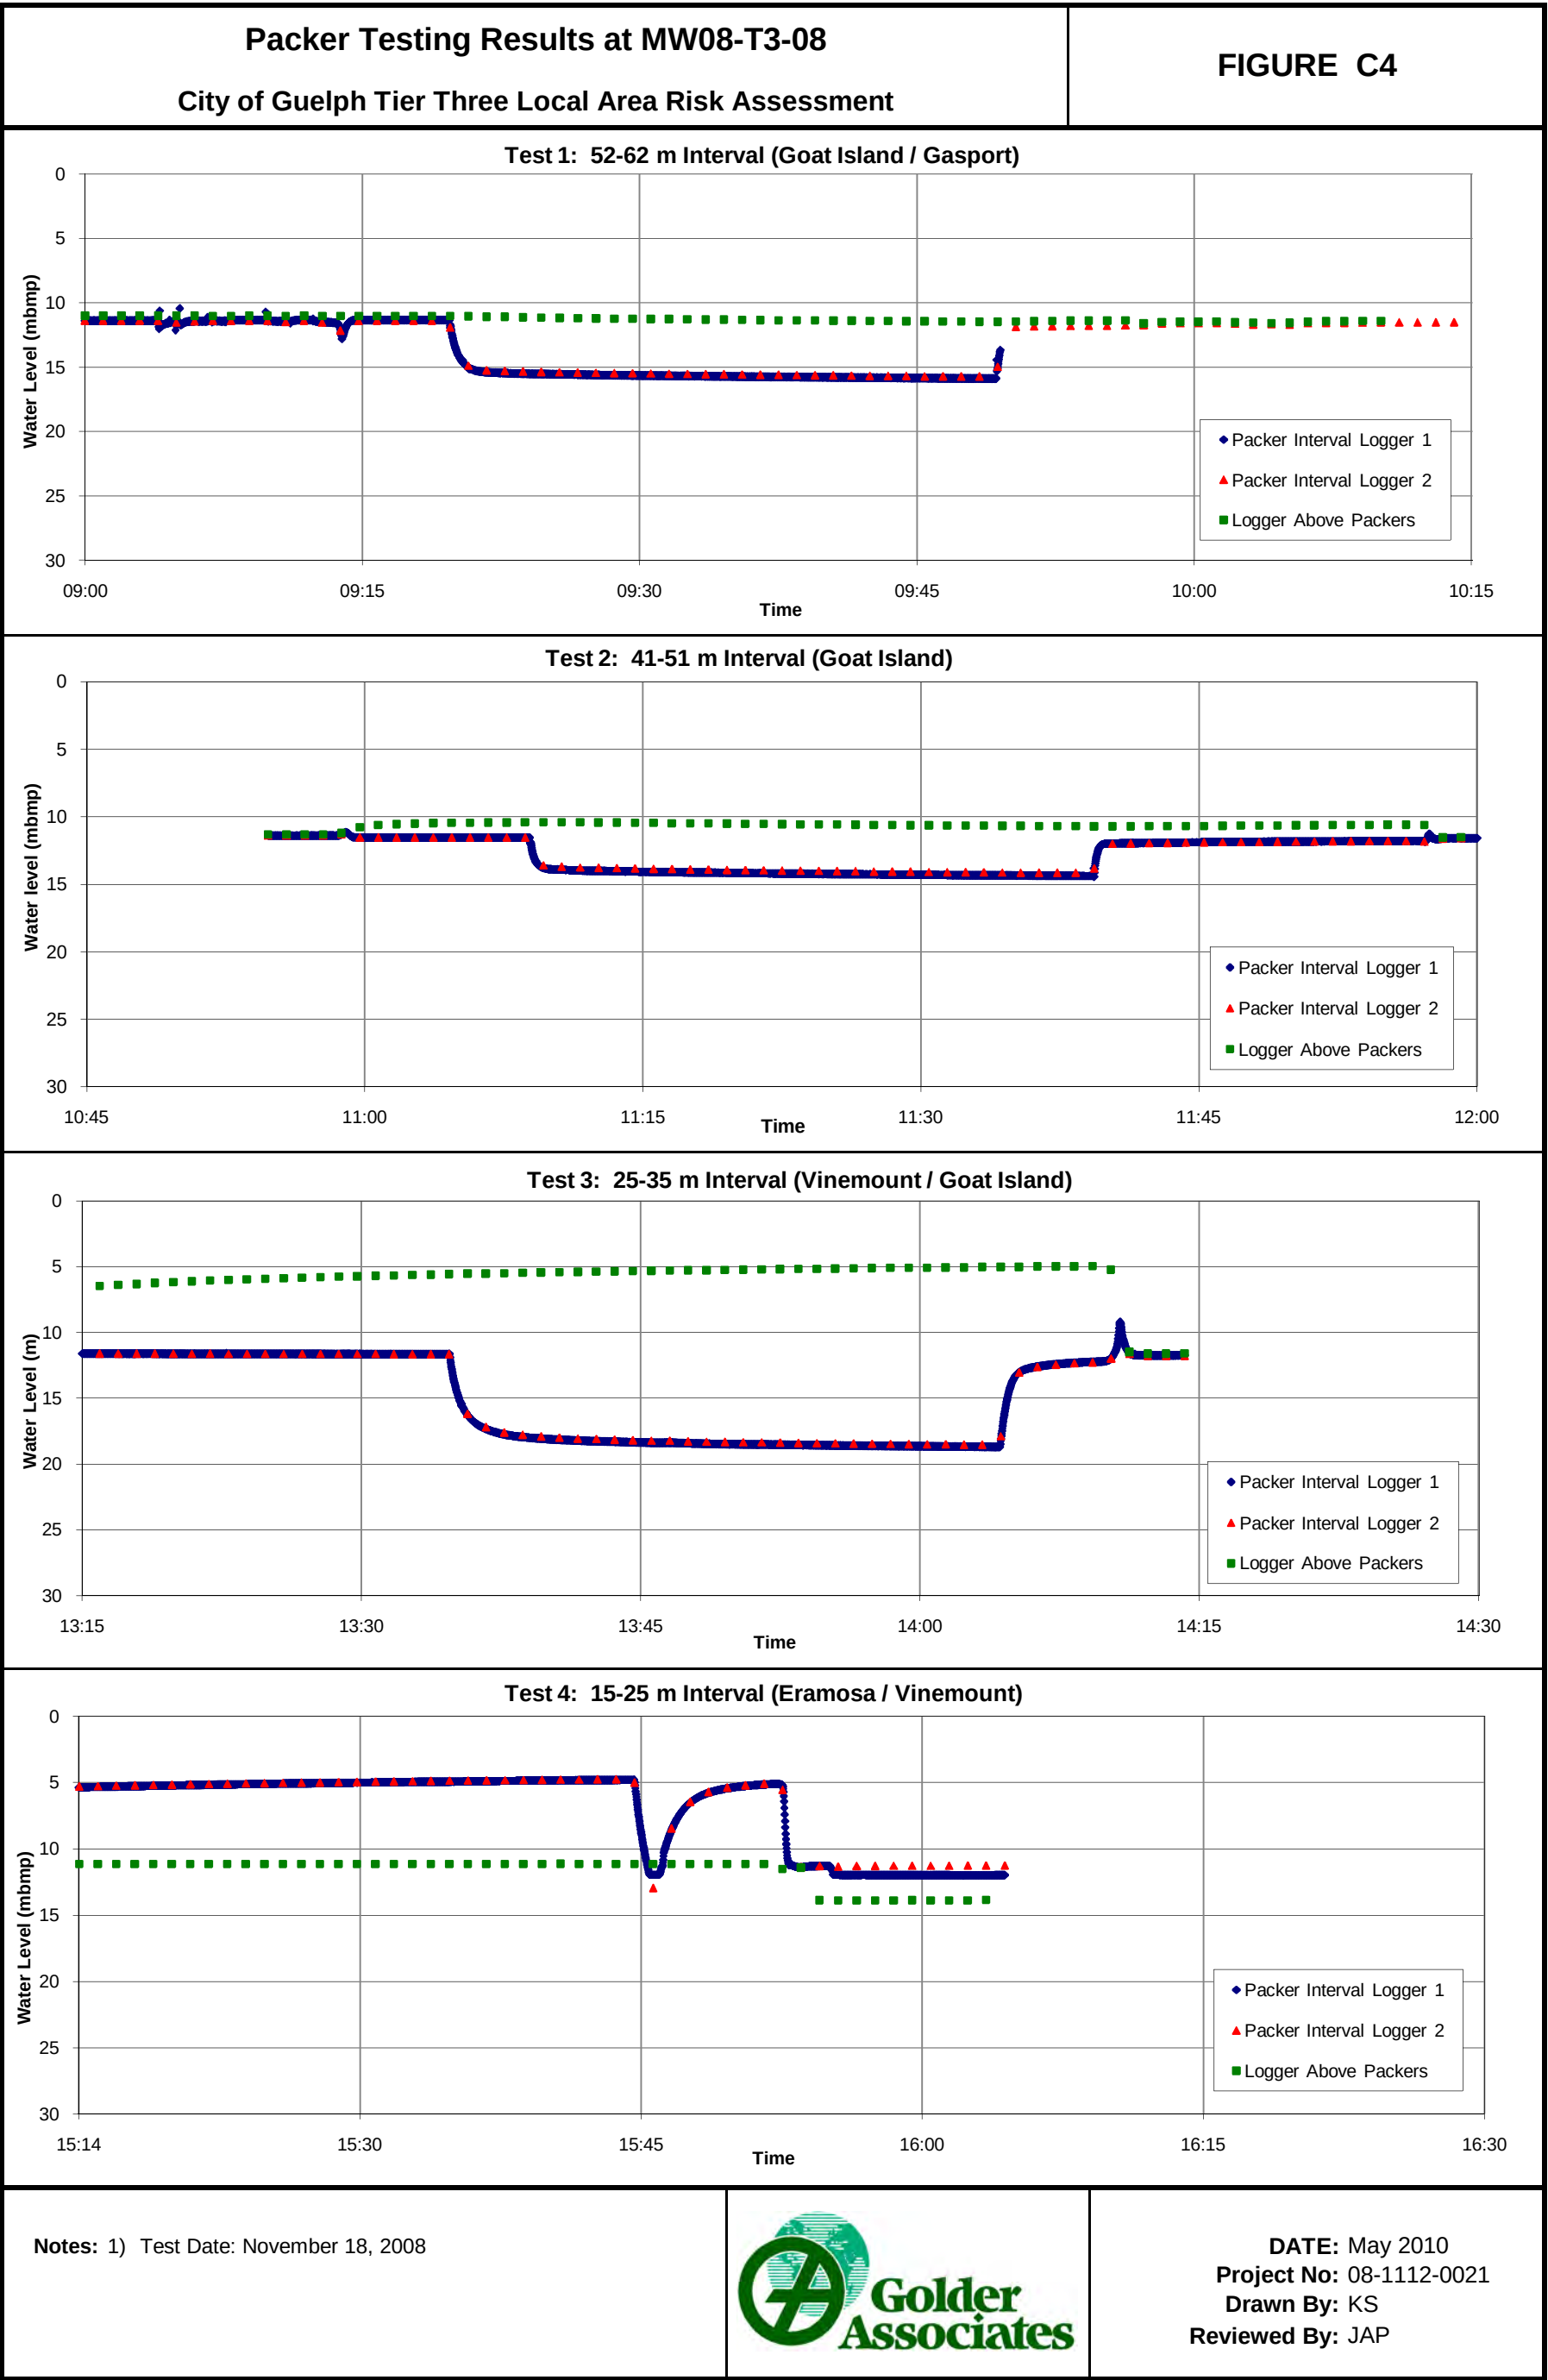

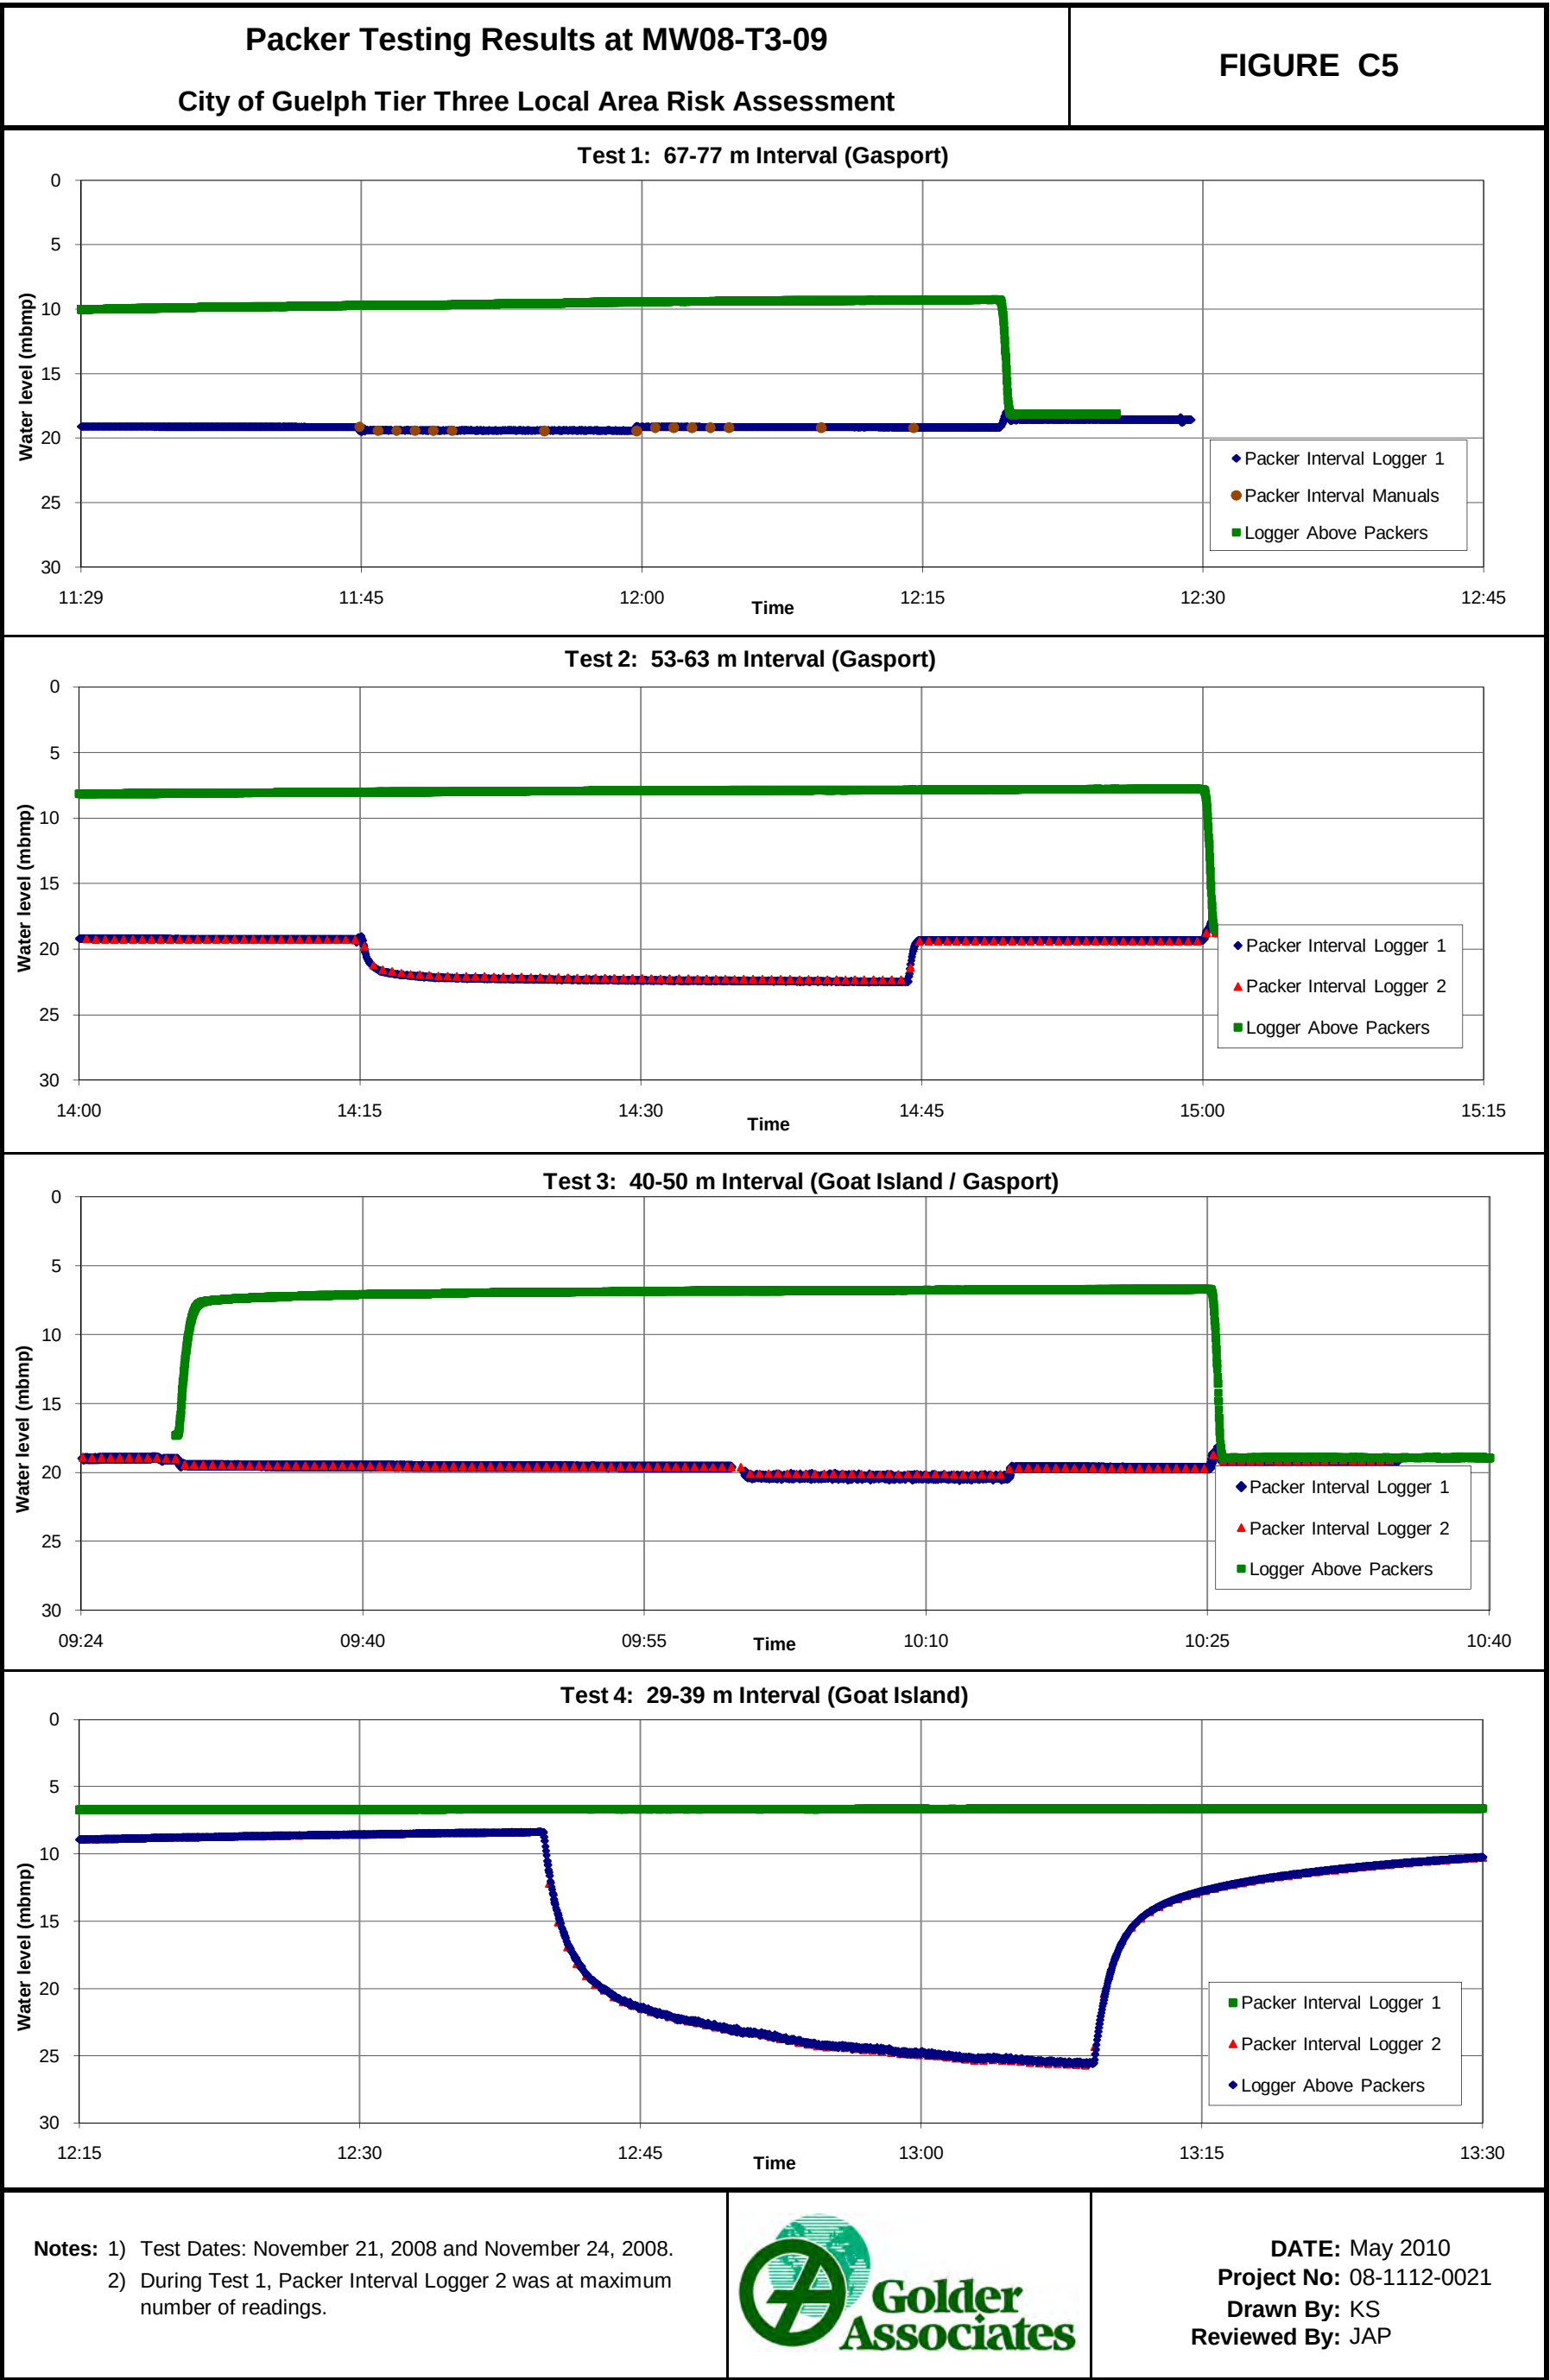

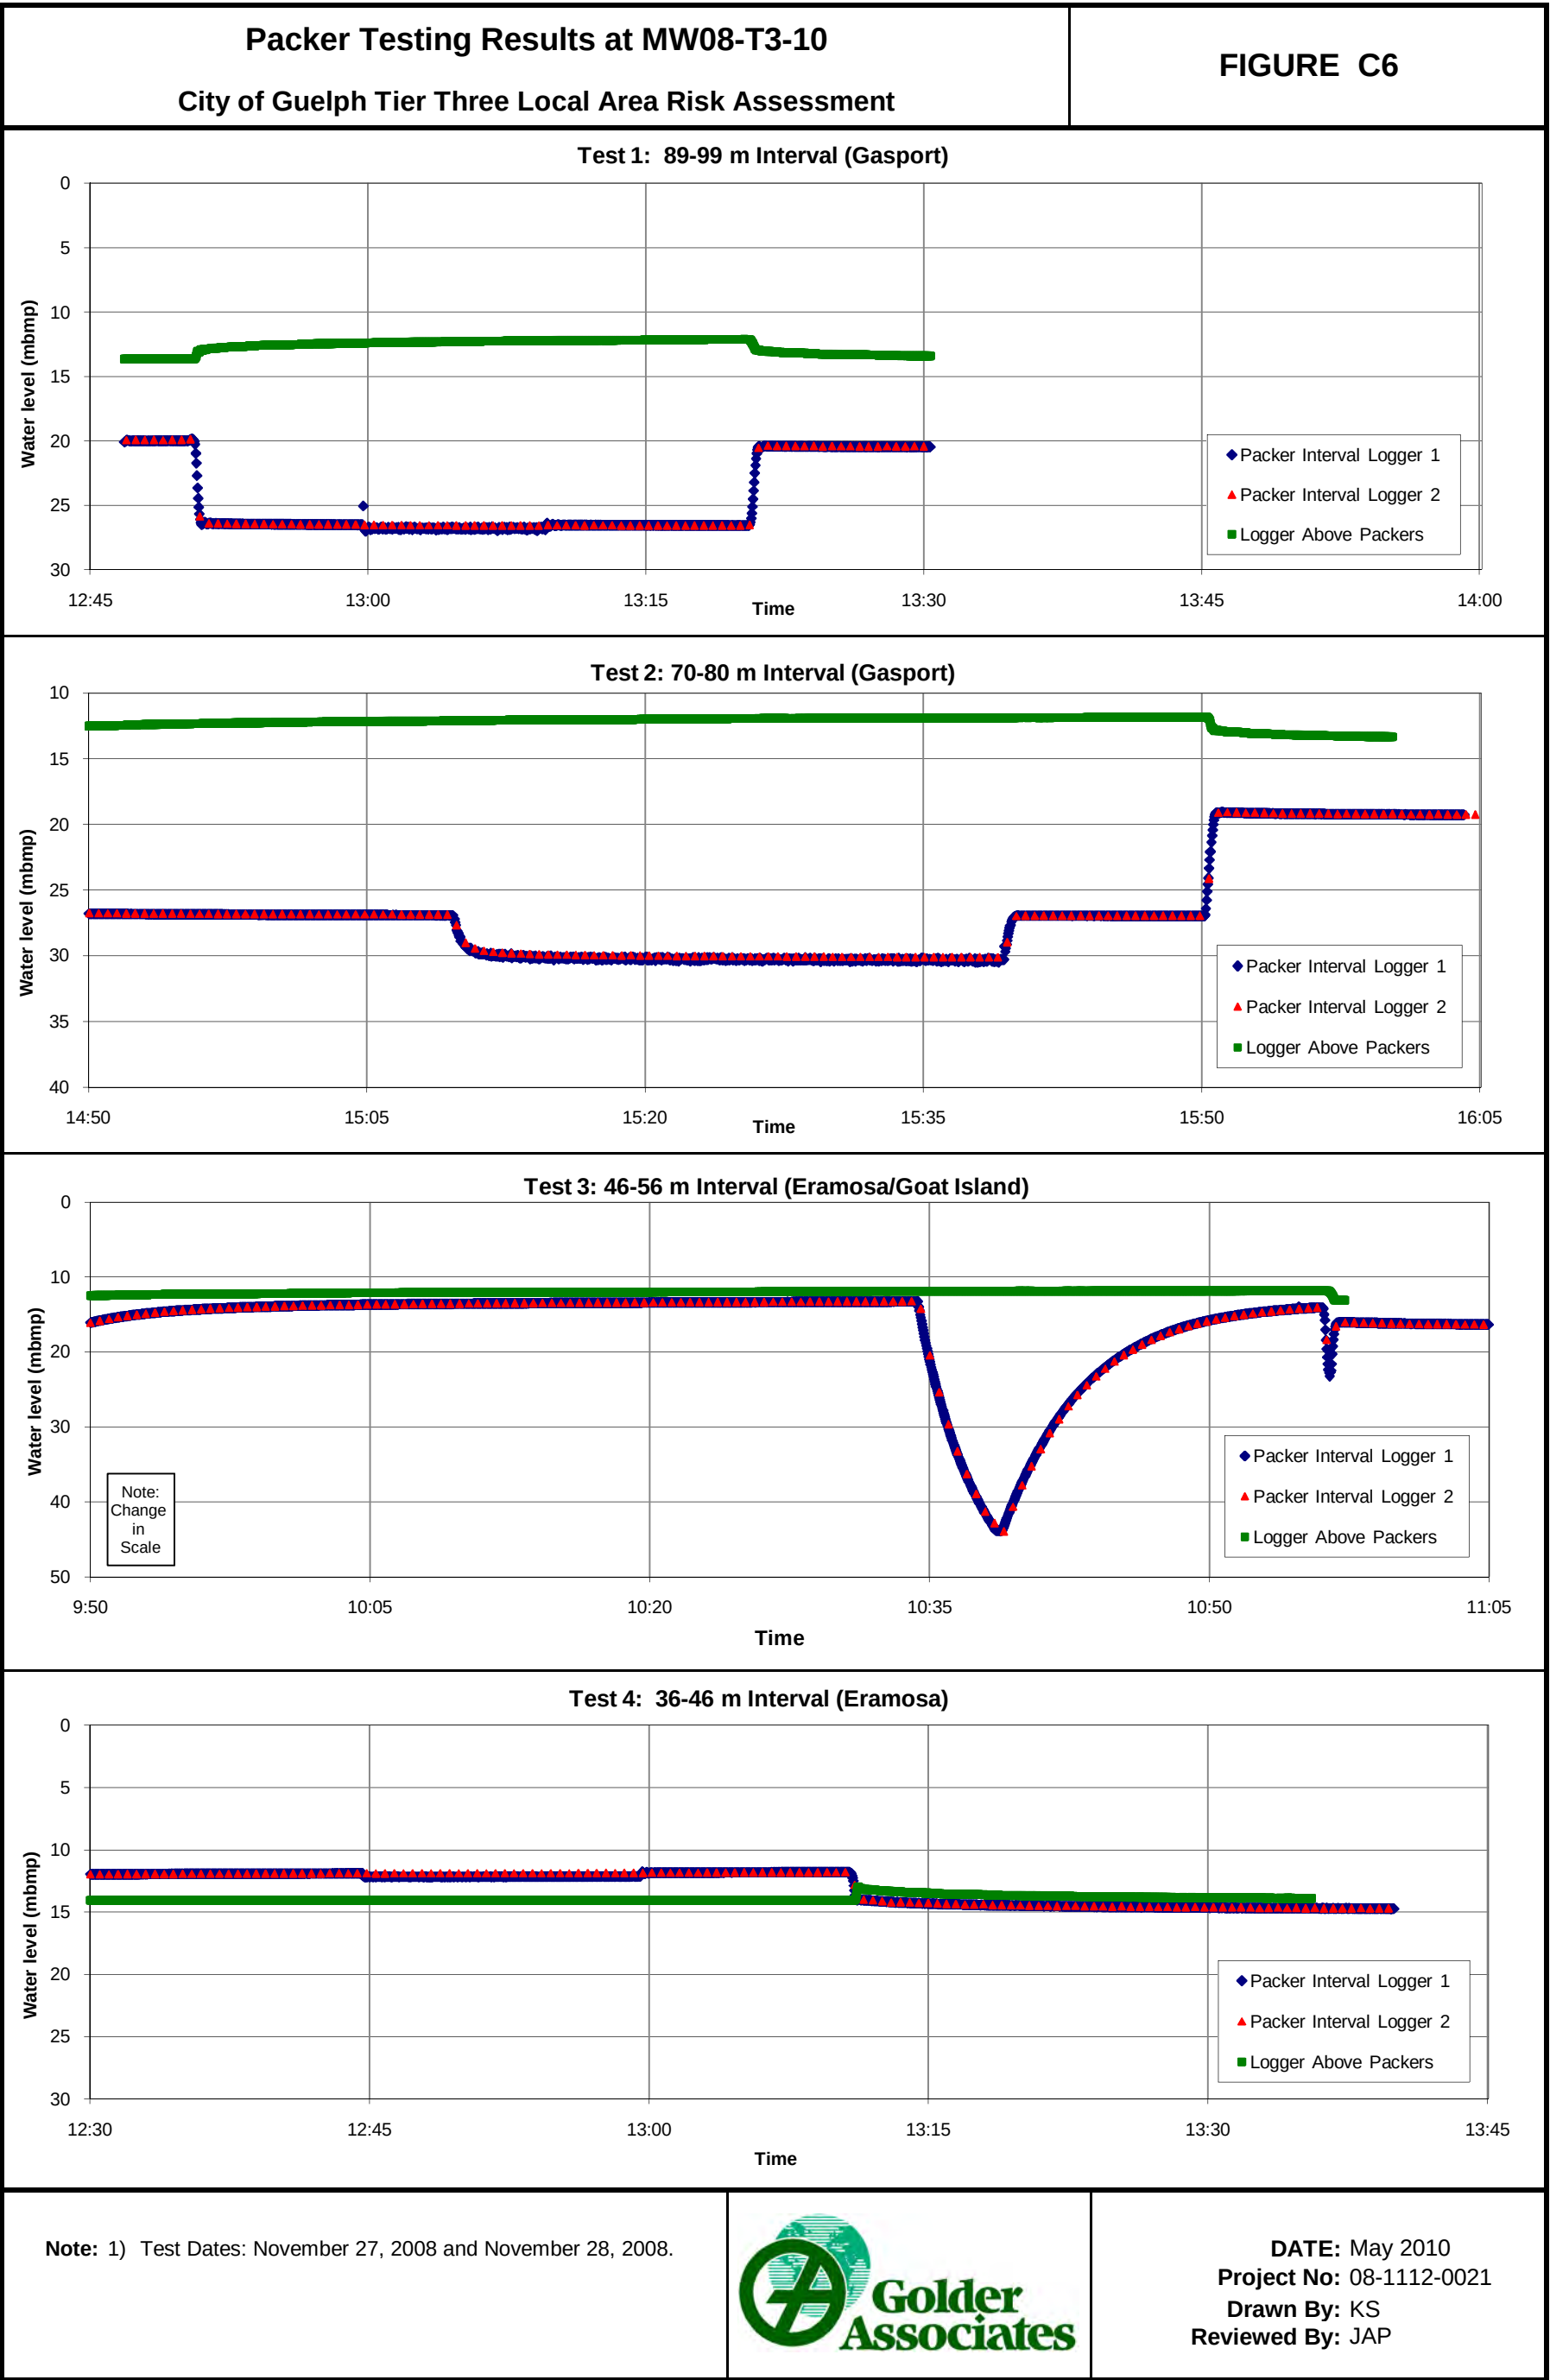

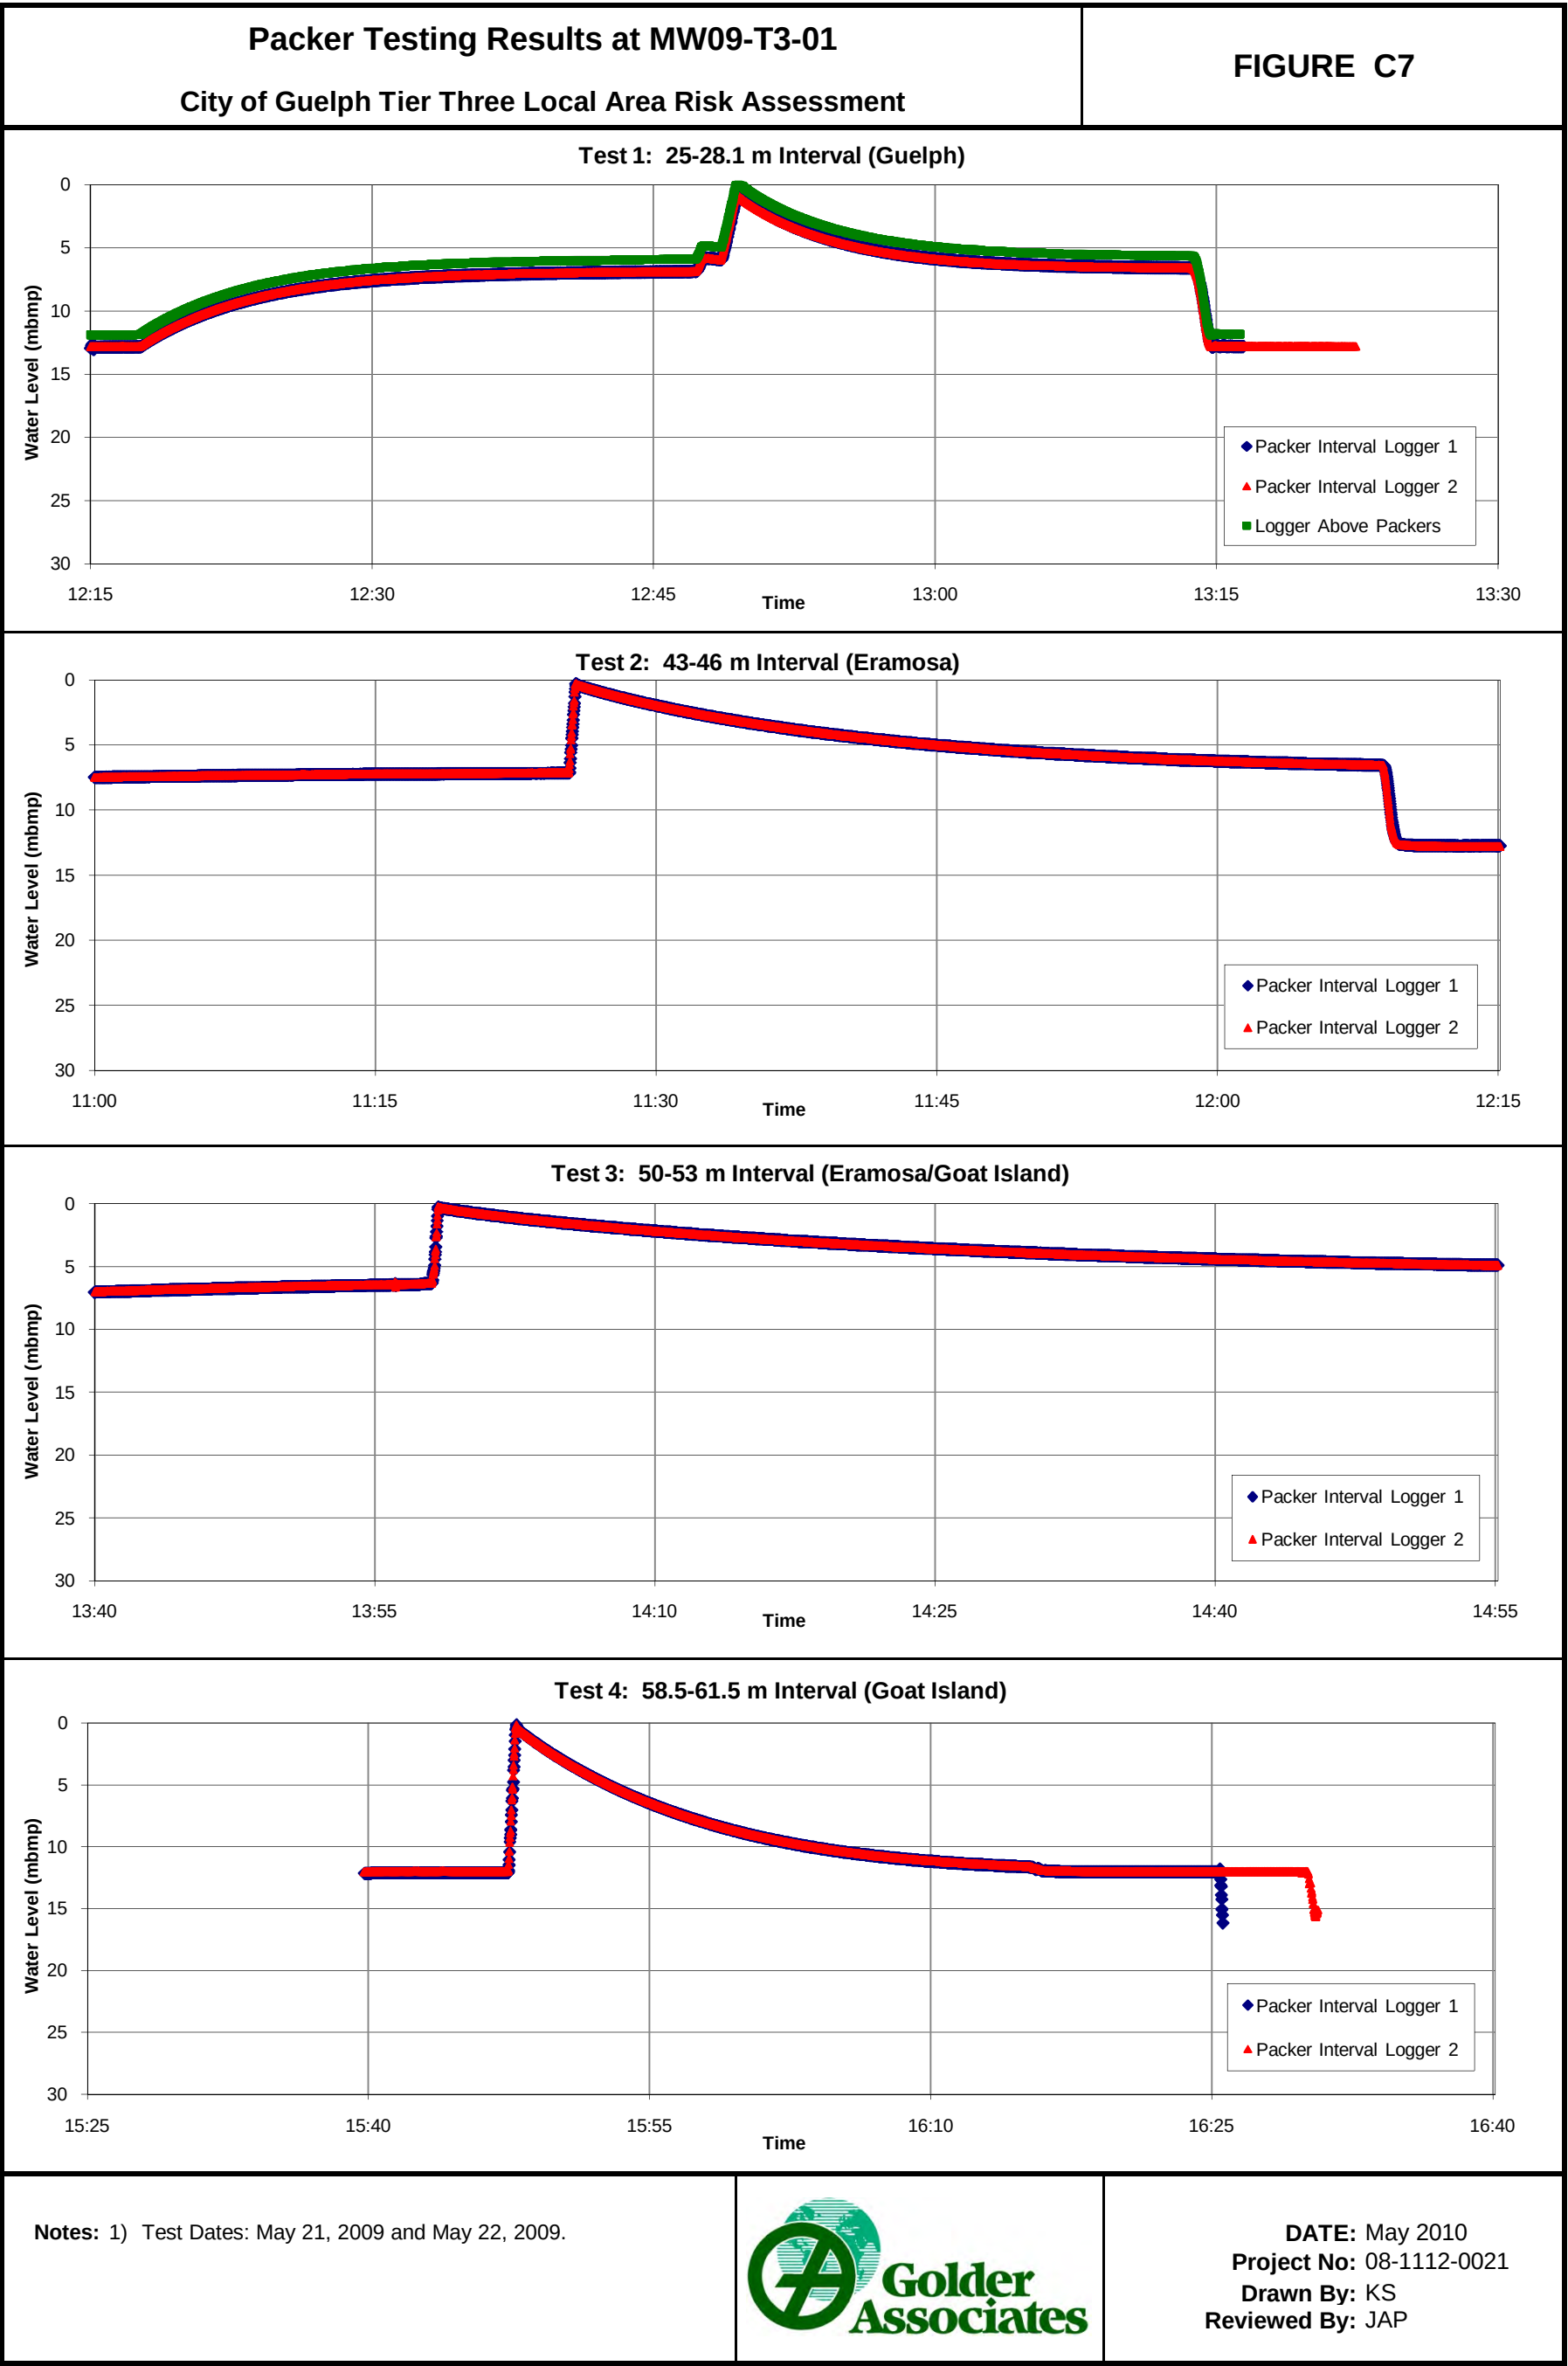


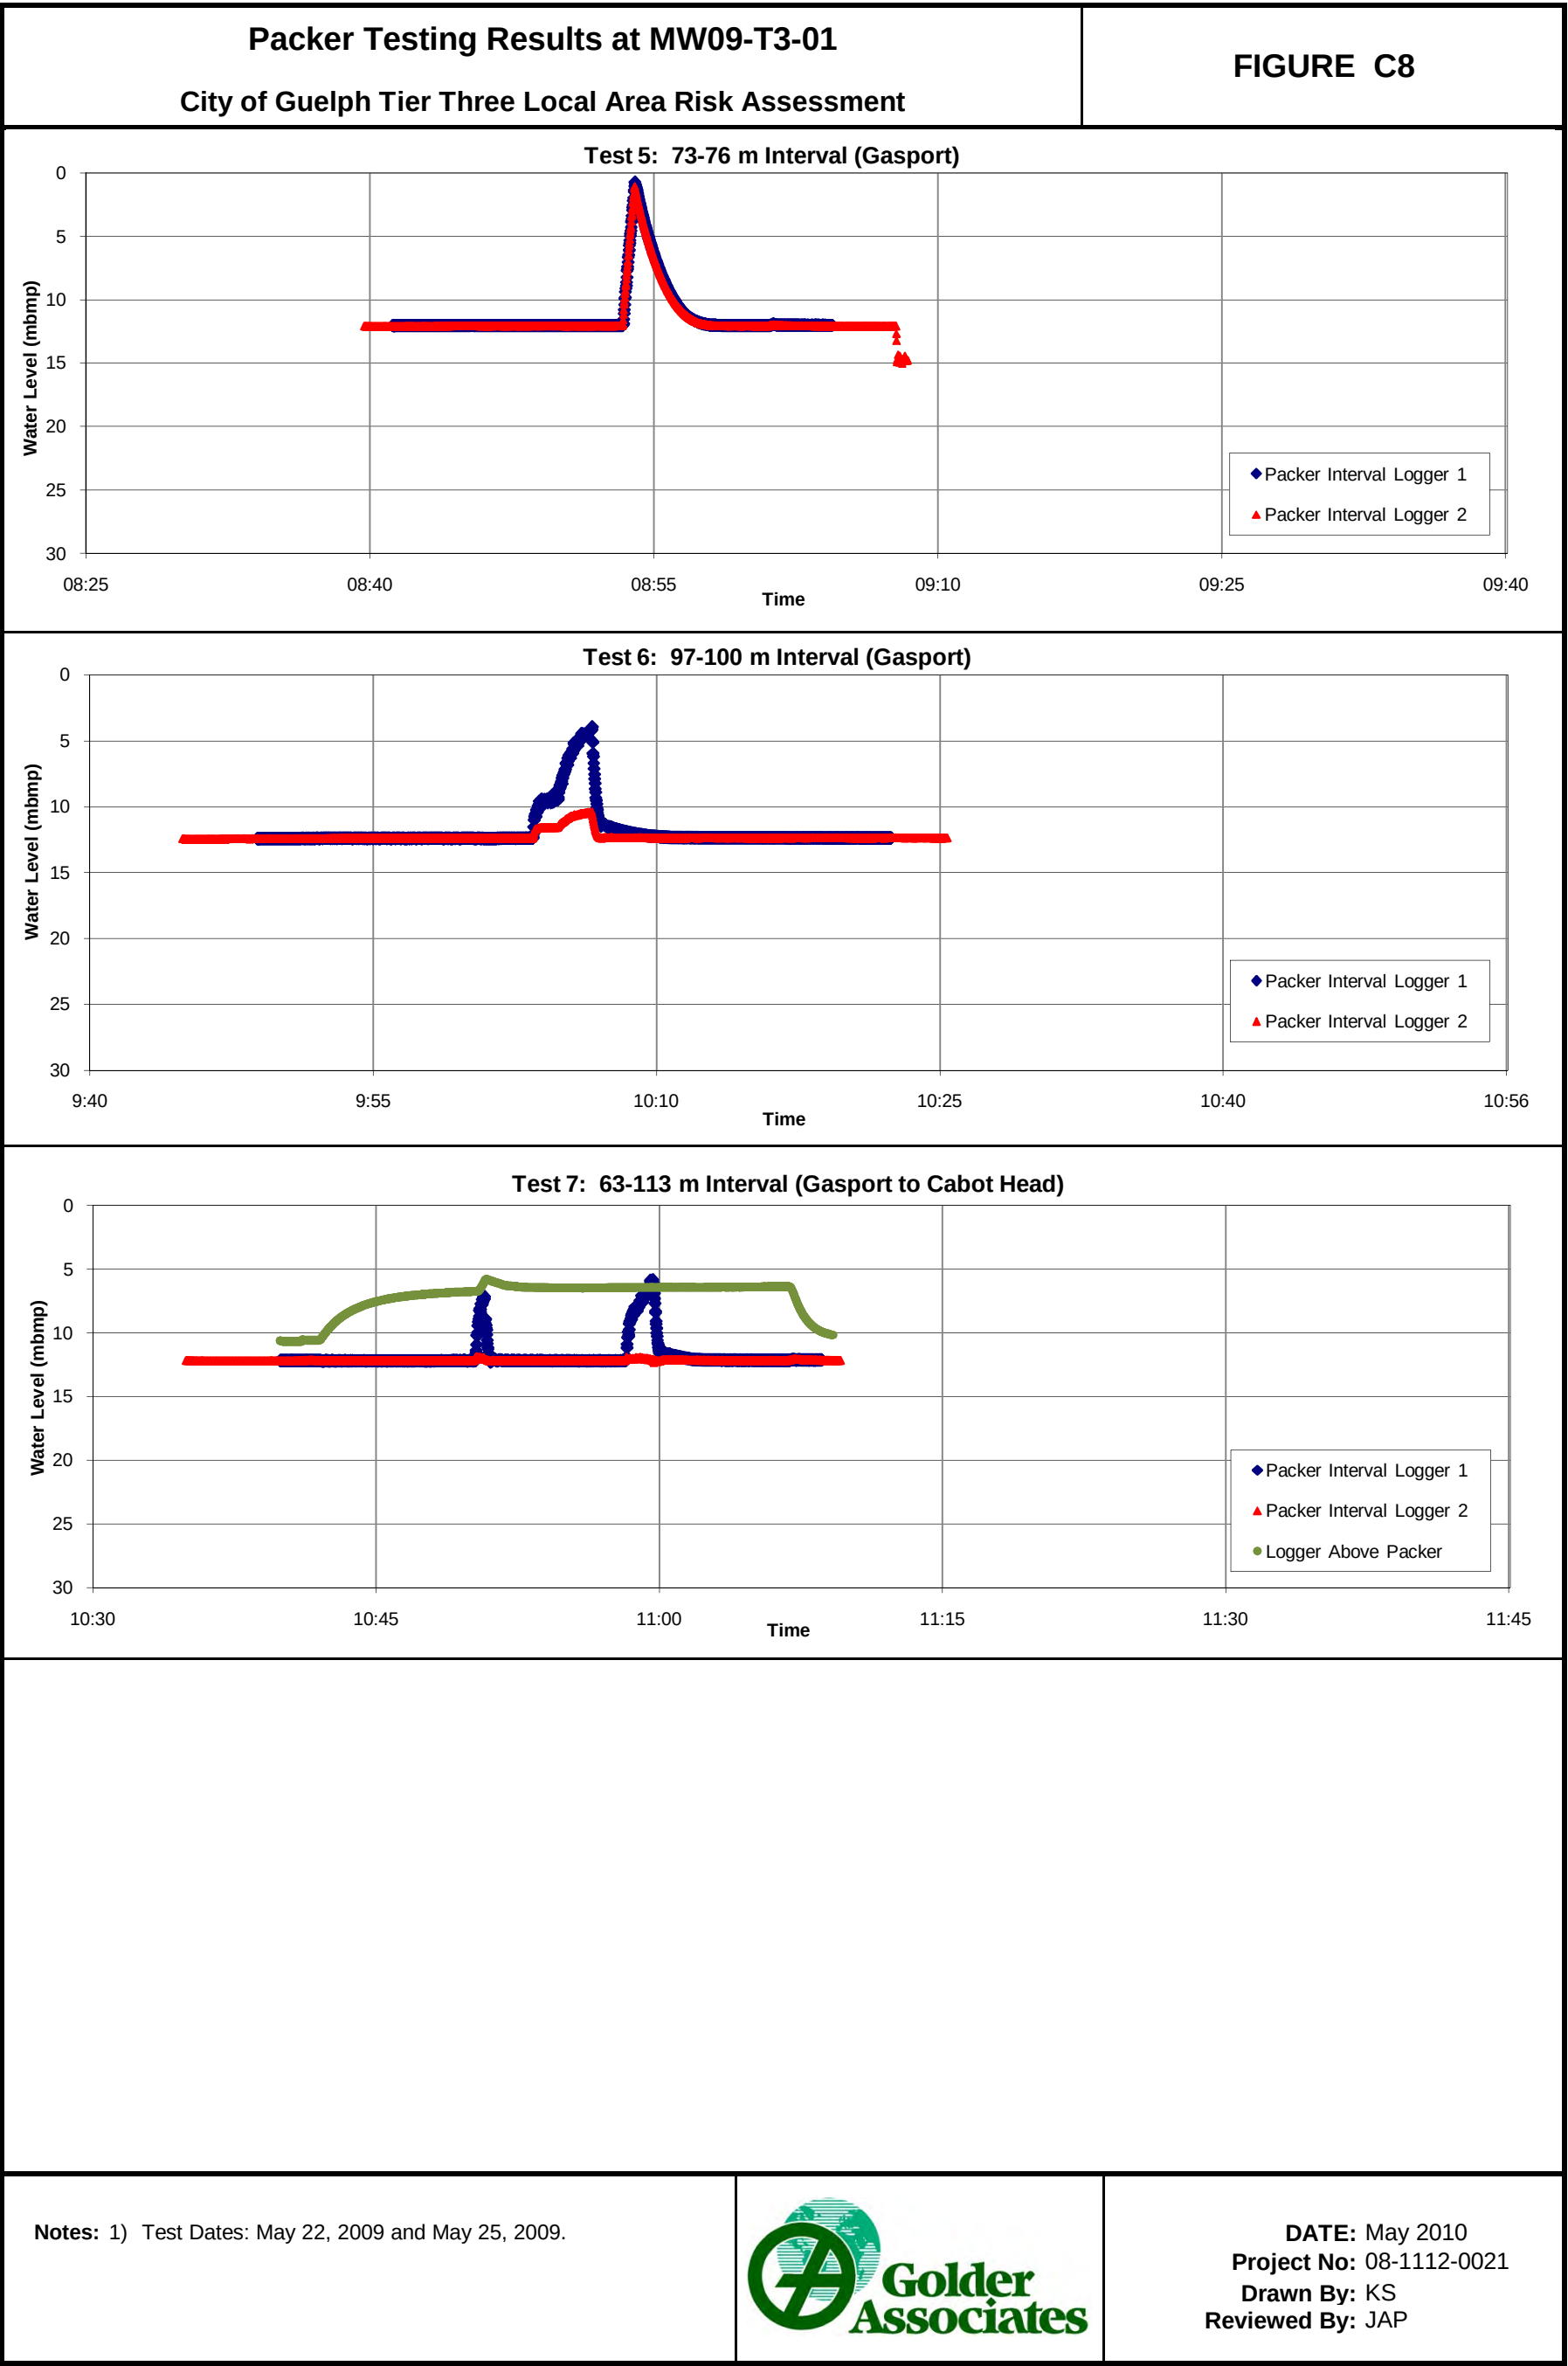




CITY OF GUELPH TIER THREE ASSESSMENT CHARACTERIZATION FINAL REPORT

C6: Specific Capacity Data

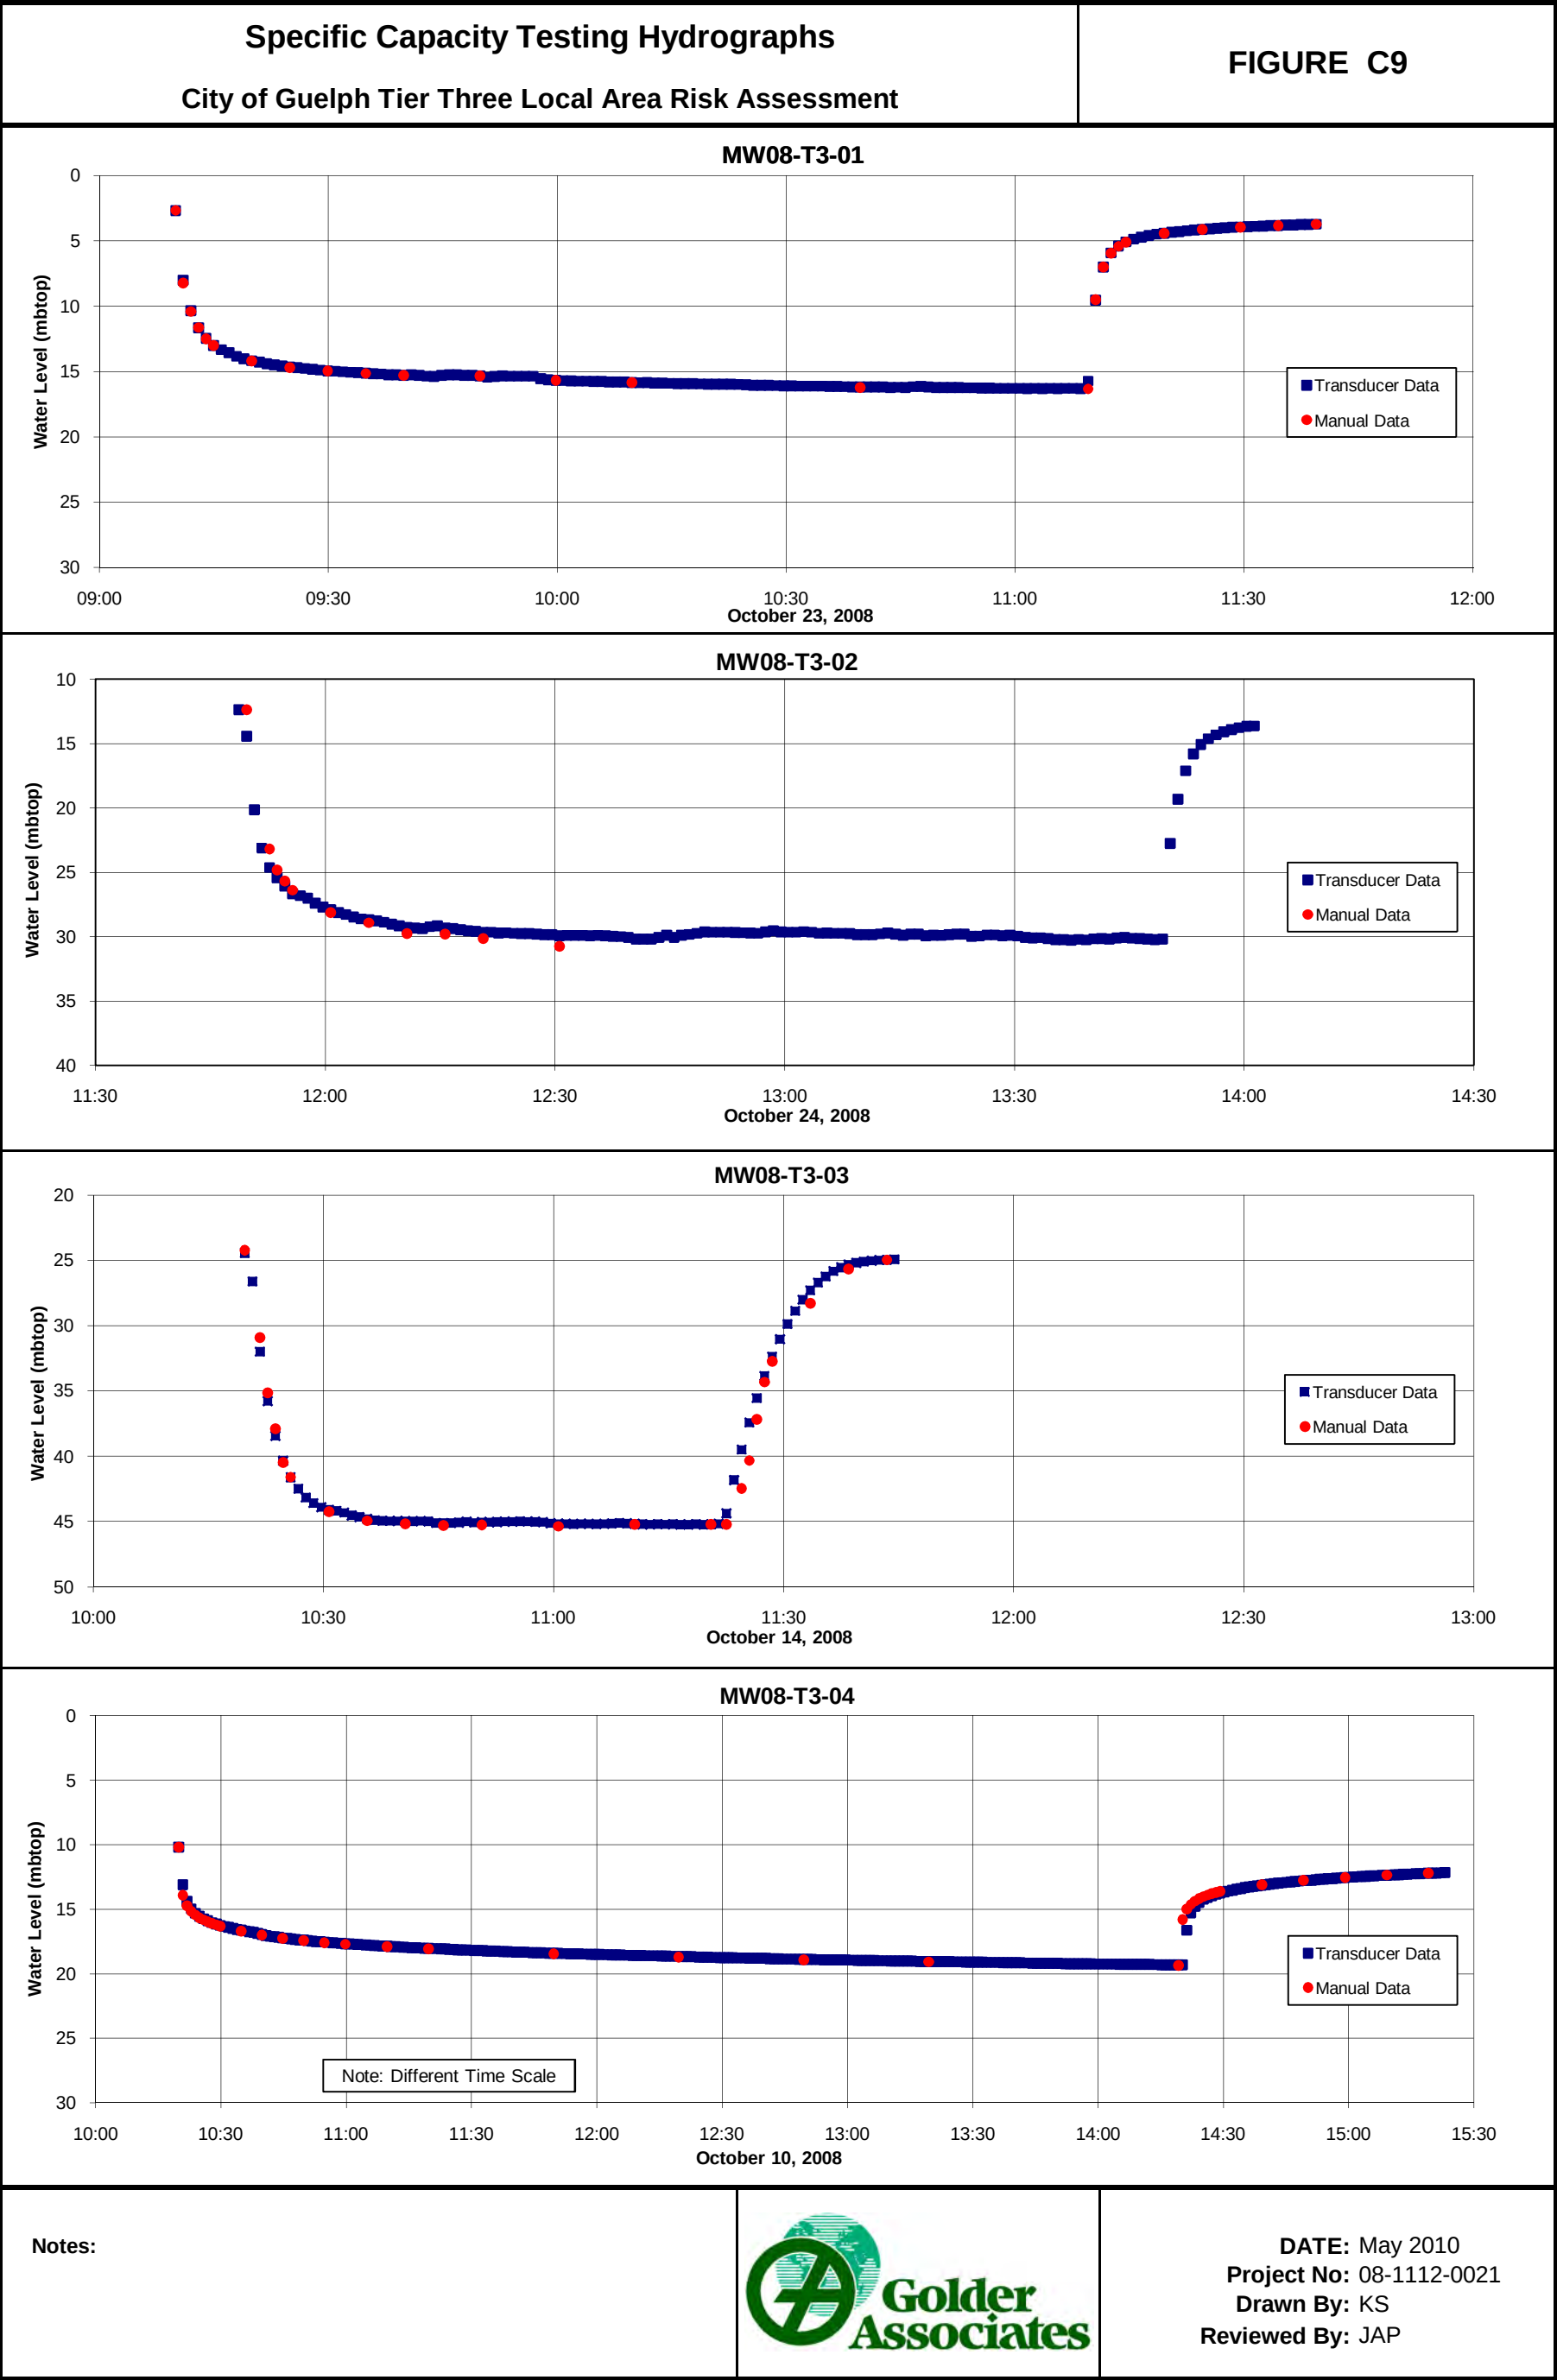


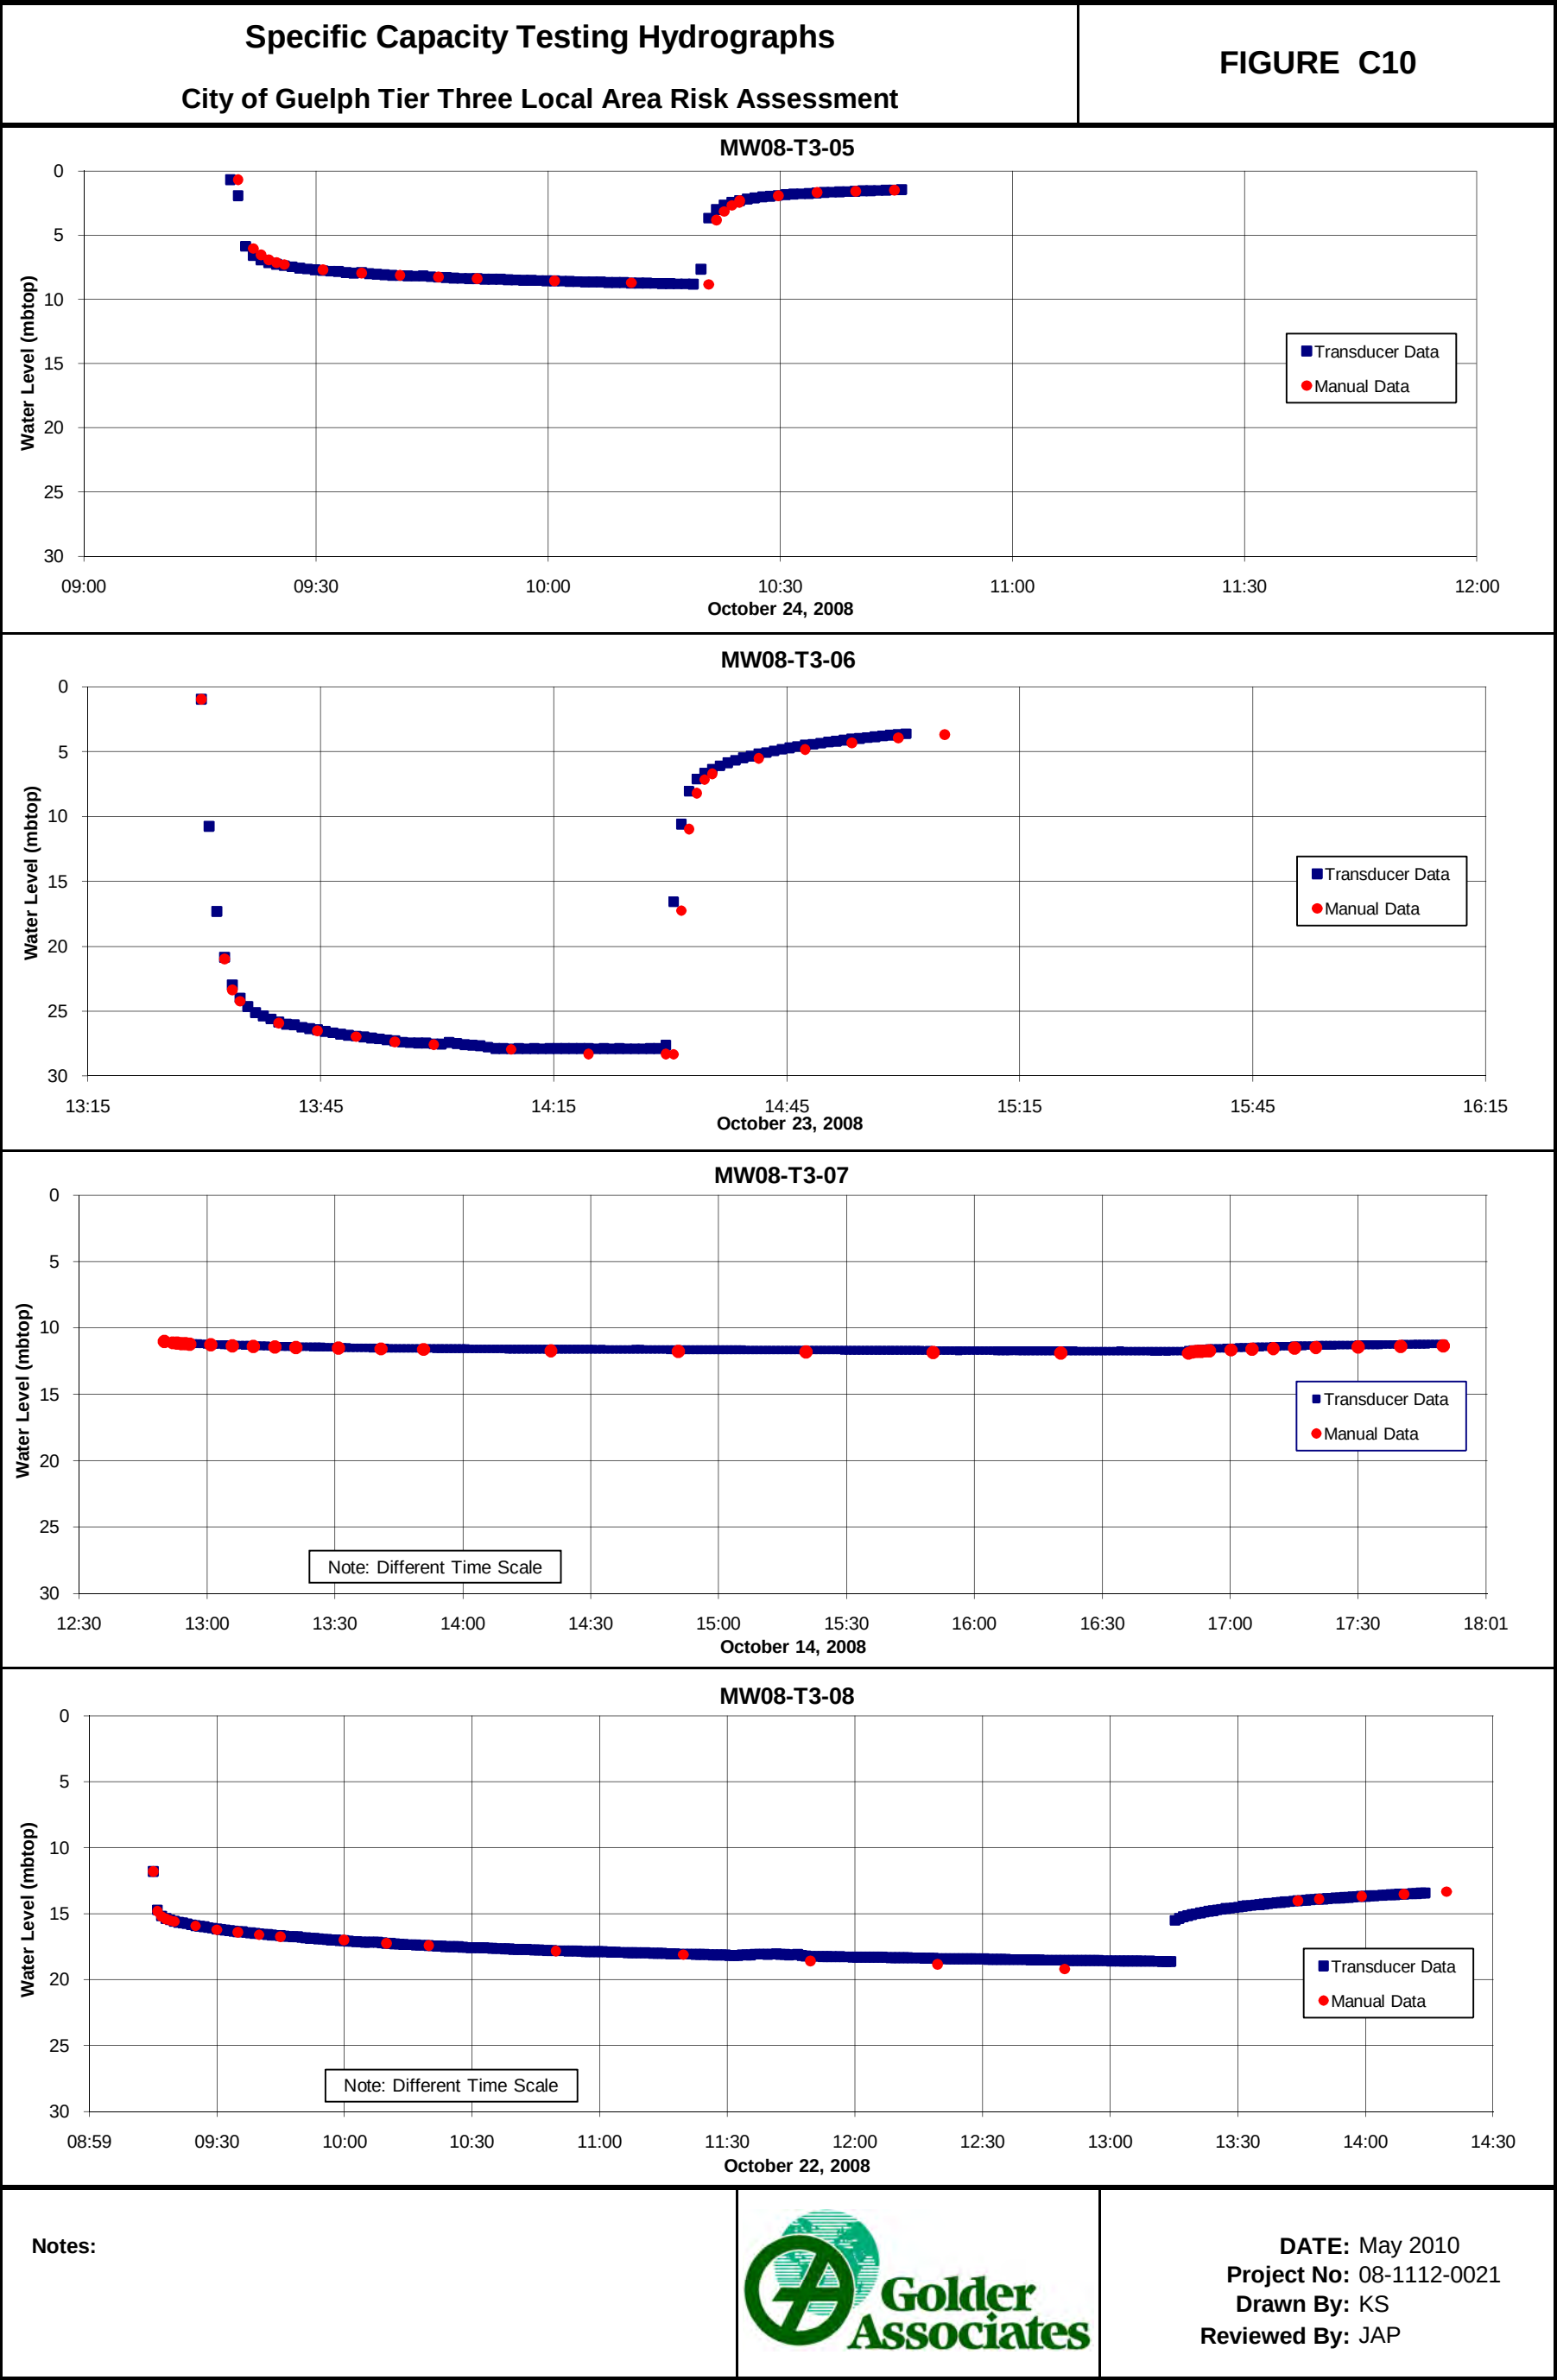



CITY OF GUELPH TIER THREE ASSESSMENT CHARACTERIZATION FINAL REPORT

C7: Water Level Monitoring Data

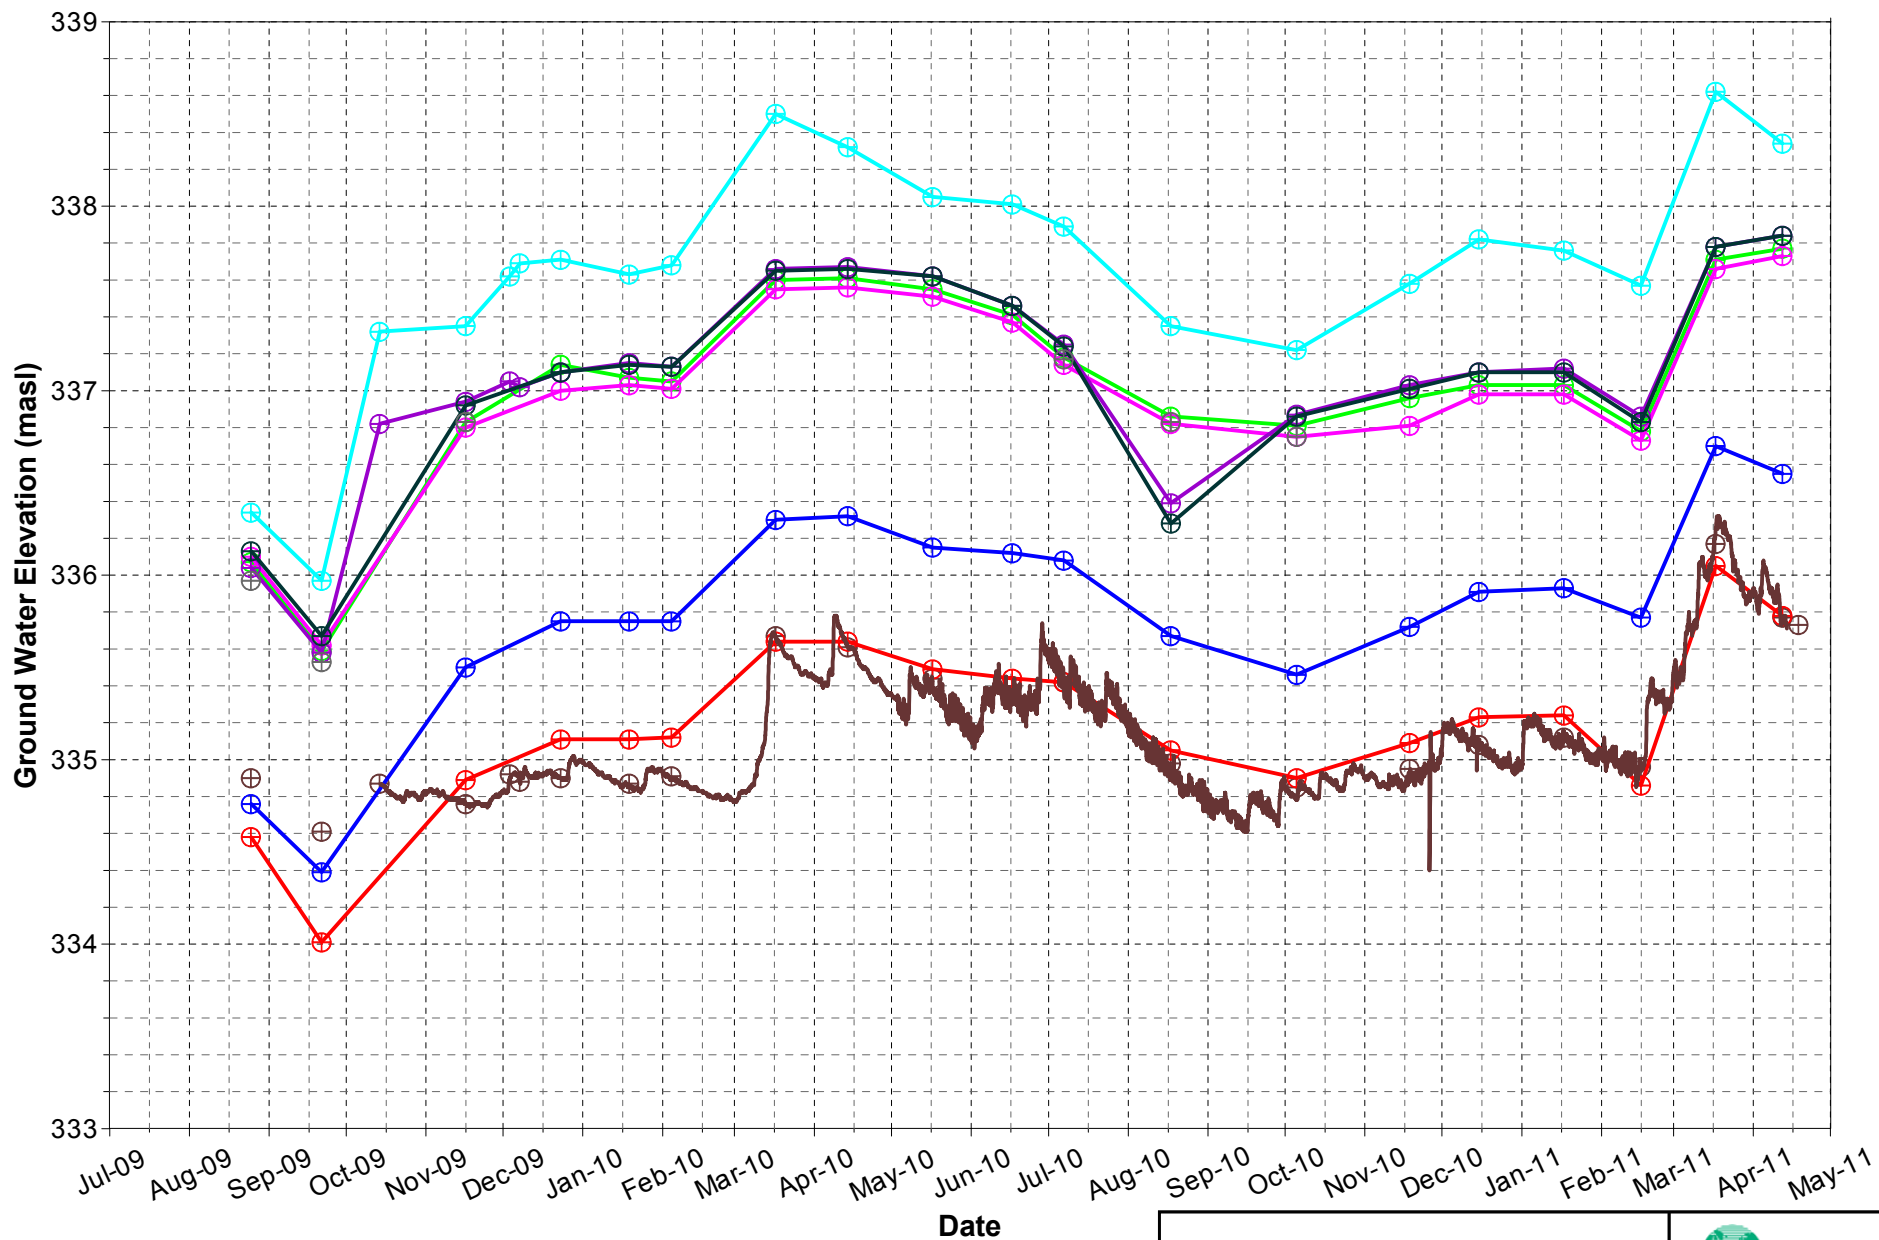

**City of Guelph
Tier Three Assessment
Water Level Monitoring**

MW08-T3-01 (Marden Tract)
Hydrographs




DRAWN: JLH

APPROVED: JAP

DATE: April 2011

PROJECT NUMBER: 08-1112-021

FIGURE: C12

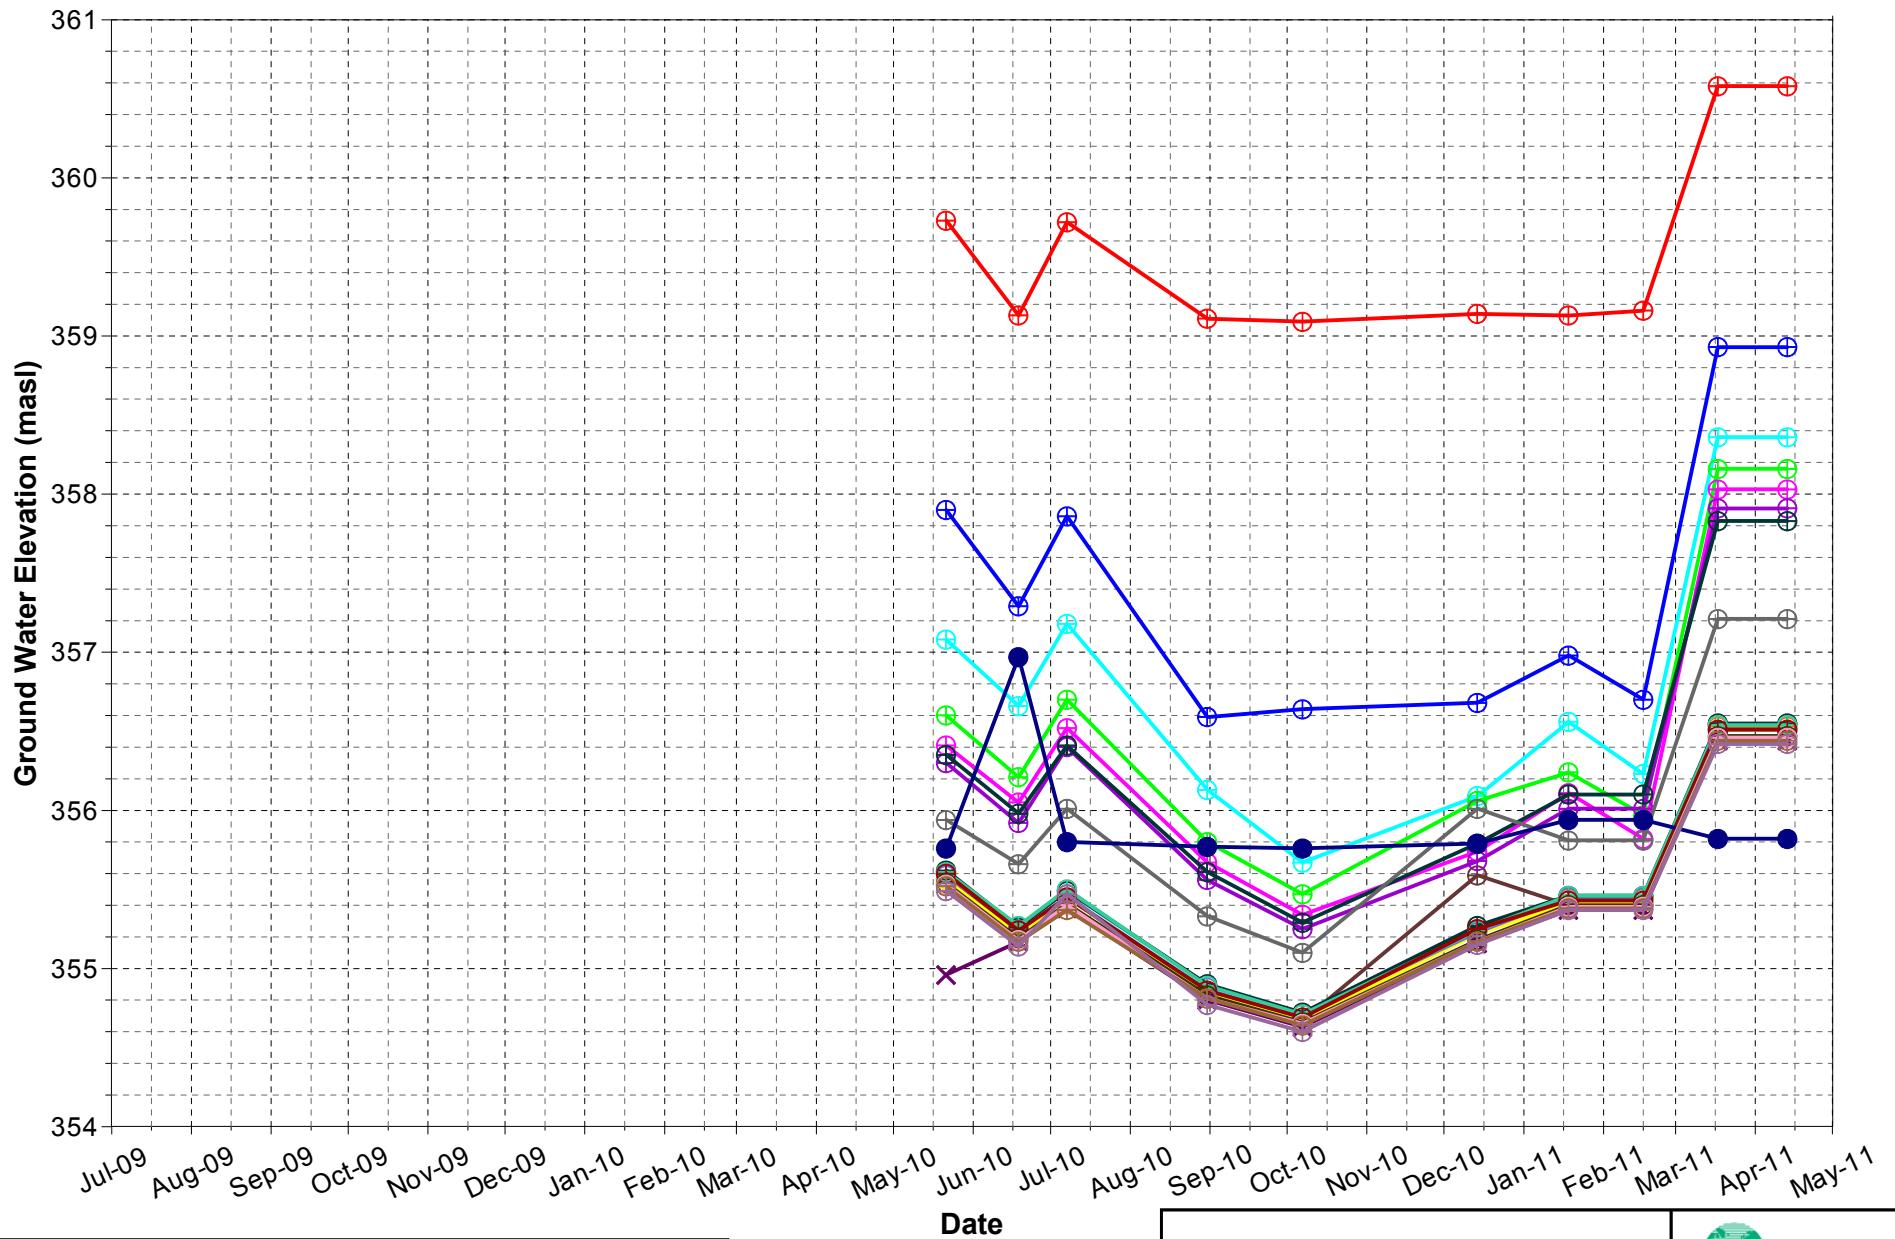


MW08-T3-02-1	MW08-T3-02-7	MW08-T3-02-13	MW08-T3-02-19
MW08-T3-02-2	MW08-T3-02-8	MW08-T3-02-14	MW08-T3-02-20
MW08-T3-02-3	MW08-T3-02-9	MW08-T3-02-15	MW08-T3-02-21
MW08-T3-02-4	MW08-T3-02-10	MW08-T3-02-16	MW08-T3-02-22
MW08-T3-02-5	MW08-T3-02-11	MW08-T3-02-17	MW08-T3-02-23
MW08-T3-02-6	MW08-T3-02-12	MW08-T3-02-18	

**City of Guelph
Tier Three Assessment
Water Level Monitoring**

MW08-T3-02 (Mill Road)
Hydrographs



DRAWN: JLH	APPROVED: JAP	DATE: April 2011
PROJECT NUMBER: 08-1112-021	FIGURE: C13	

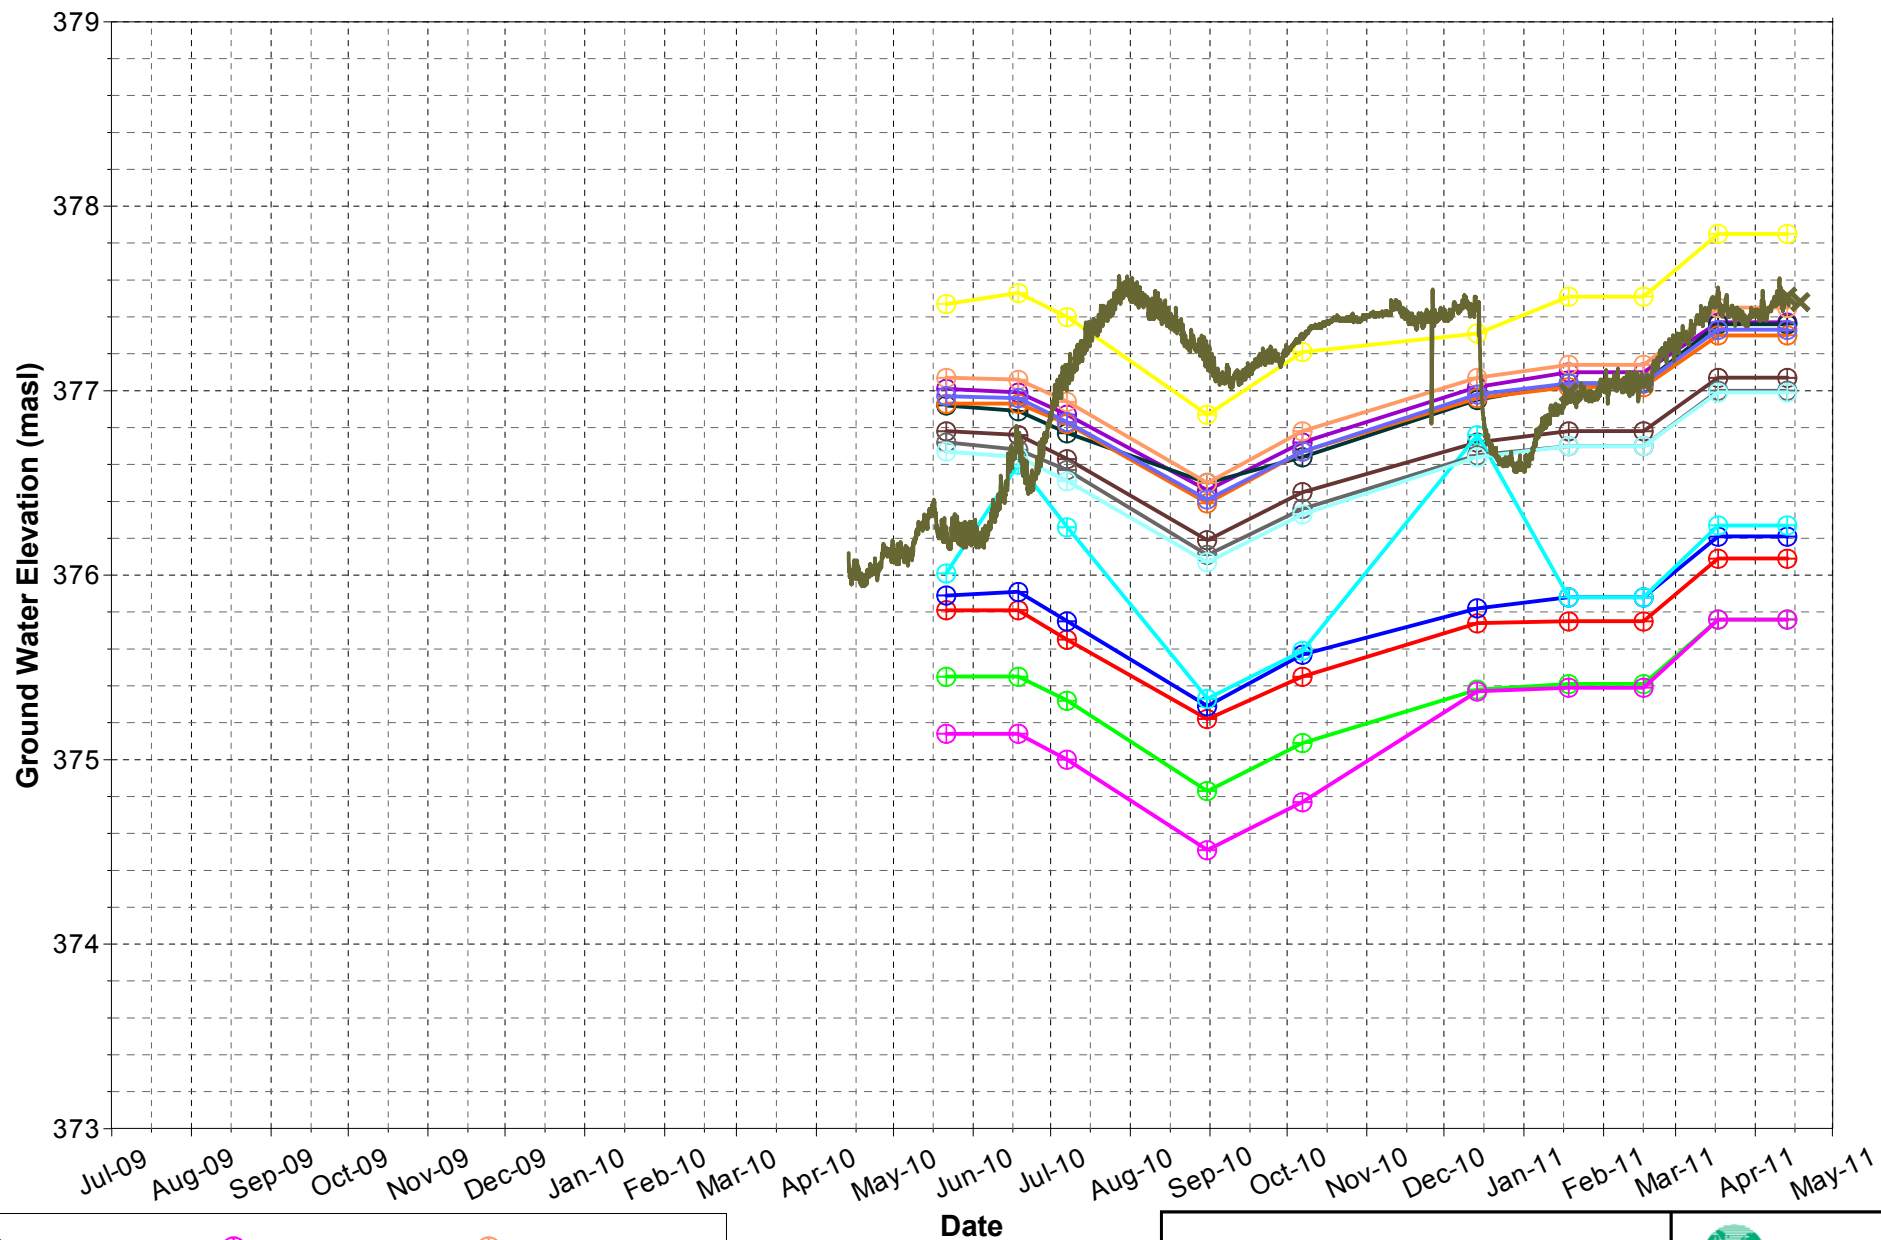


**City of Guelph
Tier Three Assessment
Water Level Monitoring**

MW08-T3-03 (Hurkman Tract)
Hydrographs



DRAWN: JLH	APPROVED: JAP	DATE: April 2011
PROJECT NUMBER: 08-1112-021		FIGURE: C14

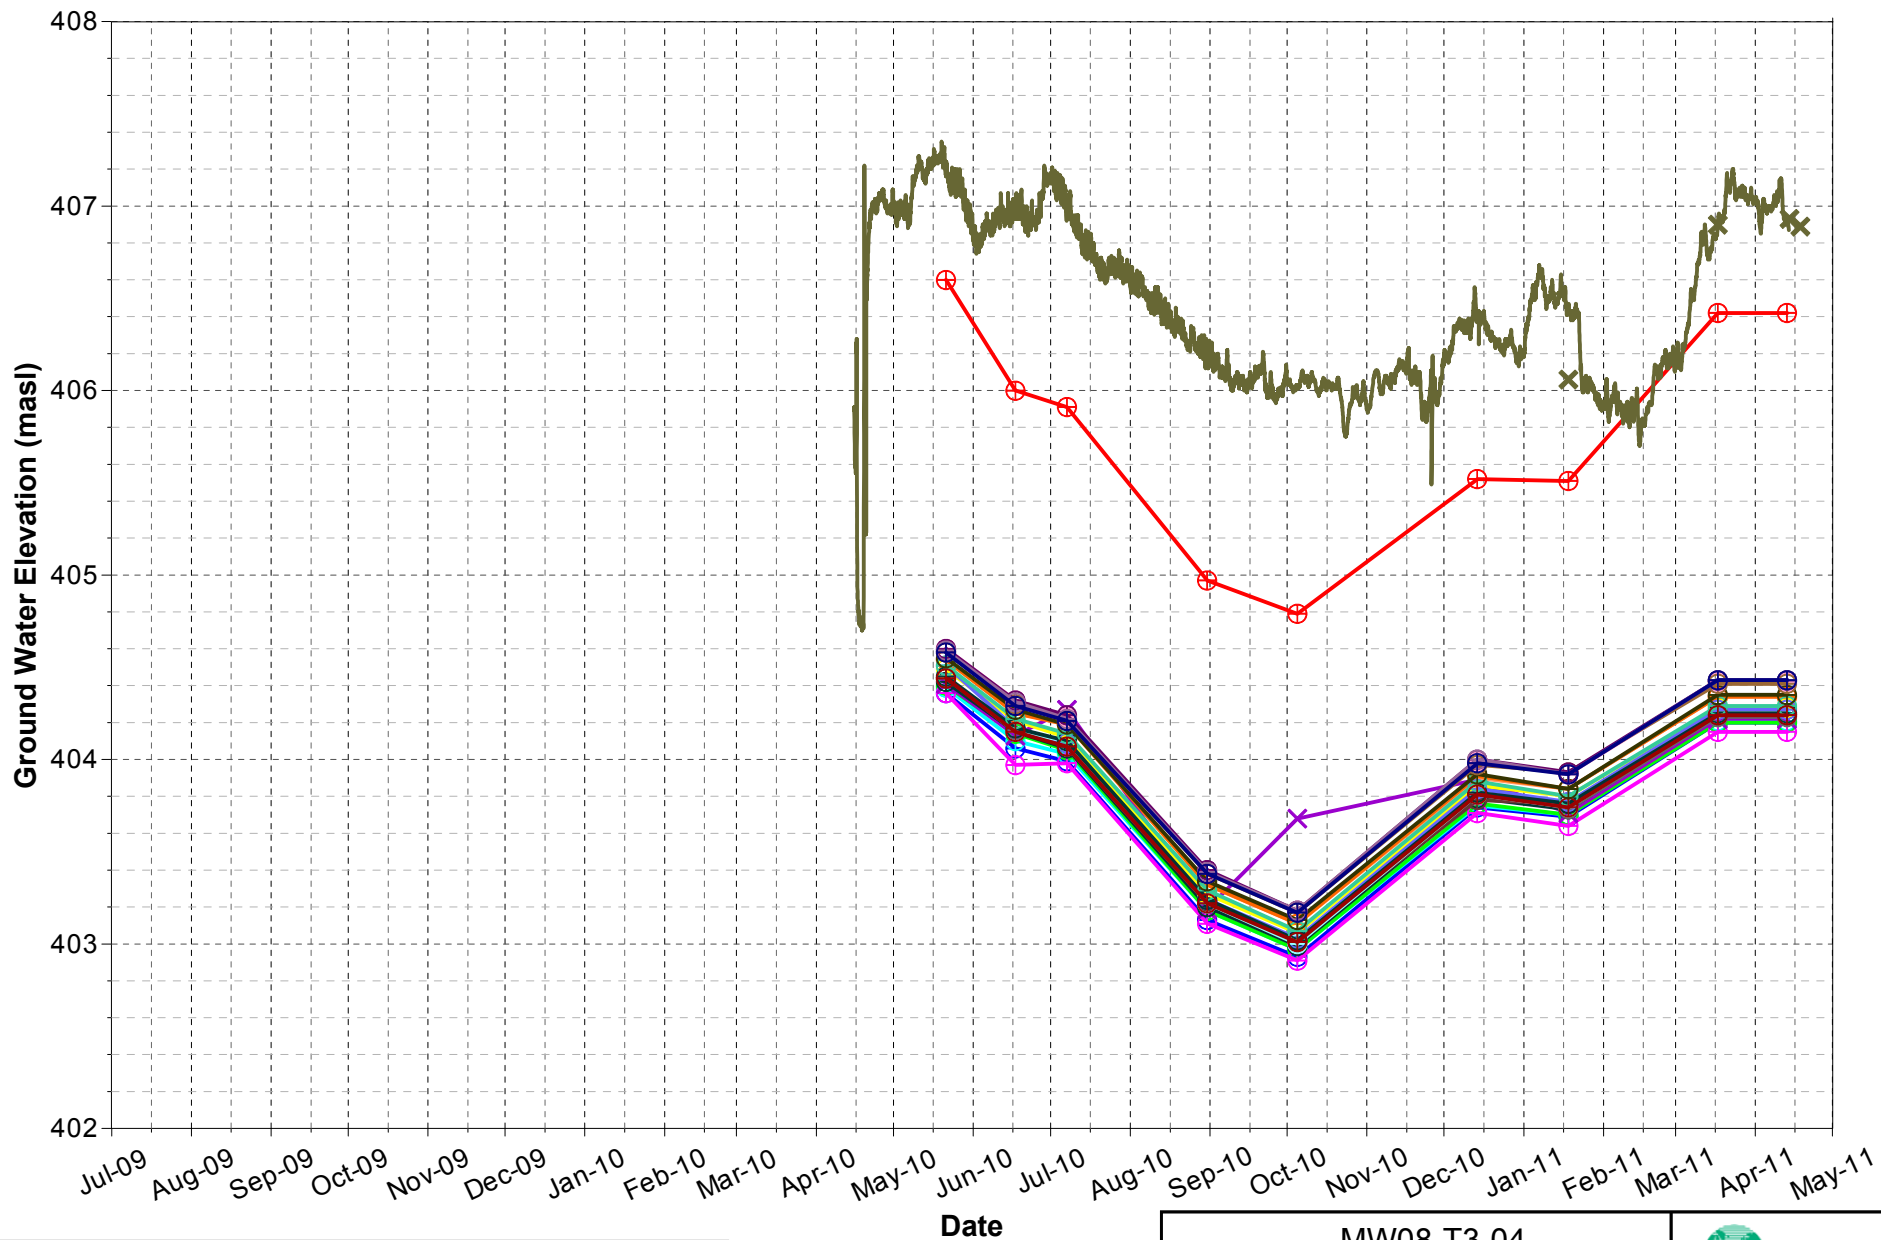


MW08-T3-04-1	MW08-T3-04-7	MW08-T3-04-13	MW08-T3-04-19
MW08-T3-04-2	MW08-T3-04-8	MW08-T3-04-14	MW08-T3-04-20
MW08-T3-04-3	MW08-T3-04-9	MW08-T3-04-15	MW08-T3-04-21
MW08-T3-04-4	MW08-T3-04-10	MW08-T3-04-16	MW08-T3-04-22
MW08-T3-04-5	MW08-T3-04-11	MW08-T3-04-17	MW08-T3-04-23
MW08-T3-04-6	MW08-T3-04-12	MW08-T3-04-18	MW08-T3-04-OB

**City of Guelph
Tier Three Assessment
Water Level Monitoring**

MW08-T3-04
(Hwy 6-South of Fergus)
Hydrographs



DRAWN: JLH	APPROVED: JAP	DATE: April 2011
PROJECT NUMBER: 08-1112-021		FIGURE: C15

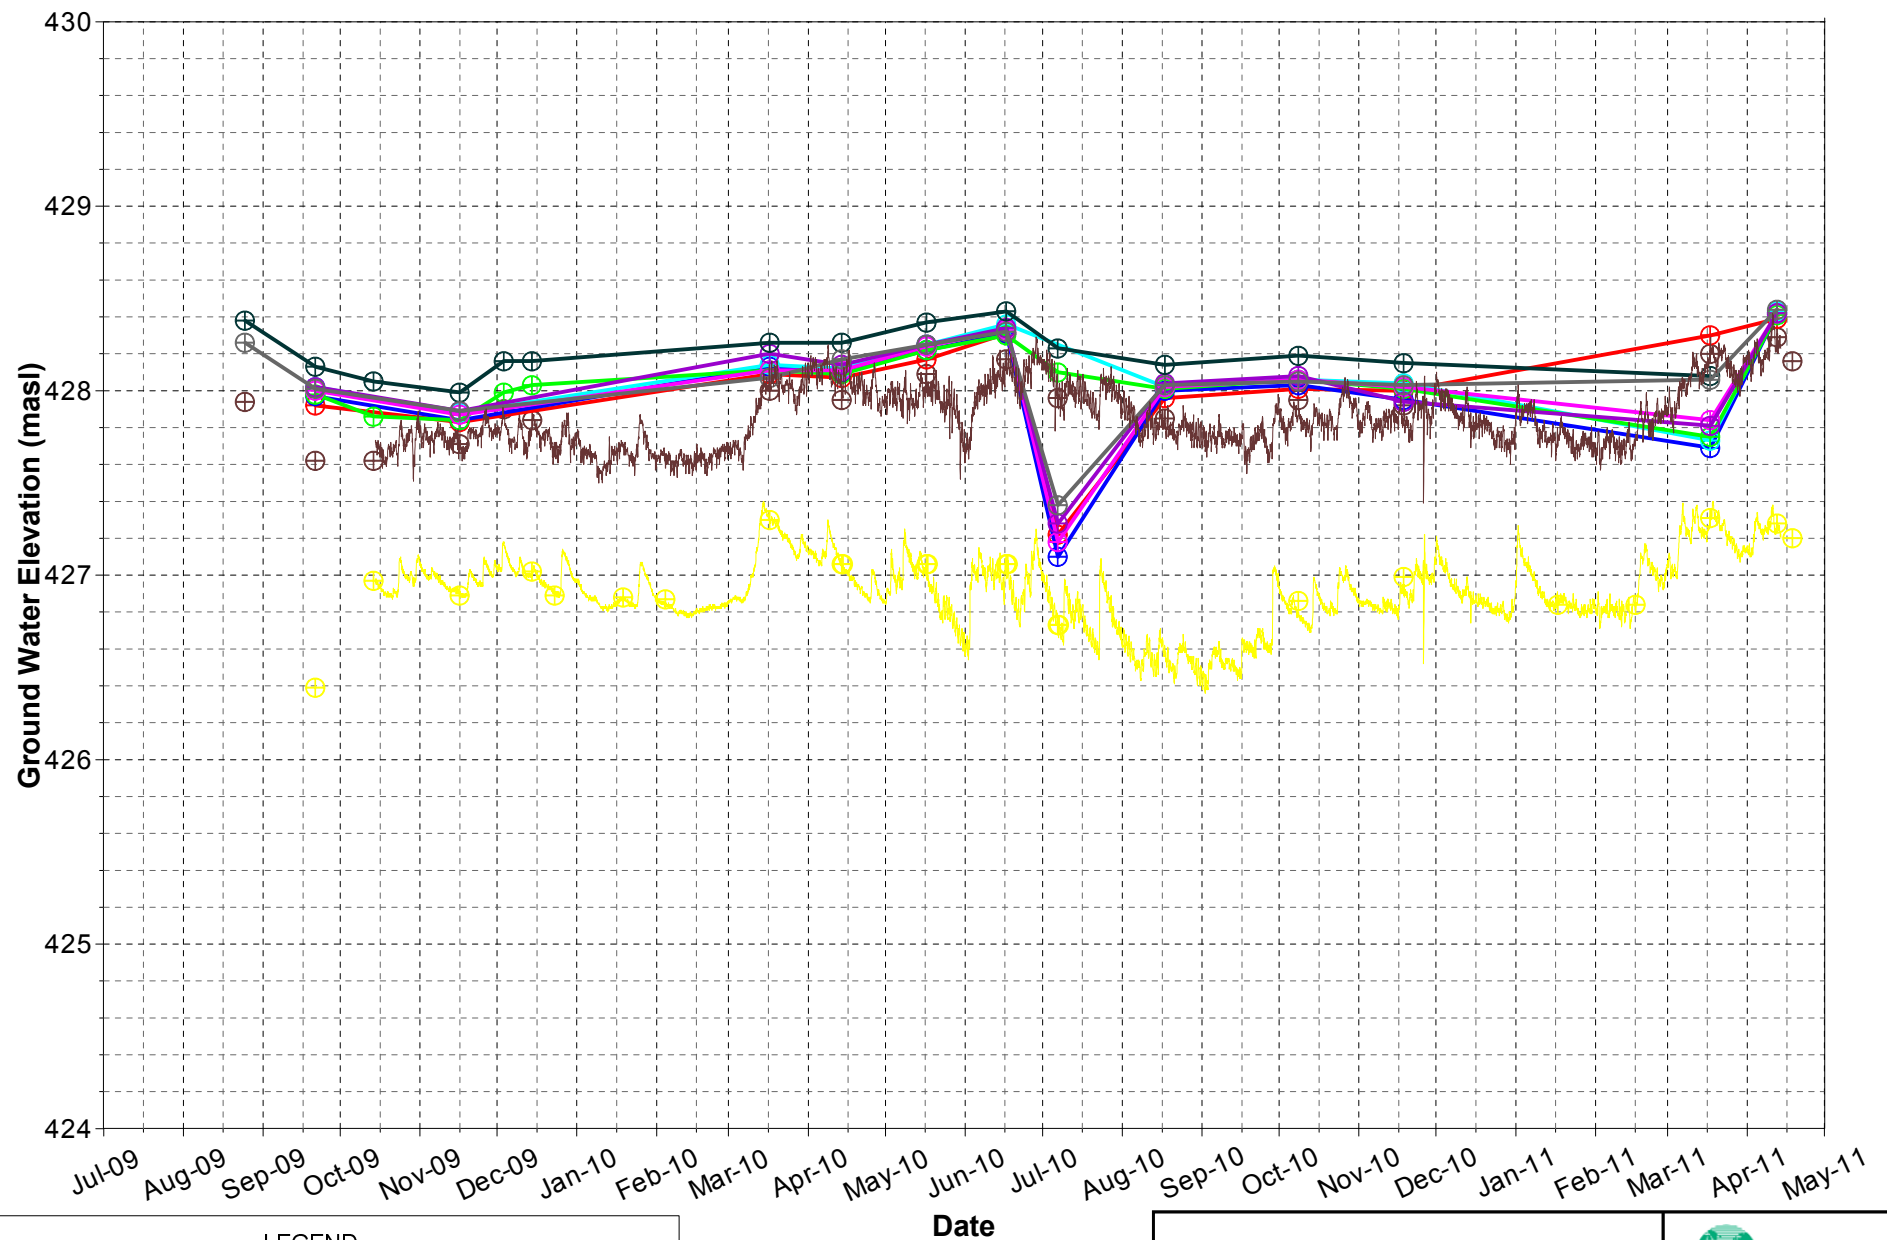


LEGEND					
	MW08-T3-05-1		MW08-T3-05-5		MW08-T3-05-8
	MW08-T3-05-2		MW08-T3-05-6		MW08-T3-05-CS
	MW08-T3-05-3		MW08-T3-05-7		MW08-T3-05-OB
	MW08-T3-05-4				

**City of Guelph
Tier Three Assessment
Water Level Monitoring**

MW08-T3-05 (Johnson Tract)
Hydrographs



DRAWN: JLH	APPROVED: JAP	DATE: April 2011
PROJECT NUMBER: 08-1112-021	FIGURE: C16	

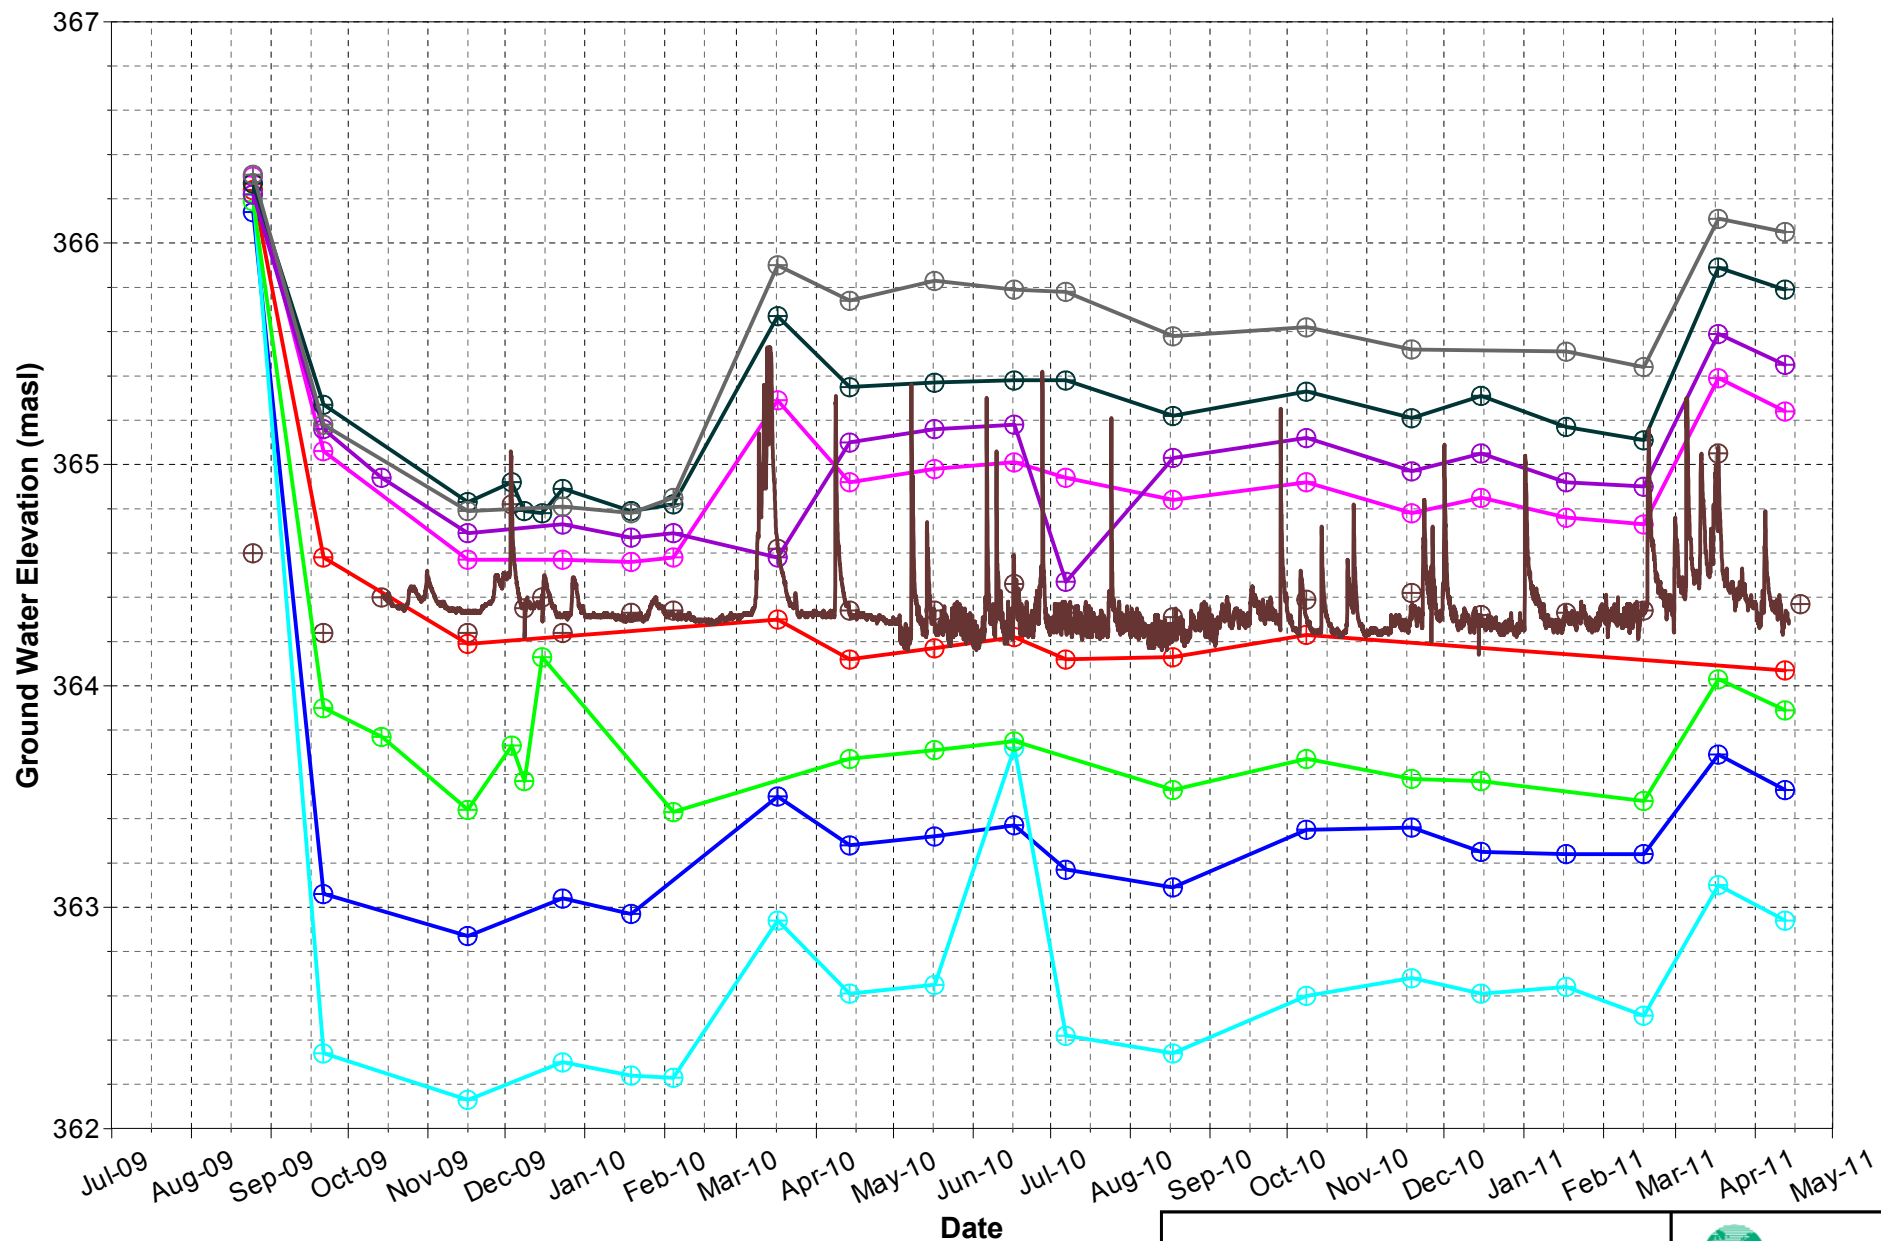

**City of Guelph
Tier Three Assessment
Water Level Monitoring**

MW08-T3-06 (Everton)
Hydrographs




DRAWN: JLH

APPROVED: JAP

DATE: April 2011

PROJECT NUMBER: 08-1112-021

FIGURE: C17

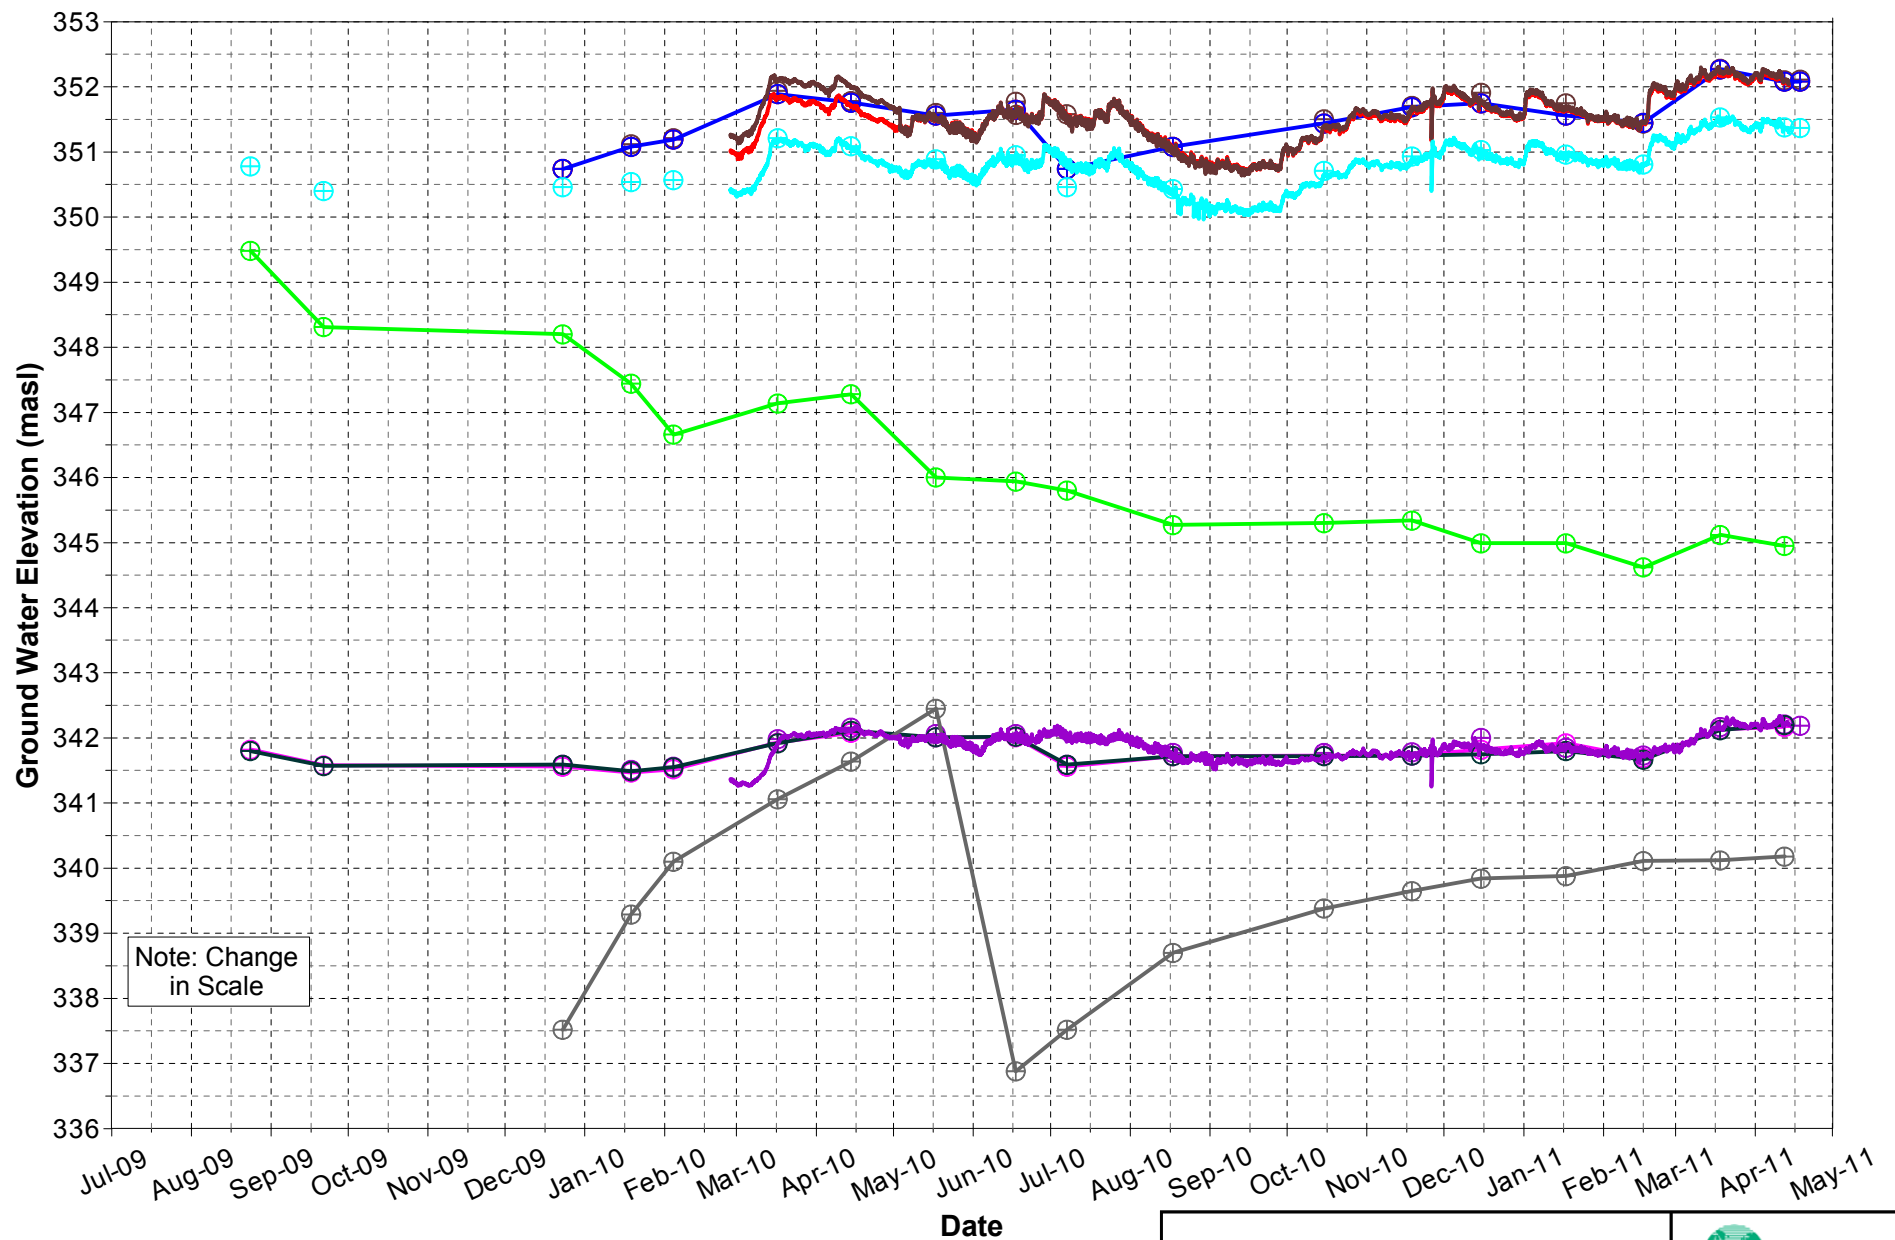

**City of Guelph
Tier Three Assessment
Water Level Monitoring**

MW08-T3-07 (County Rd 29)
Hydrographs




DRAWN: JLH

APPROVED: JAP

DATE: April 2011

PROJECT NUMBER: 08-1112-021

FIGURE: C18

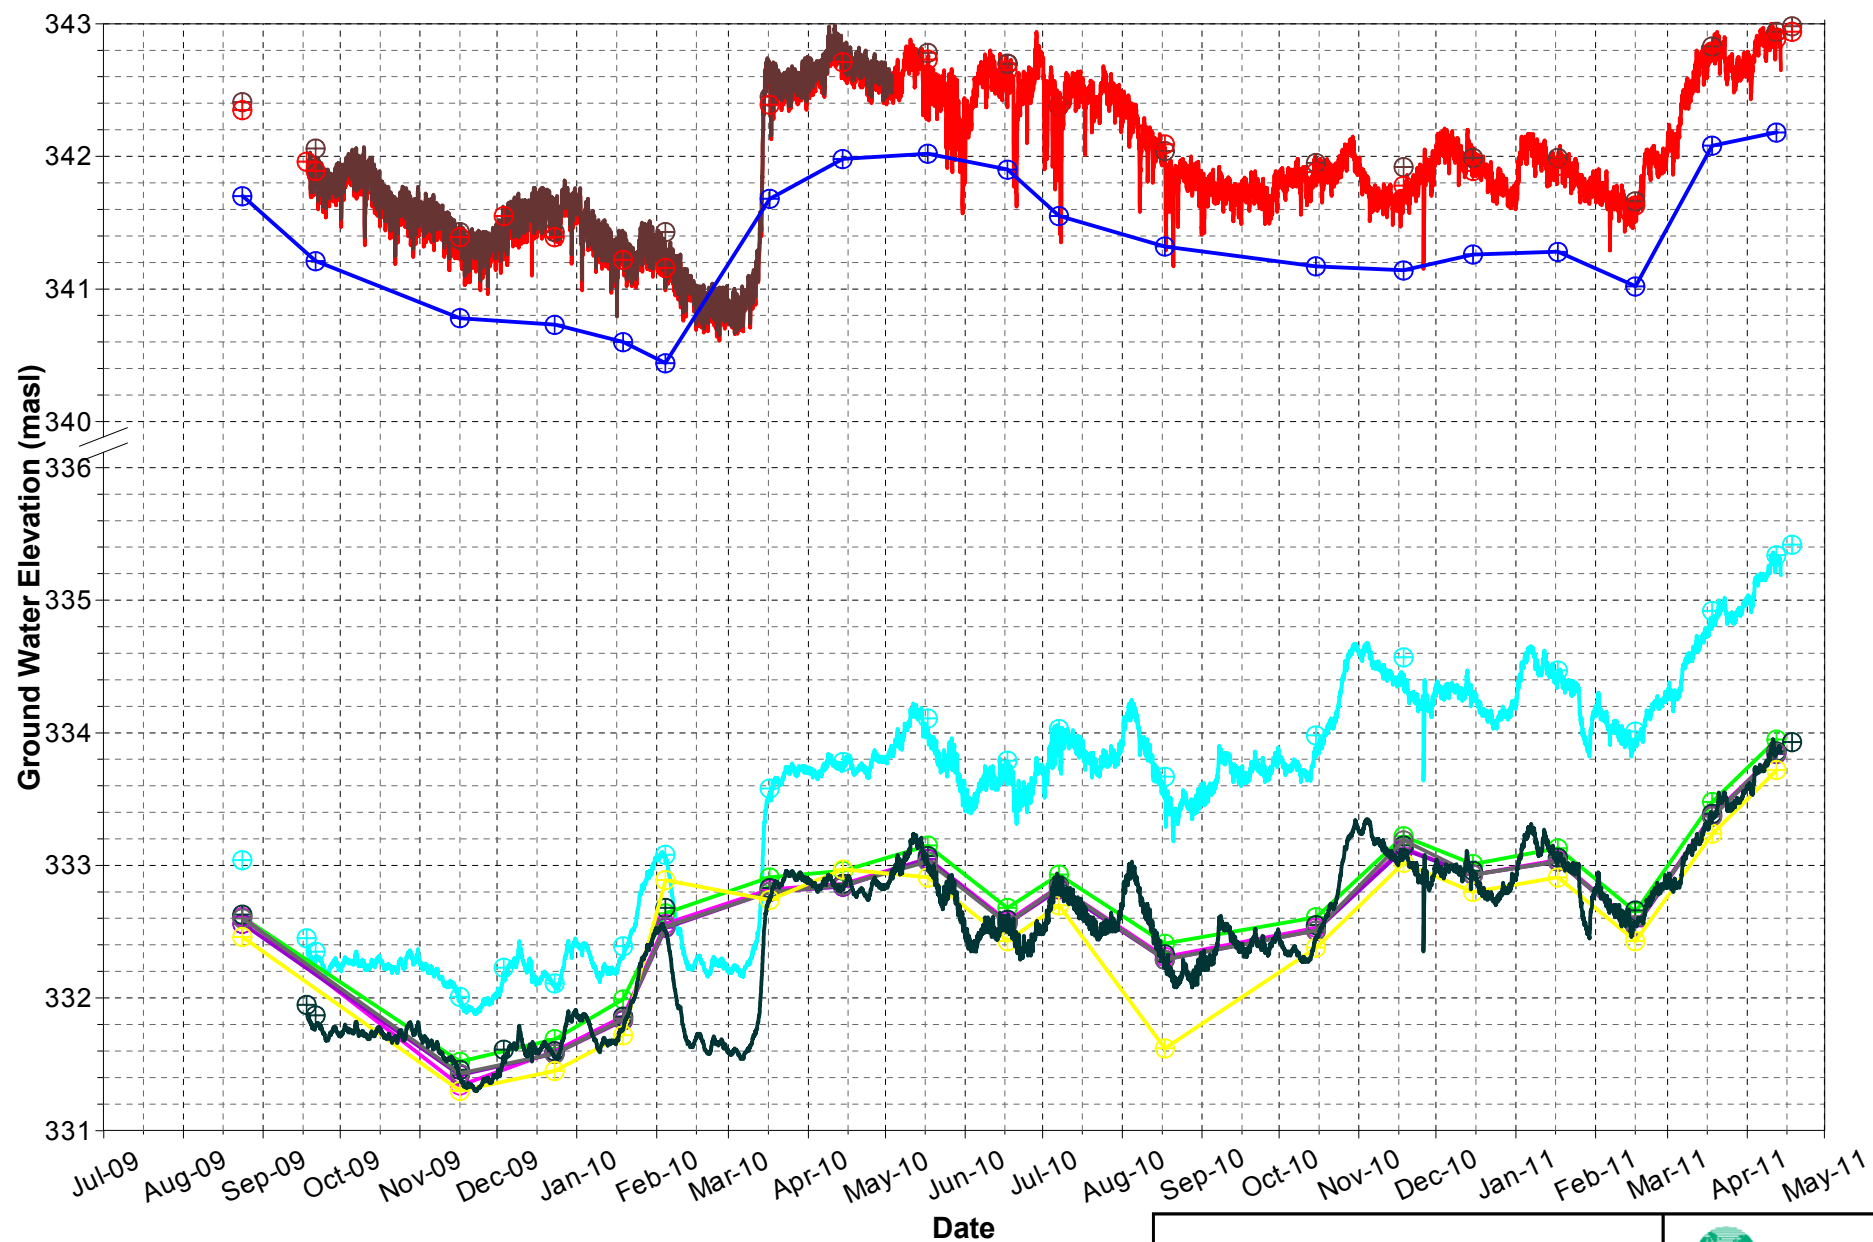

**City of Guelph
Tier Three Assessment
Water Level Monitoring**

MW08-T3-08 (Kaine Hill Dr)
Hydrographs



DRAWN: JLH


APPROVED: JAP

DATE: April 2011

PROJECT NUMBER: 08-1112-021

FIGURE: C19

- | | | |
|----------------|----------------|-----------------|
| ⊕ MW08-T3-08-1 | ⊕ MW08-T3-08-5 | ⊕ MW08-T3-08-8 |
| ⊕ MW08-T3-08-2 | ⊕ MW08-T3-08-6 | ⊕ MW08-T3-08-9 |
| ⊕ MW08-T3-08-3 | ⊕ MW08-T3-08-7 | ⊕ MW08-T3-08-0B |
| ⊕ MW08-T3-08-4 | | |

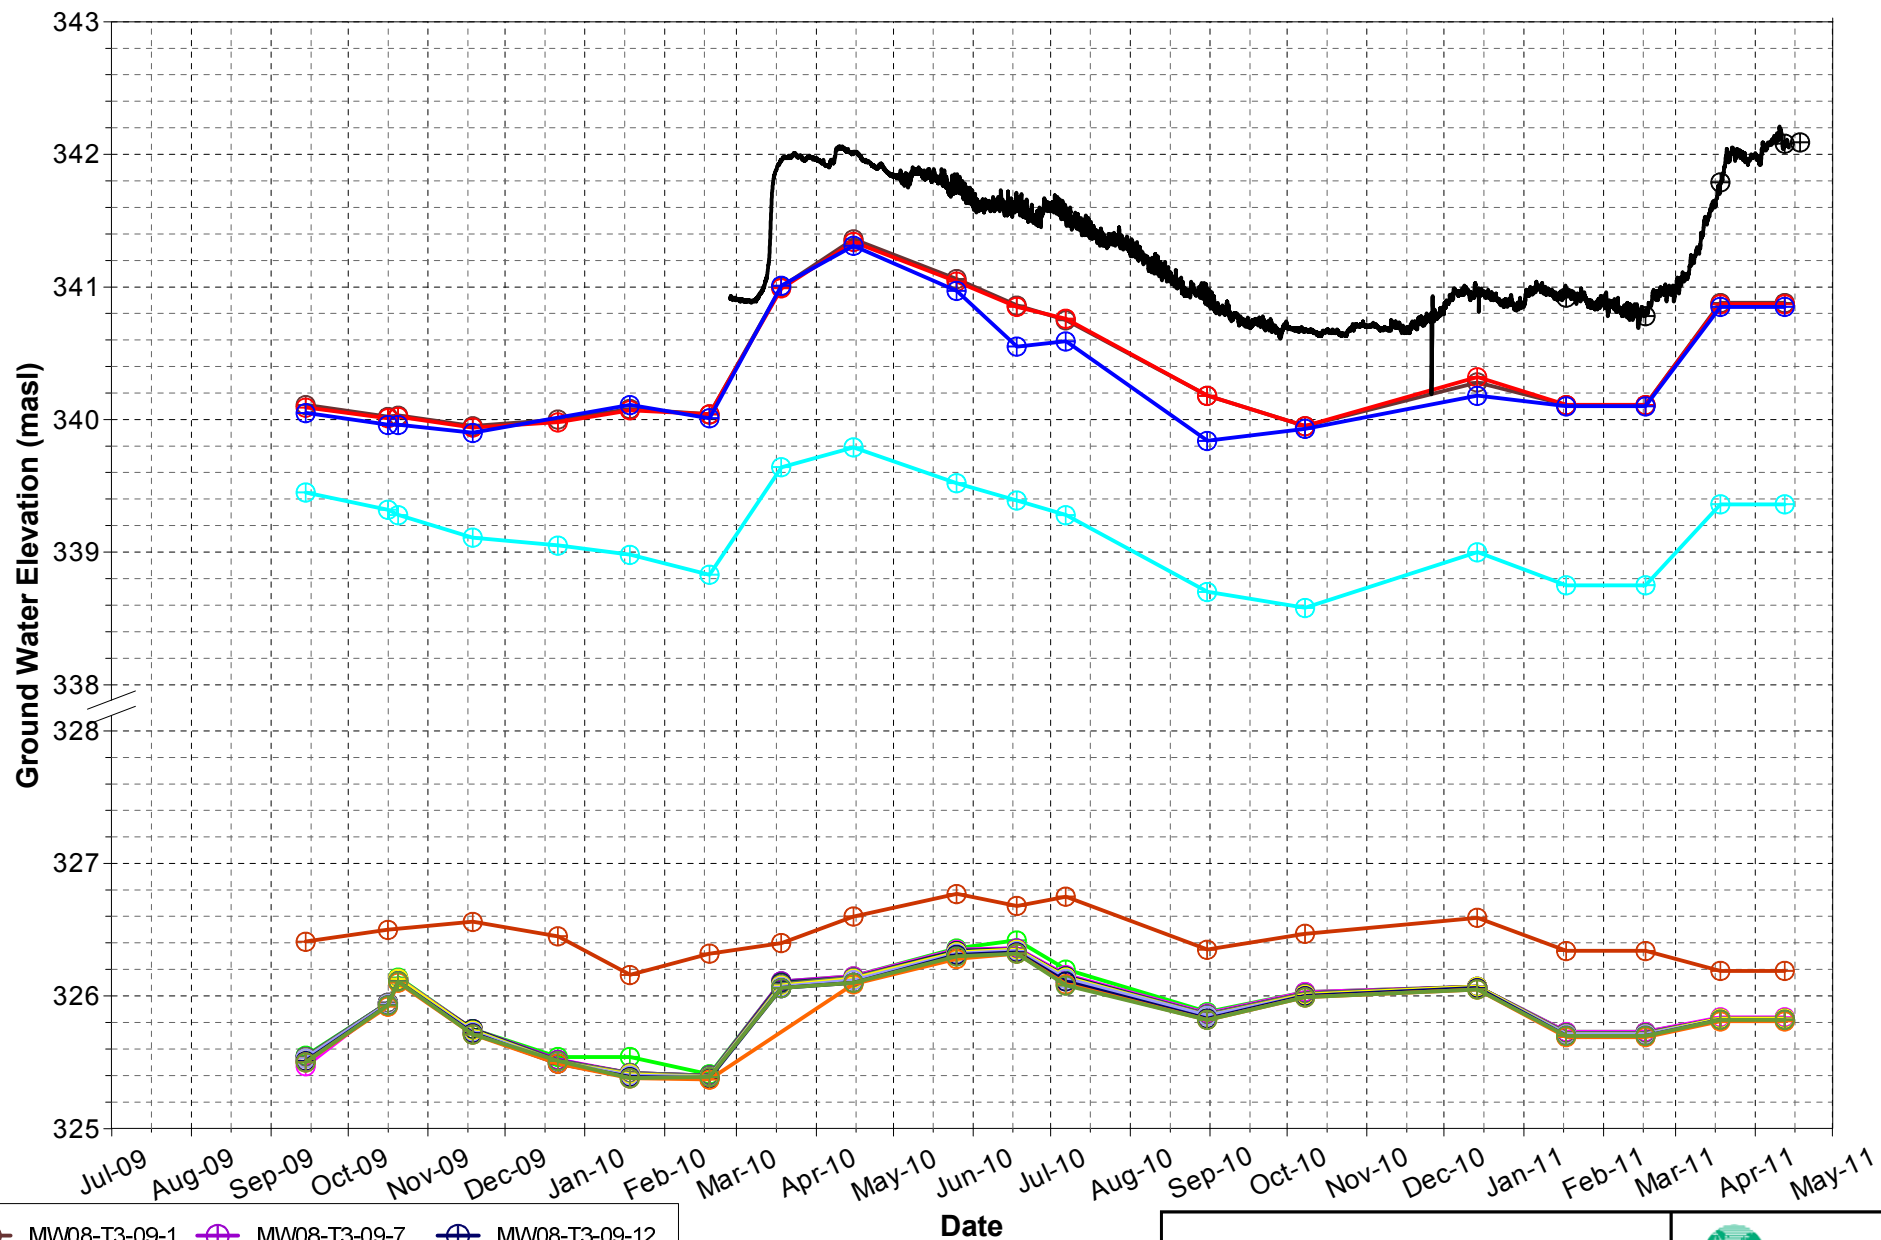


**City of Guelph
Tier Three Assessment
Water Level Monitoring**

MW08-T3-09 (Crawford Tract)
Hydrographs



DRAWN: JLH	APPROVED: JAP	DATE: April 2011
PROJECT NUMBER: 08-1112-021		FIGURE: C20

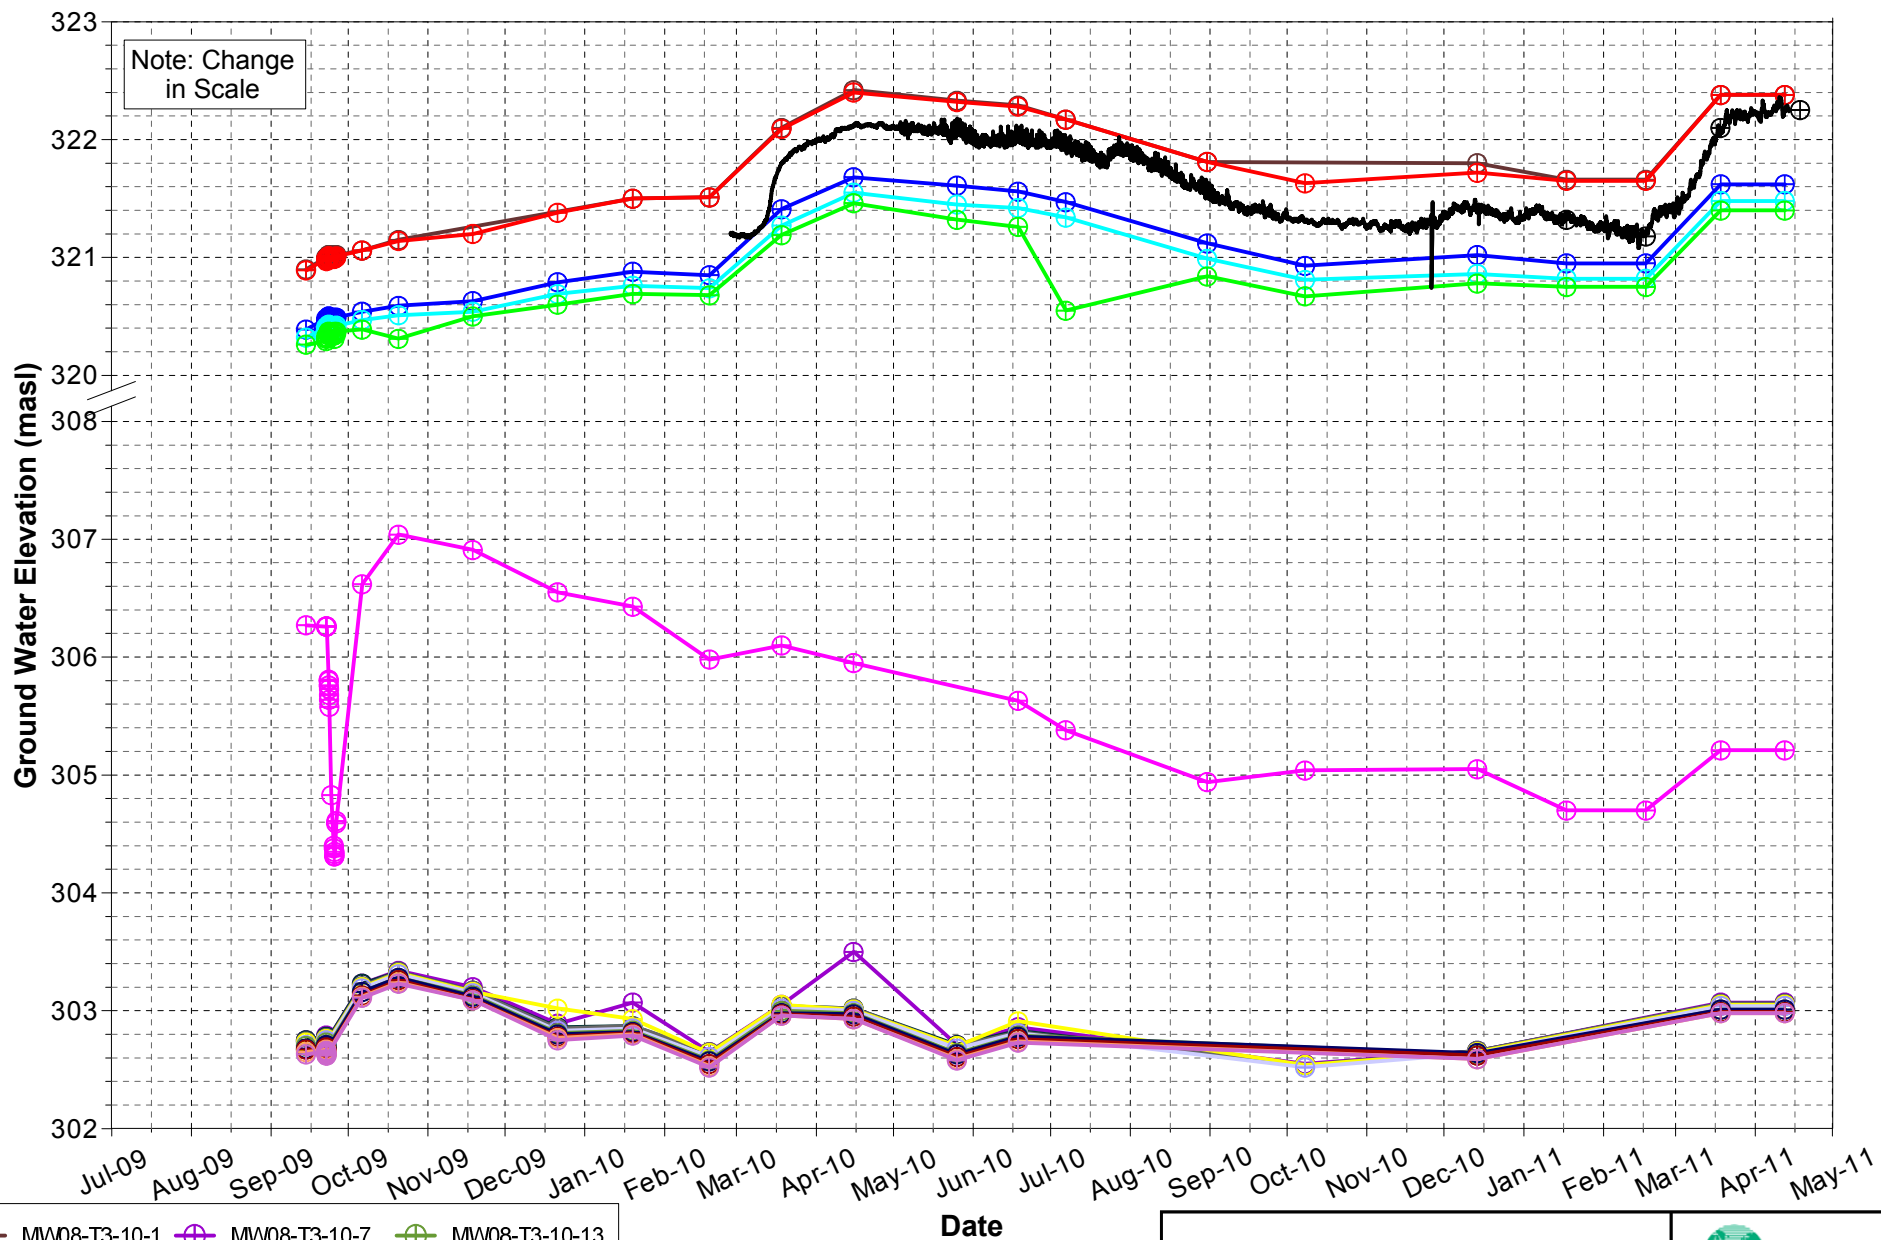

- MW08-T3-10-1 MW08-T3-10-7 MW08-T3-10-13
- MW08-T3-10-2 MW08-T3-10-8 MW08-T3-10-14
- MW08-T3-10-3 MW08-T3-10-9 MW08-T3-10-15
- MW08-T3-10-4 MW08-T3-10-10 MW08-T3-10-16
- MW08-T3-10-5 MW08-T3-10-11 MW08-T3-10-17
- MW08-T3-10-6 MW08-T3-10-12 MW08-T3-10-OB

**City of Guelph
Tier Three Assessment
Water Level Monitoring**

MW08-T3-10 (Vance Tract)
Hydrographs



DRAWN: JLH	APPROVED: JAP	DATE: April 2011
PROJECT NUMBER: 08-1112-021		FIGURE: C21



C8: Water Quality Data

Your Project #: 08-1112-0021
 Site: CITY OF GUELPH
 Your C.O.C. #: 17330701, 173307-0

Attention: Kurt Stamm

Golder Associates Ltd
 Mississauga - Standing Offer
 2390 Argenta Rd
 Mississauga, ON
 L5N 5Z7

Report Date: 2009/12/29

CERTIFICATE OF ANALYSIS

MAXXAM JOB #: A9H1279

Received: 2009/12/18, 12:15

Sample Matrix: Water
 # Samples Received: 9

Analyses	Quantity	Date Extracted	Date Analyzed	Laboratory Method	Method Reference
Alkalinity	9	N/A	2009/12/23	CAM SOP-00448	SM 2320B
Carbonate, Bicarbonate and Hydroxide	9	N/A	2009/12/23		
Chloride by Automated Colourimetry	9	N/A	2009/12/23	CAM SOP-00463	SM 4500 Cl E
Conductivity	9	N/A	2009/12/23	CAM SOP-00448	SM 2510
Dissolved Organic Carbon (DOC)	1	N/A	2009/12/23	CAM SOP-00446	SM 5310 B
Dissolved Organic Carbon (DOC)	8	N/A	2009/12/24	CAM SOP-00446	SM 5310 B
Hardness (calculated as CaCO ₃)	9	N/A	2009/12/23	CAM SOP 00102	SM 2340 B
Dissolved Metals by ICPMS	9	N/A	2009/12/23	CAM SOP-00447	EPA 6020
Ion Balance (% Difference)	9	N/A	2009/12/23		
Anion and Cation Sum	9	N/A	2009/12/23		
Ammonia-N	9	N/A	2009/12/23	CAM SOP-00441	US GS I-2522-90
Nitrate (NO ₃) and Nitrite (NO ₂) in Water @	9	N/A	2009/12/23	CAM SOP-00440	SM 4500 NO ₃ /NO ₂ B
pH	9	N/A	2009/12/23	CAM SOP-00448	SM 4500H
Orthophosphate	8	N/A	2009/12/23	CAM SOP-00461	SM 4500 P-F
Orthophosphate	1	N/A	2009/12/29	CAM SOP-00461	SM 4500 P-F
Sat. pH and Langelier Index (@ 20C)	9	N/A	2009/12/23		
Sat. pH and Langelier Index (@ 4C)	9	N/A	2009/12/23		
Sulphate by Automated Colourimetry	9	N/A	2009/12/23	CAM SOP-00464	EPA 375.4
Total Dissolved Solids (TDS calc)	9	N/A	2009/12/23		

* RPDs calculated using raw data. The rounding of final results may result in the apparent difference.

* Results relate only to the items tested.

(1) Values for calculated parameters may not appear to add up due to rounding of raw data and significant figures.

Encryption Key

Please direct all questions regarding this Certificate of Analysis to your Project Manager.

CHRISTINE MCLEAN, Project Manager
 Email: christine.mclean@maxxamanalytics.com
 Phone# (905) 817-5700

Maxxam has procedures in place to guard against improper use of the electronic signature and have the required "signatories", as per section

Maxxam Job #: A9H1279
Report Date: 2009/12/29

Golder Associates Ltd
Client Project #: 08-1112-0021
Project name: CITY OF GUELPH
Sampler Initials: JH

-2-

5.10.2 of ISO/IEC 17025:2005(E), signing the reports. SCC and CALA have approved this reporting process and electronic report format.

For Service Group specific validation please refer to the Validation Signature Page

Total cover pages: 2

Page 2 of 12

Maxxam Job #: A9H1279
Report Date: 2009/12/29

Golder Associates Ltd
Client Project #: 08-1112-0021
Project name: CITY OF GUELPH
Sampler Initials: JH

RCAP - COMPREHENSIVE (WATER)

Maxxam ID		ER6596	ER6596		ER6597		ER6598		
Sampling Date		2009/12/07 14:42	2009/12/07 14:42		2009/12/07 14:05		2009/12/07 13:20		
	Units	MW08-T3-01 CS	MW08-T3-01 CS Lab-Dup	QC Batch	MW08-T3-01 (3)	QC Batch	MW08-T3-01 (6)	RDL	QC Batch
Calculated Parameters									
Anion Sum	me/L	10.2		2040245	8.71	2040245	9.87	N/A	2040245
Bicarb. Alkalinity (calc. as CaCO ₃)	mg/L	269		2040243	331	2040243	259	1	2040243
Calculated TDS	mg/L	543		2040248	464	2040248	537	1	2040248
Carb. Alkalinity (calc. as CaCO ₃)	mg/L	2		2040243	2	2040243	2	1	2040243
Cation Sum	me/L	10.7		2040245	9.42	2040245	10.1	N/A	2040245
Hardness (CaCO ₃)	mg/L	470		2039966	410	2040680	450	1	2040680
Ion Balance (% Difference)	%	2.61		2040244	3.92	2040244	1.20	N/A	2040244
Langelier Index (@ 20C)	N/A	0.908		2040246	0.923	2040246	0.924		2040246
Langelier Index (@ 4C)	N/A	0.660		2040247	0.675	2040247	0.677		2040247
Saturation pH (@ 20C)	N/A	7.00		2040246	6.92	2040246	7.04		2040246
Saturation pH (@ 4C)	N/A	7.25		2040247	7.17	2040247	7.29		2040247
Inorganics									
Total Ammonia-N	mg/L	0.29		2043582	0.79	2043582	0.35	0.05	2043582
Conductivity	umho/cm	996	1000	2043343	804	2043119	951	1	2043355
Dissolved Organic Carbon	mg/L	1.1		2044408	1.0	2044408	1.3	0.2	2044408
Orthophosphate (P)	mg/L	<0.01		2043042	<0.01	2043059	<0.01	0.01	2043042
pH	pH	7.9	8.0	2043337	7.8	2043110	8.0		2043354
Dissolved Sulphate (SO ₄)	mg/L	37		2043043	32	2043061	96	1	2043043
Alkalinity (Total as CaCO ₃)	mg/L	271	270	2043344	333	2043120	261	1	2043356
Dissolved Chloride (Cl)	mg/L	140		2043030	49	2043047	94	1	2043030
Nitrite (N)	mg/L	<0.01		2043001	<0.01	2043001	<0.01	0.01	2042991
Nitrate (N)	mg/L	<0.1		2043001	0.3	2043001	<0.1	0.1	2042991
Nitrate + Nitrite	mg/L	<0.1		2043001	0.3	2043001	<0.1	0.1	2042991

N/A = Not Applicable

RDL = Reportable Detection Limit

QC Batch = Quality Control Batch

Maxxam Job #: A9H1279
Report Date: 2009/12/29

Golder Associates Ltd
Client Project #: 08-1112-0021
Project name: CITY OF GUELPH
Sampler Initials: JH

RCAP - COMPREHENSIVE (WATER)

Maxxam ID		ER6596	ER6596		ER6597		ER6598		
Sampling Date		2009/12/07 14:42	2009/12/07 14:42		2009/12/07 14:05		2009/12/07 13:20		
	Units	MW08-T3-01 CS	MW08-T3-01 CS Lab-Dup	QC Batch	MW08-T3-01 (3)	QC Batch	MW08-T3-01 (6)	RDL	QC Batch
Metals									
Dissolved Aluminum (Al)	ug/L	<5	<5	2043686	<5	2043686	7	5	2043686
Dissolved Antimony (Sb)	ug/L	0.7	<0.5	2043686	1.0	2043686	0.6	0.5	2043686
Dissolved Arsenic (As)	ug/L	1	1	2043686	<1	2043686	<1	1	2043686
Dissolved Barium (Ba)	ug/L	20	20	2043686	30	2043686	68	5	2043686
Dissolved Beryllium (Be)	ug/L	<0.5	<0.5	2043686	<0.5	2043686	<0.5	0.5	2043686
Dissolved Bismuth (Bi)	ug/L	<1	<1	2043686	<1	2043686	<1	1	2043686
Dissolved Boron (B)	ug/L	35	33	2043686	17	2043686	50	10	2043686
Dissolved Cadmium (Cd)	ug/L	<0.1	<0.1	2043686	<0.1	2043686	<0.1	0.1	2043686
Dissolved Calcium (Ca)	ug/L	110000	110000	2043686	110000	2043686	110000	200	2043686
Dissolved Chromium (Cr)	ug/L	<5	<5	2043686	<5	2043686	<5	5	2043686
Dissolved Cobalt (Co)	ug/L	2.0	2.0	2043686	4.3	2043686	3.7	0.5	2043686
Dissolved Copper (Cu)	ug/L	<1	<1	2043686	<1	2043686	<1	1	2043686
Dissolved Iron (Fe)	ug/L	940	930	2043686	7900	2043686	350	100	2043686
Dissolved Lead (Pb)	ug/L	<0.5	<0.5	2043686	<0.5	2043686	<0.5	0.5	2043686
Dissolved Magnesium (Mg)	ug/L	46000	47000	2043686	36000	2043686	45000	50	2043686
Dissolved Manganese (Mn)	ug/L	22	23	2043686	170	2043686	25	2	2043686
Dissolved Molybdenum (Mo)	ug/L	1	1	2043686	1	2043686	<1	1	2043686
Dissolved Nickel (Ni)	ug/L	<1	<1	2043686	2	2043686	<1	1	2043686
Dissolved Phosphorus (P)	ug/L	<100	<100	2043686	<100	2043686	<100	100	2043686
Dissolved Potassium (K)	ug/L	2100	2100	2043686	1100	2043686	2200	200	2043686
Dissolved Selenium (Se)	ug/L	<2	<2	2043686	<2	2043686	<2	2	2043686
Dissolved Silicon (Si)	ug/L	6100	6100	2043686	5600	2043686	6000	50	2043686
Dissolved Silver (Ag)	ug/L	<0.1	<0.1	2043686	<0.1	2043686	<0.1	0.1	2043686
Dissolved Sodium (Na)	ug/L	30000	30000	2043686	19000	2043686	25000	100	2043686
Dissolved Strontium (Sr)	ug/L	2800	2800	2043686	970	2043686	25000	1	2043686
Dissolved Thallium (Tl)	ug/L	<0.05	<0.05	2043686	<0.05	2043686	<0.05	0.05	2043686
Dissolved Titanium (Ti)	ug/L	<5	<5	2043686	<5	2043686	<5	5	2043686
Dissolved Uranium (U)	ug/L	1.1	1.1	2043686	0.7	2043686	0.4	0.1	2043686
Dissolved Vanadium (V)	ug/L	<1	<1	2043686	<1	2043686	<1	1	2043686
Dissolved Zinc (Zn)	ug/L	<5	<5	2043686	<5	2043686	<5	5	2043686

RDL = Reportable Detection Limit
QC Batch = Quality Control Batch

Maxxam Job #: A9H1279
Report Date: 2009/12/29

Golder Associates Ltd
Client Project #: 08-1112-0021
Project name: CITY OF GUELPH
Sampler Initials: JH

RCAP - COMPREHENSIVE (WATER)

Maxxam ID		ER6599			ER6600		ER6601		
Sampling Date		2009/12/15 15:25			2009/12/15 14:40		2009/12/15 13:40		
	Units	MW08-T3-05 CS	RDL	QC Batch	MW08-T3-05 (4)	QC Batch	MW08-T3-05 (7)	RDL	QC Batch
Calculated Parameters									
Anion Sum	me/L	19.7	N/A	2040245	28.1	2040245	31.0	N/A	2040245
Bicarb. Alkalinity (calc. as CaCO ₃)	mg/L	165	1	2040243	173	2040243	155	1	2040243
Calculated TDS	mg/L	1290	1	2040248	1840	2040248	2030	1	2040248
Carb. Alkalinity (calc. as CaCO ₃)	mg/L	1	1	2040243	1	2040243	<1	1	2040243
Cation Sum	me/L	21.6	N/A	2040245	30.2	2040245	31.7	N/A	2040245
Hardness (CaCO ₃)	mg/L	1000	1	2040680	1400	2040680	1500	1	2040680
Ion Balance (% Difference)	%	4.60	N/A	2040244	3.64	2040244	1.19	N/A	2040244
Langelier Index (@ 20C)	N/A	0.975		2040246	1.01	2040246	0.840		2040246
Langelier Index (@ 4C)	N/A	0.730		2040247	0.764	2040247	0.597		2040247
Saturation pH (@ 20C)	N/A	6.89		2040246	6.79	2040246	6.78		2040246
Saturation pH (@ 4C)	N/A	7.14		2040247	7.03	2040247	7.02		2040247
Inorganics									
Total Ammonia-N	mg/L	0.20	0.05	2043582	0.23	2043582	0.26	0.05	2043582
Conductivity	umho/cm	1670	1	2043355	2180	2043343	2340	1	2043119
Dissolved Organic Carbon	mg/L	1.2	0.2	2044408	1.9	2044408	1.2	0.2	2044408
Orthophosphate (P)	mg/L	<0.01	0.01	2043042	<0.01	2043042	<0.01	0.01	2043042
pH	pH	7.9		2043354	7.8	2043337	7.6		2043110
Dissolved Sulphate (SO ₄)	mg/L	780	10	2043043	1200	2043043	1300	10	2043043
Alkalinity (Total as CaCO ₃)	mg/L	166	1	2043356	174	2043344	156	1	2043120
Dissolved Chloride (Cl)	mg/L	9	1	2043030	15	2043030	16	1	2043030
Nitrite (N)	mg/L	<0.01	0.01	2043001	<0.01	2043001	<0.01	0.01	2042991
Nitrate (N)	mg/L	<0.1	0.1	2043001	<0.1	2043001	<0.1	0.1	2042991
Nitrate + Nitrite	mg/L	<0.1	0.1	2043001	<0.1	2043001	<0.1	0.1	2042991

N/A = Not Applicable
RDL = Reportable Detection Limit
QC Batch = Quality Control Batch

Maxxam Job #: A9H1279
Report Date: 2009/12/29

Golder Associates Ltd
Client Project #: 08-1112-0021
Project name: CITY OF GUELPH
Sampler Initials: JH

RCAP - COMPREHENSIVE (WATER)

Maxxam ID		ER6599			ER6600		ER6601		
Sampling Date		2009/12/15 15:25			2009/12/15 14:40		2009/12/15 13:40		
	Units	MW08-T3-05 CS	RDL	QC Batch	MW08-T3-05 (4)	QC Batch	MW08-T3-05 (7)	RDL	QC Batch
Metals									
Dissolved Aluminum (Al)	ug/L	<5	5	2043686	<5	2043686	<5	5	2043686
Dissolved Antimony (Sb)	ug/L	<0.5	0.5	2043686	<0.5	2043686	<0.5	0.5	2043686
Dissolved Arsenic (As)	ug/L	5	1	2043686	2	2043686	1	1	2043686
Dissolved Barium (Ba)	ug/L	8	5	2043686	8	2043686	7	5	2043686
Dissolved Beryllium (Be)	ug/L	<0.5	0.5	2043686	<0.5	2043686	<0.5	0.5	2043686
Dissolved Bismuth (Bi)	ug/L	<1	1	2043686	<1	2043686	<1	1	2043686
Dissolved Boron (B)	ug/L	85	10	2043686	110	2043686	110	10	2043686
Dissolved Cadmium (Cd)	ug/L	<0.1	0.1	2043686	<0.1	2043686	<0.1	0.1	2043686
Dissolved Calcium (Ca)	ug/L	300000	200	2043686	400000	2043686	470000	200	2043686
Dissolved Chromium (Cr)	ug/L	<5	5	2043686	<5	2043686	<5	5	2043686
Dissolved Cobalt (Co)	ug/L	0.7	0.5	2043686	<3 ₍₁₎	2043686	<3 ₍₁₎	3	2043686
Dissolved Copper (Cu)	ug/L	<1	1	2043686	<1	2043686	<1	1	2043686
Dissolved Iron (Fe)	ug/L	1500	100	2043686	1800	2043686	1100	100	2043686
Dissolved Lead (Pb)	ug/L	<0.5	0.5	2043686	<0.5	2043686	<0.5	0.5	2043686
Dissolved Magnesium (Mg)	ug/L	65000	50	2043686	100000	2043686	81000	50	2043686
Dissolved Manganese (Mn)	ug/L	29	2	2043686	17	2043686	31	2	2043686
Dissolved Molybdenum (Mo)	ug/L	3	1	2043686	5	2043686	4	1	2043686
Dissolved Nickel (Ni)	ug/L	<1	1	2043686	<5 ₍₁₎	2043686	<5 ₍₁₎	5	2043686
Dissolved Phosphorus (P)	ug/L	<100	100	2043686	<100	2043686	<100	100	2043686
Dissolved Potassium (K)	ug/L	2200	200	2043686	3000	2043686	3100	200	2043686
Dissolved Selenium (Se)	ug/L	<2	2	2043686	<2	2043686	<2	2	2043686
Dissolved Silicon (Si)	ug/L	5800	50	2043686	5600	2043686	5100	50	2043686
Dissolved Silver (Ag)	ug/L	<0.1	0.1	2043686	<0.1	2043686	<0.1	0.1	2043686
Dissolved Sodium (Na)	ug/L	30000	100	2043686	35000	2043686	28000	100	2043686
Dissolved Strontium (Sr)	ug/L	4600	1	2043686	7600	2043686	8700	1	2043686
Dissolved Thallium (Tl)	ug/L	<0.05	0.05	2043686	<0.05	2043686	<0.05	0.05	2043686
Dissolved Titanium (Ti)	ug/L	<5	5	2043686	<5	2043686	<5	5	2043686
Dissolved Uranium (U)	ug/L	1.9	0.1	2043686	0.9	2043686	0.5	0.1	2043686
Dissolved Vanadium (V)	ug/L	<1	1	2043686	<1	2043686	<1	1	2043686
Dissolved Zinc (Zn)	ug/L	<30 ₍₁₎	30	2043686	<30 ₍₁₎	2043686	<30 ₍₁₎	30	2043686

RDL = Reportable Detection Limit

QC Batch = Quality Control Batch

(1) - Detection Limit was raised due to matrix interferences.

Maxxam Job #: A9H1279
Report Date: 2009/12/29

Golder Associates Ltd
Client Project #: 08-1112-0021
Project name: CITY OF GUELPH
Sampler Initials: JH

RCAP - COMPREHENSIVE (WATER)

Maxxam ID		ER6602		ER6603	ER6603			ER6604		
Sampling Date		2009/12/08 12:20		2009/12/08 12:45	2009/12/08 12:45			2009/12/08 12:15		
	Units	MW08-T3-06 CS	QC Batch	MW08-T3-06 (4)	MW08-T3-06 (4) Lab-Dup	RDL	QC Batch	MW08-T3-06 (6)	RDL	QC Batch
Calculated Parameters										
Anion Sum	me/L	15.2	2040245	8.34		N/A	2040245	22.9	N/A	2040245
Bicarb. Alkalinity (calc. as CaCO ₃)	mg/L	291	2040243	257		1	2040243	176	1	2040243
Calculated TDS	mg/L	916	2040248	466		1	2040248	1510	1	2040248
Carb. Alkalinity (calc. as CaCO ₃)	mg/L	3	2040243	2		1	2040243	1	1	2040243
Cation Sum	me/L	15.6	2040245	8.92		N/A	2040245	25.1	N/A	2040245
Hardness (CaCO ₃)	mg/L	570	2040680	430		1	2040680	1200	1	2040680
Ion Balance (% Difference)	%	1.15	2040244	3.36		N/A	2040244	4.63	N/A	2040244
Langelier Index (@ 20C)	N/A	1.22	2040246	0.904			2040246	1.02		2040246
Langelier Index (@ 4C)	N/A	0.973	2040247	0.656			2040247	0.779		2040247
Saturation pH (@ 20C)	N/A	6.85	2040246	7.02			2040246	6.79		2040246
Saturation pH (@ 4C)	N/A	7.10	2040247	7.27			2040247	7.03		2040247
Inorganics										
Total Ammonia-N	mg/L	0.05	2043582	0.09	0.14	0.05	2043582	0.28	0.05	2043582
Conductivity	umho/cm	1340	2043343	747		1	2043312	1890	1	2043355
Dissolved Organic Carbon	mg/L	4.5	2044408	1.1		0.2	2044319	0.7	0.2	2044408
Orthophosphate (P)	mg/L	<0.01	2043022	<0.01		0.01	2044554	<0.01	0.01	2043042
pH	pH	8.1	2043337	7.9			2043311	7.8		2043354
Dissolved Sulphate (SO ₄)	mg/L	350	2043023	140		1	2043131	900	10	2043043
Alkalinity (Total as CaCO ₃)	mg/L	295	2043344	259		1	2043313	177	1	2043356
Dissolved Chloride (Cl)	mg/L	67	2043020	5		1	2043129	22	1	2043030
Nitrite (N)	mg/L	0.01	2043001	<0.01	<0.01	0.01	2042991	<0.01	0.01	2043001
Nitrate (N)	mg/L	1.4	2043001	<0.1	<0.1	0.1	2042991	<0.1	0.1	2043001
Nitrate + Nitrite	mg/L	1.4	2043001	<0.1	<0.1	0.1	2042991	<0.1	0.1	2043001

N/A = Not Applicable

RDL = Reportable Detection Limit

QC Batch = Quality Control Batch

Maxxam Job #: A9H1279
Report Date: 2009/12/29

Golder Associates Ltd
Client Project #: 08-1112-0021
Project name: CITY OF GUELPH
Sampler Initials: JH

RCAP - COMPREHENSIVE (WATER)

Maxxam ID		ER6602		ER6603	ER6603			ER6604		
Sampling Date		2009/12/08 12:20		2009/12/08 12:45	2009/12/08 12:45			2009/12/08 12:15		
	Units	MW08-T3-06 CS	QC Batch	MW08-T3-06 (4)	MW08-T3-06 (4) Lab-Dup	RDL	QC Batch	MW08-T3-06 (6)	RDL	QC Batch
Metals										
Dissolved Aluminum (Al)	ug/L	<5	2043686	<5		5	2043686	<5	5	2043686
Dissolved Antimony (Sb)	ug/L	0.6	2043686	<0.5		0.5	2043686	<0.5	0.5	2043686
Dissolved Arsenic (As)	ug/L	<1	2043686	<1		1	2043686	1	1	2043686
Dissolved Barium (Ba)	ug/L	29	2043686	36		5	2043686	21	5	2043686
Dissolved Beryllium (Be)	ug/L	<0.5	2043686	<0.5		0.5	2043686	<0.5	0.5	2043686
Dissolved Bismuth (Bi)	ug/L	<1	2043686	<1		1	2043686	<1	1	2043686
Dissolved Boron (B)	ug/L	130	2043686	33		10	2043686	110	10	2043686
Dissolved Cadmium (Cd)	ug/L	<0.1	2043686	<0.1		0.1	2043686	<0.1	0.1	2043686
Dissolved Calcium (Ca)	ug/L	170000	2043686	110000		200	2043686	370000	200	2043686
Dissolved Chromium (Cr)	ug/L	<5	2043686	<5		5	2043686	<5	5	2043686
Dissolved Cobalt (Co)	ug/L	4.3	2043686	2.2		0.5	2043686	<3 ⁽¹⁾	3	2043686
Dissolved Copper (Cu)	ug/L	3	2043686	<1		1	2043686	<1	1	2043686
Dissolved Iron (Fe)	ug/L	<100	2043686	310		100	2043686	2000	100	2043686
Dissolved Lead (Pb)	ug/L	<0.5	2043686	<0.5		0.5	2043686	<0.5	0.5	2043686
Dissolved Magnesium (Mg)	ug/L	39000	2043686	39000		50	2043686	61000	50	2043686
Dissolved Manganese (Mn)	ug/L	200	2043686	11		2	2043686	25	2	2043686
Dissolved Molybdenum (Mo)	ug/L	8	2043686	3		1	2043686	5	1	2043686
Dissolved Nickel (Ni)	ug/L	4	2043686	<1		1	2043686	<5 ⁽¹⁾	5	2043686
Dissolved Phosphorus (P)	ug/L	<100	2043686	<100		100	2043686	<100	100	2043686
Dissolved Potassium (K)	ug/L	8200	2043686	1400		200	2043686	3500	200	2043686
Dissolved Selenium (Se)	ug/L	<2	2043686	<2		2	2043686	<2	2	2043686
Dissolved Silicon (Si)	ug/L	5100	2043686	2800		50	2043686	5600	50	2043686
Dissolved Silver (Ag)	ug/L	<0.1	2043686	<0.1		0.1	2043686	<0.1	0.1	2043686
Dissolved Sodium (Na)	ug/L	91000	2043686	7300		100	2043686	29000	100	2043686
Dissolved Strontium (Sr)	ug/L	2200	2043686	1000		1	2043686	7400	1	2043686
Dissolved Thallium (Tl)	ug/L	<0.05	2043686	<0.05		0.05	2043686	<0.05	0.05	2043686
Dissolved Titanium (Ti)	ug/L	<5	2043686	<5		5	2043686	<5	5	2043686
Dissolved Uranium (U)	ug/L	0.9	2043686	0.2		0.1	2043686	0.2	0.1	2043686
Dissolved Vanadium (V)	ug/L	<1	2043686	<1		1	2043686	<1	1	2043686
Dissolved Zinc (Zn)	ug/L	8	2043686	<5		5	2043686	<30 ⁽¹⁾	30	2043686

RDL = Reportable Detection Limit

QC Batch = Quality Control Batch

(1) - Detection Limit was raised due to matrix interferences.

Maxxam Job #: A9H1279
Report Date: 2009/12/29

Golder Associates Ltd
Client Project #: 08-1112-0021
Project name: CITY OF GUELPH
Sampler Initials: JH

Package 1	0.0°C
-----------	-------

Each temperature is the average of up to three cooler temperatures taken at receipt

GENERAL COMMENTS

Maxxam Job #: A9H1279
Report Date: 2009/12/29

Golder Associates Ltd
Client Project #: 08-1112-0021
Project name: CITY OF GUELPH
Sampler Initials: JH

QUALITY ASSURANCE REPORT

QC Batch	Parameter	Date	Matrix Spike		Spiked Blank		Method Blank		RPD		QC Standard	
			% Recovery	QC Limits	% Recovery	QC Limits	Value	Units	Value (%)	QC Limits	% Recovery	QC Limits
2042991	Nitrite (N)	2009/12/23	102	75 - 125	103	80 - 120	<0.01	mg/L	NC	25		
2042991	Nitrate (N)	2009/12/23	102	75 - 125	103	80 - 120	<0.1	mg/L	NC	25		
2042991	Nitrate + Nitrite	2009/12/23					<0.1	mg/L	NC	25		
2043001	Nitrite (N)	2009/12/23	102	75 - 125	104	80 - 120	<0.01	mg/L				
2043001	Nitrate (N)	2009/12/23	99	75 - 125	103	80 - 120	<0.1	mg/L	NC	25		
2043001	Nitrate + Nitrite	2009/12/23					<0.1	mg/L				
2043020	Dissolved Chloride (Cl)	2009/12/23	95	75 - 125	101	80 - 120	<1	mg/L	NC	20		
2043022	Orthophosphate (P)	2009/12/23	105	75 - 125	101	80 - 120	<0.01	mg/L	NC	25		
2043023	Dissolved Sulphate (SO4)	2009/12/23	NC	75 - 125	104	80 - 120	<1	mg/L	1.0	25		
2043030	Dissolved Chloride (Cl)	2009/12/23	96	75 - 125	100	80 - 120	<1	mg/L	NC	20		
2043042	Orthophosphate (P)	2009/12/23	104	75 - 125	101	80 - 120	<0.01	mg/L	NC	25		
2043043	Dissolved Sulphate (SO4)	2009/12/23	118	75 - 125	101	80 - 120	<1	mg/L	1.6	25		
2043047	Dissolved Chloride (Cl)	2009/12/23	NC	75 - 125	101	80 - 120	<1	mg/L	1.4	20		
2043059	Orthophosphate (P)	2009/12/23	105	75 - 125	101	80 - 120	<0.01	mg/L	NC	25		
2043061	Dissolved Sulphate (SO4)	2009/12/23	NC	75 - 125	102	80 - 120	<1	mg/L	0.4	25		
2043119	Conductivity	2009/12/23					<1	umho/cm	0.2	25	101	85 - 115
2043120	Alkalinity (Total as CaCO3)	2009/12/23					<1	mg/L	0.2	25	96	85 - 115
2043129	Dissolved Chloride (Cl)	2009/12/23	NC	75 - 125	103	80 - 120	<1	mg/L	0.5	20		
2043131	Dissolved Sulphate (SO4)	2009/12/23	NC	75 - 125	101	80 - 120	<1	mg/L	1	25		
2043312	Conductivity	2009/12/23					<1	umho/cm	0.2	25	101	85 - 115
2043313	Alkalinity (Total as CaCO3)	2009/12/23					<1	mg/L	0.6	25	95	85 - 115
2043343	Conductivity	2009/12/23					<1	umho/cm	0.5	25	101	85 - 115
2043344	Alkalinity (Total as CaCO3)	2009/12/23					<1	mg/L	0.4	25	94	85 - 115
2043355	Conductivity	2009/12/23					<1	umho/cm	0.3	25	101	85 - 115
2043356	Alkalinity (Total as CaCO3)	2009/12/23					<1	mg/L	0.4	25	98	85 - 115
2043582	Total Ammonia-N	2009/12/23	98	80 - 120	102	80 - 120	<0.05	mg/L	NC	25		
2043686	Dissolved Aluminum (Al)	2009/12/23	103	80 - 120	103	90 - 110	<5	ug/L	NC	25		
2043686	Dissolved Antimony (Sb)	2009/12/23	105	80 - 120	103	90 - 110	<0.5	ug/L	NC	25		
2043686	Dissolved Arsenic (As)	2009/12/23	102	80 - 120	101	90 - 110	<1	ug/L	NC	25		
2043686	Dissolved Barium (Ba)	2009/12/23	99	80 - 120	97	90 - 110	<5	ug/L	NC	25		
2043686	Dissolved Beryllium (Be)	2009/12/23	103	80 - 120	103	90 - 110	<0.5	ug/L	NC	25		
2043686	Dissolved Bismuth (Bi)	2009/12/23	99	80 - 120	98	90 - 110	<1	ug/L	NC	25		
2043686	Dissolved Boron (B)	2009/12/23	109	80 - 120	106	90 - 110	<10	ug/L	NC	25		
2043686	Dissolved Cadmium (Cd)	2009/12/23	102	80 - 120	104	90 - 110	<0.1	ug/L	NC	25		
2043686	Dissolved Calcium (Ca)	2009/12/23	NC	80 - 120	105	90 - 110	<200	ug/L	0.8	25		
2043686	Dissolved Chromium (Cr)	2009/12/23	102	80 - 120	101	90 - 110	<5	ug/L	NC	25		
2043686	Dissolved Cobalt (Co)	2009/12/23	100	80 - 120	100	90 - 110	<0.5	ug/L	NC	25		
2043686	Dissolved Copper (Cu)	2009/12/23	98	80 - 120	96	90 - 110	<1	ug/L	NC	25		
2043686	Dissolved Iron (Fe)	2009/12/23	101	80 - 120	101	90 - 110	<100	ug/L	0.5	25		
2043686	Dissolved Lead (Pb)	2009/12/23	101	80 - 120	101	90 - 110	<0.5	ug/L	NC	25		

Maxxam Job #: A9H1279
Report Date: 2009/12/29

Golder Associates Ltd
Client Project #: 08-1112-0021
Project name: CITY OF GUELPH
Sampler Initials: JH

QUALITY ASSURANCE REPORT

QC Batch	Parameter	Date	Matrix Spike		Spiked Blank		Method Blank		RPD		QC Standard	
			% Recovery	QC Limits	% Recovery	QC Limits	Value	Units	Value (%)	QC Limits	% Recovery	QC Limits
2043686	Dissolved Magnesium (Mg)	2009/12/23	NC	80 - 120	109	90 - 110	<50	ug/L	1.1	25		
2043686	Dissolved Manganese (Mn)	2009/12/23	101	80 - 120	101	90 - 110	<2	ug/L	2.0	25		
2043686	Dissolved Molybdenum (Mo)	2009/12/23	109	80 - 120	104	90 - 110	<1	ug/L	NC	25		
2043686	Dissolved Nickel (Ni)	2009/12/23	96	80 - 120	97	90 - 110	<1	ug/L	NC	25		
2043686	Dissolved Phosphorus (P)	2009/12/23	104	80 - 120	105	90 - 110	<100	ug/L	NC	25		
2043686	Dissolved Potassium (K)	2009/12/23	110	80 - 120	104	90 - 110	<200	ug/L	0.5	25		
2043686	Dissolved Selenium (Se)	2009/12/23	100	80 - 120	103	90 - 110	<2	ug/L	NC	25		
2043686	Dissolved Silicon (Si)	2009/12/23	111	80 - 120	109	90 - 110	<50	ug/L	0.3	25		
2043686	Dissolved Silver (Ag)	2009/12/23	92	80 - 120	102	90 - 110	<0.1	ug/L	NC	25		
2043686	Dissolved Sodium (Na)	2009/12/23	NC	80 - 120	107	90 - 110	<100	ug/L	0.05	25		
2043686	Dissolved Strontium (Sr)	2009/12/23	NC	80 - 120	97	90 - 110	<1	ug/L	0.8	25		
2043686	Dissolved Thallium (Tl)	2009/12/23	101	80 - 120	101	90 - 110	<0.05	ug/L	NC	25		
2043686	Dissolved Titanium (Ti)	2009/12/23	105	80 - 120	101	90 - 110	<5	ug/L	NC	25		
2043686	Dissolved Uranium (U)	2009/12/23	102	80 - 120	101	90 - 110	<0.1	ug/L	0.7	25		
2043686	Dissolved Vanadium (V)	2009/12/23	102	80 - 120	101	90 - 110	<1	ug/L	NC	25		
2043686	Dissolved Zinc (Zn)	2009/12/23	101	80 - 120	102	90 - 110	<5	ug/L	NC	25		
2044319	Dissolved Organic Carbon	2009/12/23	NC	75 - 125	104	75 - 125	<0.2	mg/L	0.3	20		
2044408	Dissolved Organic Carbon	2009/12/24	102	75 - 125	112	75 - 125	<0.2	mg/L	NC	20		
2044554	Orthophosphate (P)	2009/12/29	104	75 - 125	104	80 - 120	<0.01	mg/L	NC	25		

N/A = Not Applicable

RPD = Relative Percent Difference

Duplicate: Paired analysis of a separate portion of the same sample. Used to evaluate the variance in the measurement.

Matrix Spike: A sample to which a known amount of the analyte of interest has been added. Used to evaluate sample matrix interference.

QC Standard: A blank matrix to which a known amount of the analyte has been added. Used to evaluate analyte recovery.

Spiked Blank: A blank matrix to which a known amount of the analyte has been added. Used to evaluate analyte recovery.

Method Blank: A blank matrix containing all reagents used in the analytical procedure. Used to identify laboratory contamination.

NC (Matrix Spike): The recovery in the matrix spike was not calculated. The relative difference between the concentration in the parent sample and the spiked amount was not sufficiently significant to permit a reliable recovery calculation.

NC (RPD): The RPD was not calculated. The level of analyte detected in the parent sample and its duplicate was not sufficiently significant to permit a reliable calculation.

Validation Signature Page

Maxxam Job #: A9H1279

The analytical data and all QC contained in this report were reviewed and validated by the following individual(s).



CRISTINA CARRIERE, Scientific Services

=====
Maxxam has procedures in place to guard against improper use of the electronic signature and have the required "signatories", as per section 5.10.2 of ISO/IEC 17025:2005(E), signing the reports. SCC and CALA have approved this reporting process and electronic report format.

Your Project #: 08-1112-0021
Site: CITY OF GUELPH
Your C.O.C. #: 17330702, 173307-0

Attention: Kurt Stamm

Golder Associates Ltd
Mississauga - Standing Offer
2390 Argenta Rd
Mississauga, ON
L5N 5Z7

Report Date: 2009/12/31

CERTIFICATE OF ANALYSIS

MAXXAM JOB #: A9H2842
Received: 2009/12/22, 13:00

Sample Matrix: Water
Samples Received: 3

Analyses	Quantity	Date Extracted	Date Analyzed	Laboratory Method	Method Reference
Alkalinity	3	N/A	2009/12/29	CAM SOP-00448	SM 2320B
Carbonate, Bicarbonate and Hydroxide	3	N/A	2009/12/30		
Chloride by Automated Colourimetry	3	N/A	2009/12/30	CAM SOP-00463	SM 4500 Cl E
Conductivity	3	N/A	2009/12/29	CAM SOP-00448	SM 2510
Dissolved Organic Carbon (DOC)	3	N/A	2009/12/30	CAM SOP-00446	SM 5310 B
Hardness (calculated as CaCO ₃)	3	N/A	2009/12/30	CAM SOP 00102	SM 2340 B
Dissolved Metals by ICPMS	3	N/A	2009/12/30	CAM SOP-00447	EPA 6020
Ion Balance (% Difference)	3	N/A	2009/12/30		
Anion and Cation Sum	3	N/A	2009/12/30		
Ammonia-N	3	N/A	2009/12/30	CAM SOP-00441	US GS I-2522-90
Nitrate (NO ₃) and Nitrite (NO ₂) in Water	3	N/A	2009/12/30	CAM SOP-00440	SM 4500 NO ₃ /NO ₂ B
pH	3	N/A	2009/12/29	CAM SOP-00448	SM 4500H
Orthophosphate	3	N/A	2009/12/30	CAM SOP-00461	SM 4500 P-F
Sat. pH and Langelier Index (@ 20C)	3	N/A	2009/12/30		
Sat. pH and Langelier Index (@ 4C)	3	N/A	2009/12/30		
Sulphate by Automated Colourimetry	3	N/A	2009/12/30	CAM SOP-00464	EPA 375.4
Total Dissolved Solids (TDS calc)	3	N/A	2009/12/30		

* RPDs calculated using raw data. The rounding of final results may result in the apparent difference.

* Results relate only to the items tested.

(1) Values for calculated parameters may not appear to add up due to rounding of raw data and significant figures.

Encryption Key

Please direct all questions regarding this Certificate of Analysis to your Project Manager.

CHRISTINE MCLEAN, Project Manager
Email: christine.mclean@maxxamanalytics.com
Phone# (905) 817-5700

Maxxam has procedures in place to guard against improper use of the electronic signature and have the required "signatories", as per section 5.10.2 of ISO/IEC 17025:2005(E), signing the reports. SCC and CALA have approved this reporting process and electronic report format.

Maxxam Job #: A9H2842
Report Date: 2009/12/31

Golder Associates Ltd
Client Project #: 08-1112-0021
Project name: CITY OF GUELPH
Sampler Initials: JH

-2-

For Service Group specific validation please refer to the Validation Signature Page

Total cover pages: 2

Maxxam Job #: A9H2842
Report Date: 2009/12/31

Golder Associates Ltd
Client Project #: 08-1112-0021
Project name: CITY OF GUELPH
Sampler Initials: JH

RCAP - COMPREHENSIVE (WATER)

Maxxam ID		ES5264	ES5265	ES5266		
Sampling Date		2009/12/14 10:30	2009/12/14 11:15	2009/12/14 08:50		
	Units	MW08-T3-08 (3)	MW08-T3-08 (7)	MW08-T3-08 (1)	RDL	QC Batch
Calculated Parameters						
Anion Sum	me/L	5.94	7.16	6.58	N/A	2043716
Bicarb. Alkalinity (calc. as CaCO ₃)	mg/L	267	264	294	1	2043714
Calculated TDS	mg/L	307	374	350	1	2043719
Carb. Alkalinity (calc. as CaCO ₃)	mg/L	2	2	2	1	2043714
Cation Sum	me/L	6.01	7.02	7.09	N/A	2043716
Hardness (CaCO ₃)	mg/L	260	320	300	1	2044331
Ion Balance (% Difference)	%	0.550	0.990	3.78	N/A	2043715
Langelier Index (@ 20C)	N/A	0.613	0.692	0.661		2043717
Langelier Index (@ 4C)	N/A	0.364	0.443	0.412		2043718
Saturation pH (@ 20C)	N/A	7.22	7.11	7.11		2043717
Saturation pH (@ 4C)	N/A	7.47	7.36	7.36		2043718
Inorganics						
Total Ammonia-N	mg/L	3.1	0.39	4.9	0.05	2046220
Conductivity	umho/cm	555	658	614	1	2046017
Dissolved Organic Carbon	mg/L	8.3	1.2	9.0	0.2	2046476
Orthophosphate (P)	mg/L	<0.01	<0.01	<0.01	0.01	2046181
pH	pH	7.8	7.8	7.8		2046015
Dissolved Sulphate (SO ₄)	mg/L	<1	58	<1	1	2046180
Alkalinity (Total as CaCO ₃)	mg/L	268	266	296	1	2046001
Dissolved Chloride (Cl)	mg/L	20	22	24	1	2046178
Nitrite (N)	mg/L	<0.01	<0.01	<0.01	0.01	2046188
Nitrate (N)	mg/L	<0.1	<0.1	<0.1	0.1	2046188
Nitrate + Nitrite	mg/L	<0.1	<0.1	<0.1	0.1	2046188

N/A = Not Applicable

RDL = Reportable Detection Limit

QC Batch = Quality Control Batch

Maxxam Job #: A9H2842
Report Date: 2009/12/31

Golder Associates Ltd
Client Project #: 08-1112-0021
Project name: CITY OF GUELPH
Sampler Initials: JH

RCAP - COMPREHENSIVE (WATER)

Maxxam ID		ES5264	ES5265	ES5266		
Sampling Date		2009/12/14 10:30	2009/12/14 11:15	2009/12/14 08:50		
	Units	MW08-T3-08 (3)	MW08-T3-08 (7)	MW08-T3-08 (1)	RDL	QC Batch
Metals						
Dissolved Aluminum (Al)	ug/L	<5	<5	<5	5	2046343
Dissolved Antimony (Sb)	ug/L	<0.5	<0.5	<0.5	0.5	2046343
Dissolved Arsenic (As)	ug/L	40	3	70	1	2046343
Dissolved Barium (Ba)	ug/L	83	110	100	5	2046343
Dissolved Beryllium (Be)	ug/L	<0.5	<0.5	<0.5	0.5	2046343
Dissolved Bismuth (Bi)	ug/L	<1	<1	<1	1	2046343
Dissolved Boron (B)	ug/L	26	35	16	10	2046343
Dissolved Cadmium (Cd)	ug/L	<0.1	<0.1	<0.1	0.1	2046343
Dissolved Calcium (Ca)	ug/L	59000	80000	70000	200	2046343
Dissolved Chromium (Cr)	ug/L	<5	<5	<5	5	2046343
Dissolved Cobalt (Co)	ug/L	<0.5	<0.5	0.5	0.5	2046343
Dissolved Copper (Cu)	ug/L	1	<1	4	1	2046343
Dissolved Iron (Fe)	ug/L	3900	790	7700	100	2046343
Dissolved Lead (Pb)	ug/L	0.6	<0.5	0.6	0.5	2046343
Dissolved Magnesium (Mg)	ug/L	28000	30000	30000	50	2046343
Dissolved Manganese (Mn)	ug/L	21	6	42	2	2046343
Dissolved Molybdenum (Mo)	ug/L	9	<1	10	1	2046343
Dissolved Nickel (Ni)	ug/L	2	<1	3	1	2046343
Dissolved Phosphorus (P)	ug/L	<100	<100	<100	100	2046343
Dissolved Potassium (K)	ug/L	2100	1500	2500	200	2046343
Dissolved Selenium (Se)	ug/L	<2	<2	<2	2	2046343
Dissolved Silicon (Si)	ug/L	9800	4800	11000	50	2046343
Dissolved Silver (Ag)	ug/L	<0.1	<0.1	<0.1	0.1	2046343
Dissolved Sodium (Na)	ug/L	8400	11000	10000	100	2046343
Dissolved Strontium (Sr)	ug/L	160	9000	230	1	2046343
Dissolved Thallium (Tl)	ug/L	<0.05	<0.05	<0.05	0.05	2046343
Dissolved Titanium (Ti)	ug/L	<5	<5	<5	5	2046343
Dissolved Uranium (U)	ug/L	0.1	<0.1	<0.1	0.1	2046343
Dissolved Vanadium (V)	ug/L	<1	<1	<1	1	2046343
Dissolved Zinc (Zn)	ug/L	26	<5	40	5	2046343

RDL = Reportable Detection Limit
QC Batch = Quality Control Batch

Maxxam Job #: A9H2842
Report Date: 2009/12/31

Golder Associates Ltd
Client Project #: 08-1112-0021
Project name: CITY OF GUELPH
Sampler Initials: JH

Package 1	5.3°C
-----------	-------

Each temperature is the average of up to three cooler temperatures taken at receipt

GENERAL COMMENTS

Maxxam Job #: A9H2842
Report Date: 2009/12/31

Golder Associates Ltd
Client Project #: 08-1112-0021
Project name: CITY OF GUELPH
Sampler Initials: JH

QUALITY ASSURANCE REPORT

QC Batch	Parameter	Date	Matrix Spike		Spiked Blank		Method Blank		RPD		QC Standard	
			% Recovery	QC Limits	% Recovery	QC Limits	Value	Units	Value (%)	QC Limits	% Recovery	QC Limits
2046001	Alkalinity (Total as CaCO ₃)	2009/12/29					<1	mg/L	0.3	25	96	85 - 115
2046017	Conductivity	2009/12/29					<1	umho/cm	0.2	25	101	85 - 115
2046178	Dissolved Chloride (Cl)	2009/12/30	NC	75 - 125	105	80 - 120	<1	mg/L	5.3	20		
2046180	Dissolved Sulphate (SO ₄)	2009/12/30	NC	75 - 125	105	80 - 120	<1	mg/L	2.1	25		
2046181	Orthophosphate (P)	2009/12/30	109	75 - 125	102	80 - 120	<0.01	mg/L	NC	25		
2046188	Nitrite (N)	2009/12/30	96	75 - 125	106	80 - 120	<0.01	mg/L				
2046188	Nitrate (N)	2009/12/30	102	75 - 125	106	80 - 120	<0.1	mg/L	NC	25		
2046188	Nitrate + Nitrite	2009/12/30					<0.1	mg/L				
2046220	Total Ammonia-N	2009/12/30	91	80 - 120	99	80 - 120	<0.05	mg/L	7.4	25		
2046343	Dissolved Aluminum (Al)	2009/12/30	100	80 - 120	106	90 - 110	<5	ug/L				
2046343	Dissolved Antimony (Sb)	2009/12/30	106	80 - 120	103	90 - 110	<0.5	ug/L				
2046343	Dissolved Arsenic (As)	2009/12/30	104	80 - 120	98	90 - 110	<1	ug/L				
2046343	Dissolved Barium (Ba)	2009/12/30	103	80 - 120	101	90 - 110	<5	ug/L				
2046343	Dissolved Beryllium (Be)	2009/12/30	103	80 - 120	102	90 - 110	<0.5	ug/L				
2046343	Dissolved Bismuth (Bi)	2009/12/30	98	80 - 120	98	90 - 110	<1	ug/L				
2046343	Dissolved Boron (B)	2009/12/30	101	80 - 120	106	90 - 110	<10	ug/L				
2046343	Dissolved Cadmium (Cd)	2009/12/30	105	80 - 120	101	90 - 110	<0.1	ug/L				
2046343	Dissolved Calcium (Ca)	2009/12/30	NC	80 - 120	103	90 - 110	<200	ug/L				
2046343	Dissolved Chromium (Cr)	2009/12/30	99	80 - 120	100	90 - 110	<5	ug/L				
2046343	Dissolved Cobalt (Co)	2009/12/30	99	80 - 120	99	90 - 110	<0.5	ug/L				
2046343	Dissolved Copper (Cu)	2009/12/30	97	80 - 120	99	90 - 110	<1	ug/L				
2046343	Dissolved Iron (Fe)	2009/12/30	101	80 - 120	101	90 - 110	<100	ug/L				
2046343	Dissolved Lead (Pb)	2009/12/30	98	80 - 120	98	90 - 110	<0.5	ug/L	NC	25		
2046343	Dissolved Magnesium (Mg)	2009/12/30	NC	80 - 120	102	90 - 110	<50	ug/L				
2046343	Dissolved Manganese (Mn)	2009/12/30	NC	80 - 120	102	90 - 110	<2	ug/L				
2046343	Dissolved Molybdenum (Mo)	2009/12/30	106	80 - 120	101	90 - 110	<1	ug/L				
2046343	Dissolved Nickel (Ni)	2009/12/30	99	80 - 120	99	90 - 110	<1	ug/L				
2046343	Dissolved Phosphorus (P)	2009/12/30	109	80 - 120	110	90 - 110	<100	ug/L				
2046343	Dissolved Potassium (K)	2009/12/30	99	80 - 120	102	90 - 110	<200	ug/L				
2046343	Dissolved Selenium (Se)	2009/12/30	109	80 - 120	101	90 - 110	<2	ug/L				
2046343	Dissolved Silicon (Si)	2009/12/30	97	80 - 120	102	90 - 110	<50	ug/L				
2046343	Dissolved Silver (Ag)	2009/12/30	75 _(L)	80 - 120	99	90 - 110	<0.1	ug/L				
2046343	Dissolved Sodium (Na)	2009/12/30	NC	80 - 120	101	90 - 110	<100	ug/L				
2046343	Dissolved Strontium (Sr)	2009/12/30	NC	80 - 120	100	90 - 110	<1	ug/L				
2046343	Dissolved Thallium (Tl)	2009/12/30	97	80 - 120	97	90 - 110	<0.05	ug/L				
2046343	Dissolved Titanium (Ti)	2009/12/30	103	80 - 120	102	90 - 110	<5	ug/L				
2046343	Dissolved Uranium (U)	2009/12/30	103	80 - 120	98	90 - 110	<0.1	ug/L				
2046343	Dissolved Vanadium (V)	2009/12/30	100	80 - 120	101	90 - 110	<1	ug/L				

Maxxam Job #: A9H2842
Report Date: 2009/12/31

Golder Associates Ltd
Client Project #: 08-1112-0021
Project name: CITY OF GUELPH
Sampler Initials: JH

QUALITY ASSURANCE REPORT

QC Batch	Parameter	Date	Matrix Spike		Spiked Blank		Method Blank		RPD		QC Standard	
			% Recovery	QC Limits	% Recovery	QC Limits	Value	Units	Value (%)	QC Limits	% Recovery	QC Limits
2046343	Dissolved Zinc (Zn)	2009/12/30	101	80 - 120	102	90 - 110	<5	ug/L				
2046476	Dissolved Organic Carbon	2009/12/30	109	75 - 125	107	75 - 125	<0.2	mg/L	NC	20		

N/A = Not Applicable

RPD = Relative Percent Difference

Duplicate: Paired analysis of a separate portion of the same sample. Used to evaluate the variance in the measurement.

Matrix Spike: A sample to which a known amount of the analyte of interest has been added. Used to evaluate sample matrix interference.

QC Standard: A blank matrix to which a known amount of the analyte has been added. Used to evaluate analyte recovery.

Spiked Blank: A blank matrix to which a known amount of the analyte has been added. Used to evaluate analyte recovery.

Method Blank: A blank matrix containing all reagents used in the analytical procedure. Used to identify laboratory contamination.

NC (Matrix Spike): The recovery in the matrix spike was not calculated. The relative difference between the concentration in the parent sample and the spiked amount was not sufficiently significant to permit a reliable recovery calculation.

NC (RPD): The RPD was not calculated. The level of analyte detected in the parent sample and its duplicate was not sufficiently significant to permit a reliable calculation.

(1) - Recovery or RPD for this parameter is outside control limits. The overall quality control for this analysis meets acceptability criteria.

Validation Signature Page

Maxxam Job #: A9H2842

The analytical data and all QC contained in this report were reviewed and validated by the following individual(s).



CRISTINA CARRIERE, Scientific Services

=====
Maxxam has procedures in place to guard against improper use of the electronic signature and have the required "signatories", as per section 5.10.2 of ISO/IEC 17025:2005(E), signing the reports. SCC and CALA have approved this reporting process and electronic report format.



CITY OF GUELPH TIER THREE ASSESSMENT CHARACTERIZATION FINAL REPORT

C9: Baseflow Monitoring Data

Watercourse	Location ID	pH			Conductivity (mS/cm)			Temperature (°C)		
		07-Jul-08	26-Aug-08	22-Oct-08	07-Jul-08	26-Aug-08	22-Oct-08	07-Jul-08	26-Aug-08	22-Oct-08
Blue Springs Creek	BSC_10	8.00	8.19	8.50	0.73	0.65	0.66	17.1	14.4	8.0
	BSC_20	7.93	7.85	8.07	0.60	0.57	0.58	22.2	17.7	6.6
	BSC_30a	7.73	8.10	8.32	0.74	0.68	0.67	15.2	13.7	6.2
	BSC_30b	N/A	8.15	8.34	N/A	0.66	0.66	N/A	14.0	6.8
Cox Creek	CC_10	7.45	7.51	7.76	0.15	0.72	0.79	19.5	14.5	6.1
	CC_30	7.52	7.60	7.75	0.80	0.84	0.90	18.7	13.9	5.9
Cox Creek South Tributary	CCT_20	7.51	7.53	8.16	0.64	0.68	0.78	19.6	14.2	5.6
Ellis Creek	EC_10	7.56	7.94	7.33	1.10	0.98	1.16	15.6	15.1	5.0
	EC_20	8.29	8.06	7.61	0.70	0.70	0.82	18.2	14.0	6.8
Eramosa River	ER_10	7.41	8.36	8.48	0.63	0.57	0.52	20.2	16.6	7.0
	ER_20	7.87	8.41	8.50	0.70	0.59	0.52	21.8	17.4	6.9
	ER_30	8.53	8.58	8.60	0.63	0.57	0.52	21.8	17.9	6.9
	ER_40	7.73	7.97	8.24	18.30	0.66	0.65	0.7	17.3	6.7
Guelph Lake Tributary	GLT_10	8.45	8.36	8.09	0.67	0.68	0.72	22.0	15.4	5.8
	GLT_20	8.21	8.26	8.52	0.57	0.62	0.63	21.9	17.7	4.5
Hanlon Creek	HC_10	8.60	8.64	N/A	1.00	0.91	1.02	18.5	14.6	7.8
Hanlon Creek South Tributary	HCT_20	Dry	Dry	Dry	Dry	Dry	Dry	Dry	Dry	Dry
Hopewell Creek	HWC_10	8.52	8.46	7.46	0.72	0.77	0.89	25.0	19.0	5.5
	HWC_20	8.86	7.99	7.61	0.64	0.75	0.91	27.0	18.9	6.2
Irish Creek	IC_10	7.55	7.86	6.53	0.66	0.60	0.65	20.0	14.8	7.0
	IC_20	8.27	8.38	7.68	0.69	0.67	0.75	21.0	16.3	6.8
Lutlural Creek	LC_10	8.06	8.40	7.96	0.60	0.60	0.65	23.5	18.0	8.4
Lutlural Creek Tributary	LCT_20	7.48	8.00	7.86	0.57	0.58	0.68	20.4	21.4	7.5
Lutlural Creek	LC_30	8.15	8.23	8.07	0.60	0.57	0.62	23.8	17.7	7.1
Marden Creek	MDC_10	8.60	8.76	7.82	0.62	0.63	0.82	20.2	14.0	5.5
Mill Creek	MC_10	8.22	8.39	n/a ²	0.50	0.46	0.57	21.0	16.7	8.6
	MC_20	8.15	8.56	7.61	0.65	0.65	0.75	22.5	13.7	7.3
Swan Creek	SC_10	7.83	7.82	7.86	0.68	0.67	0.79	18.3	14.4	5.5
Speed River	SR_10	8.18	8.27	8.13	0.50	0.48	0.52	22.7	17.0	6.1
	SR_20	8.12	8.24	8.00	0.50	0.49	0.55	23.6	18.0	7.7
	SR_30	8.22	8.37	8.14	0.50	0.50	0.57	23.3	18.0	6.5
	SR_40	8.03	8.10	8.04	0.51	0.50	0.59	23.5	17.4	5.8
Torrance Creek	TC_10	7.61	8.03	8.23	0.85	---	0.78	16.4	14.0	4.4